REV	DESCRIPTION	BY	DATE	–	----	--	--/--/--	–	----	--	--/--/--
–	----	--	--/--/--	–	----	--	--/--/--	–	----	--	--/--/--

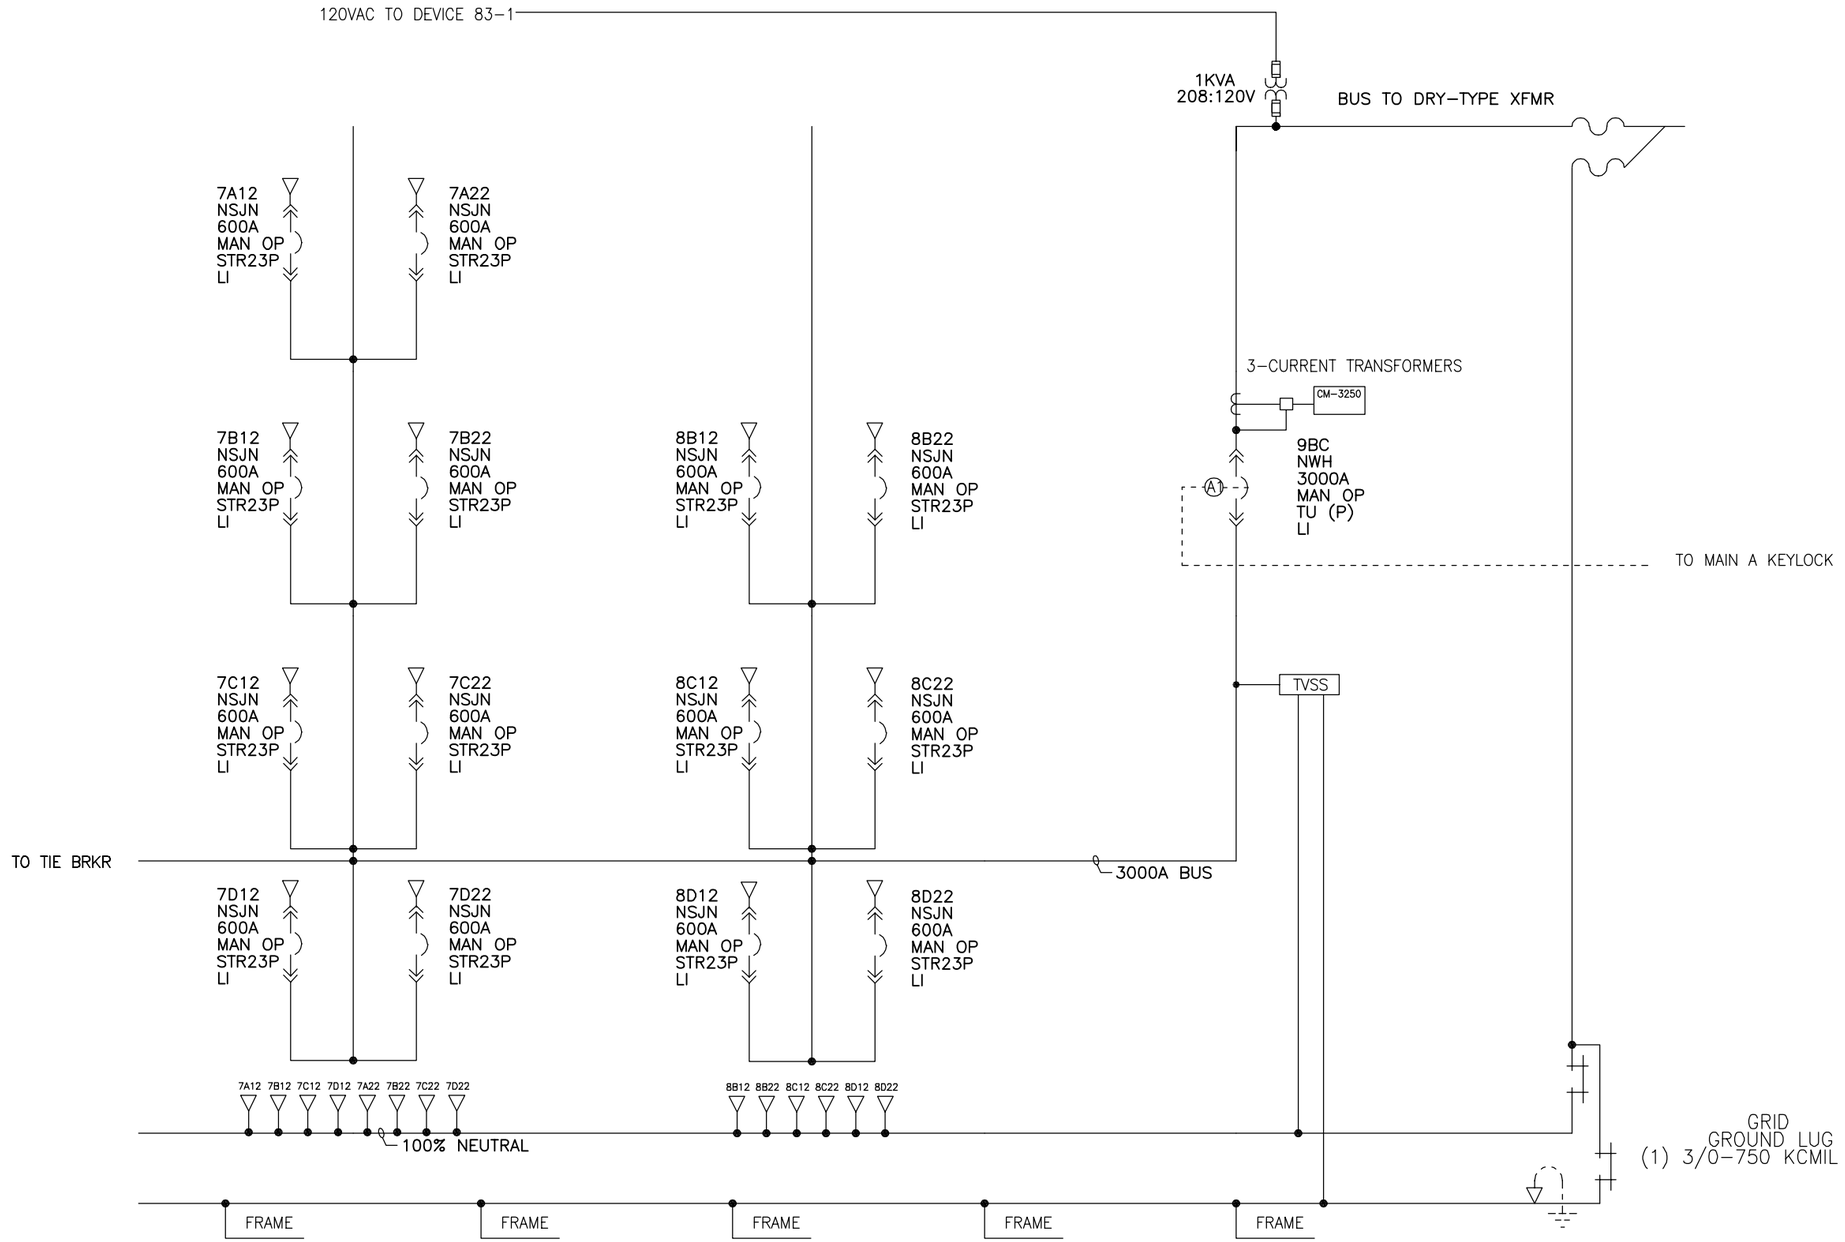

ONE LINE DRAWING

JOB NAME:	V.A. MEDICAL CENTER	EQUIPMENT DESIGNATION:	**208V SUBSTATION**
JOB LOCATION:	ST. LOUIS, MO.	EQUIPMENT TYPE:	QED6 SWITCHBOARD
DRAWN BY:	LES	DRAWING TYPE:	ONE LINE
ENGR:	LARRY E. SCHARFENBERGER		SQUARE D Schneider Electric
DATE:	DECEMBER 07, 2004		
DRAWING STATUS:	RECORD	DWG# **019250025-002-01**	PG **2** OF **4** REV –