REV	DESCRIPTION	BY	DATE	–	----	--	--/--/--	–	----	--	--/--/--
–	----	--	--/--/--	–	----	--	--/--/--	–	----	--	--/--/--

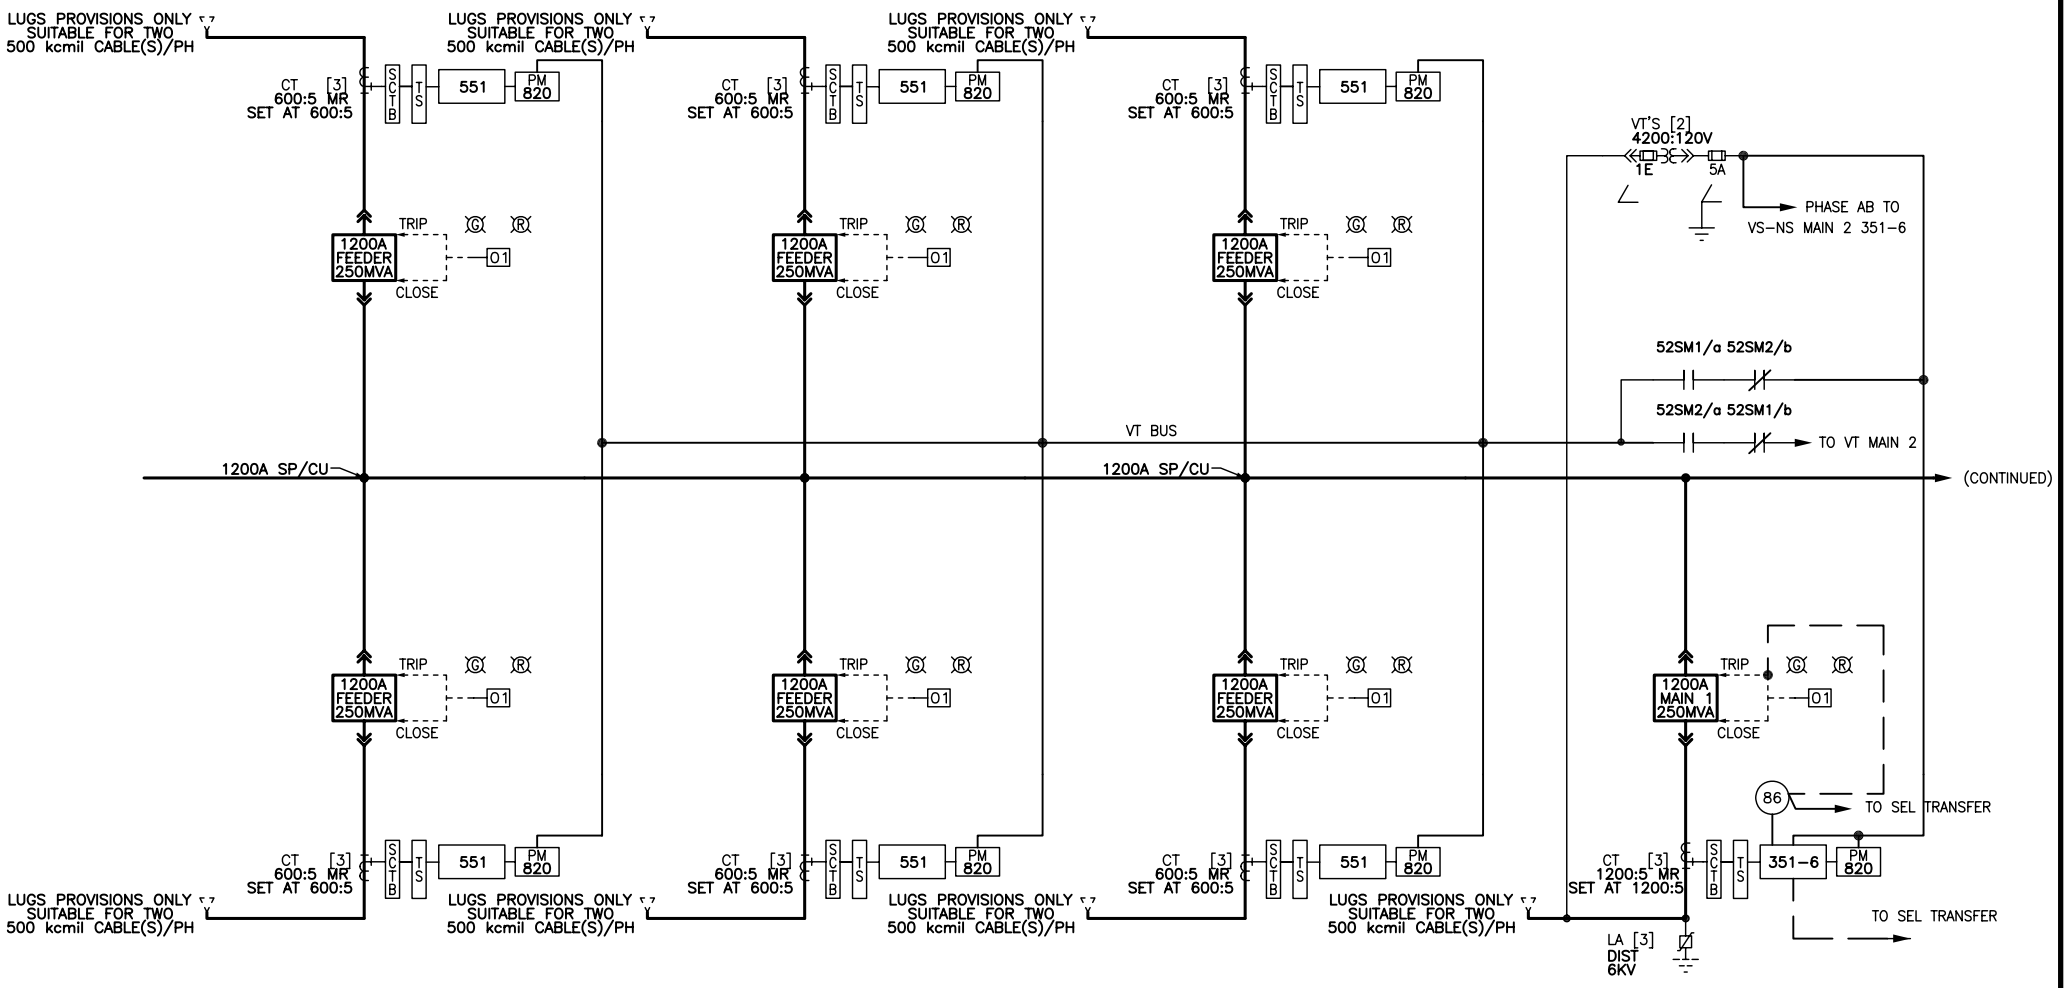

SECT 1 SECT 2 SECT 3 SECT 4

JOB NAME:	VA COCHRAN – 5 KV ROOM A20
JOB LOCATION:	ST LOUIS, MO
DRAWN BY:	CAD
ENGR:	C.COOPER
DATE:	JUN 3, 2004
DRAWING STATUS:	RECORD

EQUIPMENT DESIGNATION:	**INDOOR MCLD**
EQUIPMENT TYPE:	MASTERCLAD SWITCHGEAR
DRAWING TYPE:	ONE LINE DIAGRAM

SQUARE D Schneider Electric

DWG# **018619646-002-01** PG 1 OF 2 REV –