REV	DESCRIPTION	BY	DATE	–	----	--	--/--/--	–	----	--	--/--/--
–	----	--	--/--/--	–	----	--	--/--/--	–	----	--	--/--/--

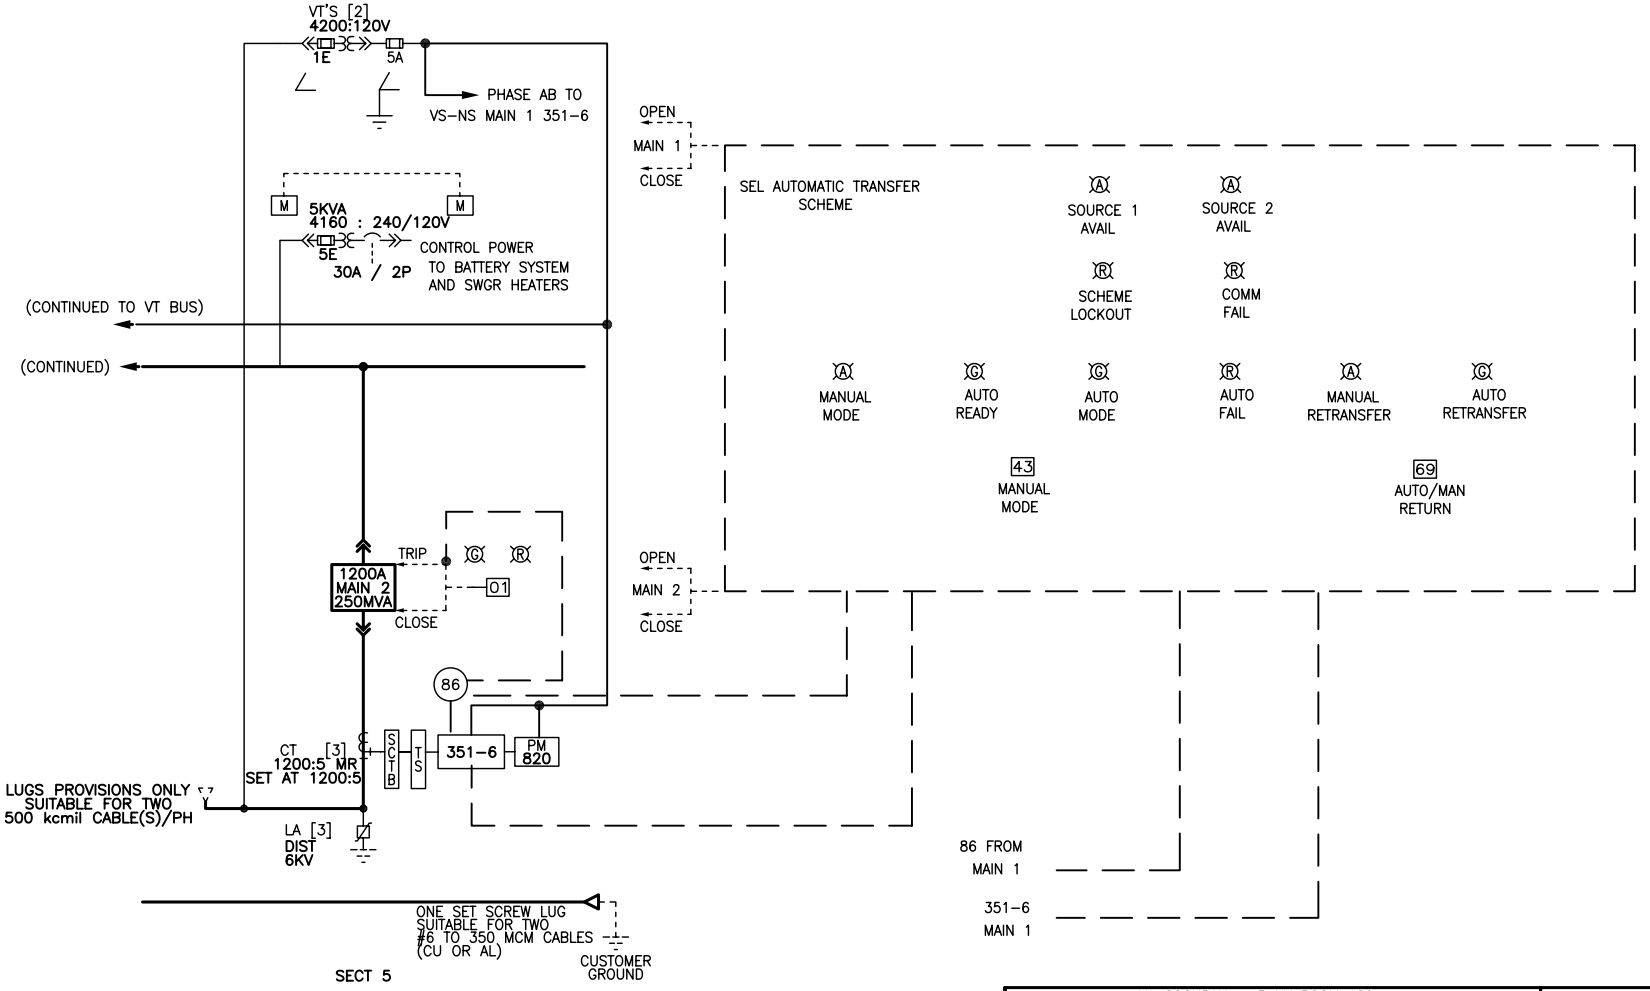

JOB NAME:	VA COCHRAN – 5 KV ROOM A20	EQUIPMENT DESIGNATION:	INDOOR MCLD
JOB LOCATION:	ST LOUIS, MO	EQUIPMENT TYPE:	MASTERCLAD SWITCHGEAR
DRAWN BY:	CAD	DRAWING TYPE:	ONE LINE DIAGRAM
ENGR:	C. COOPER		SQUARE D Schneider Electric
DATE:	JUN 3, 2004		
DRAWING STATUS:	RECORD	DWG# 018619646-002-01	PG 2 OF 2 REV –