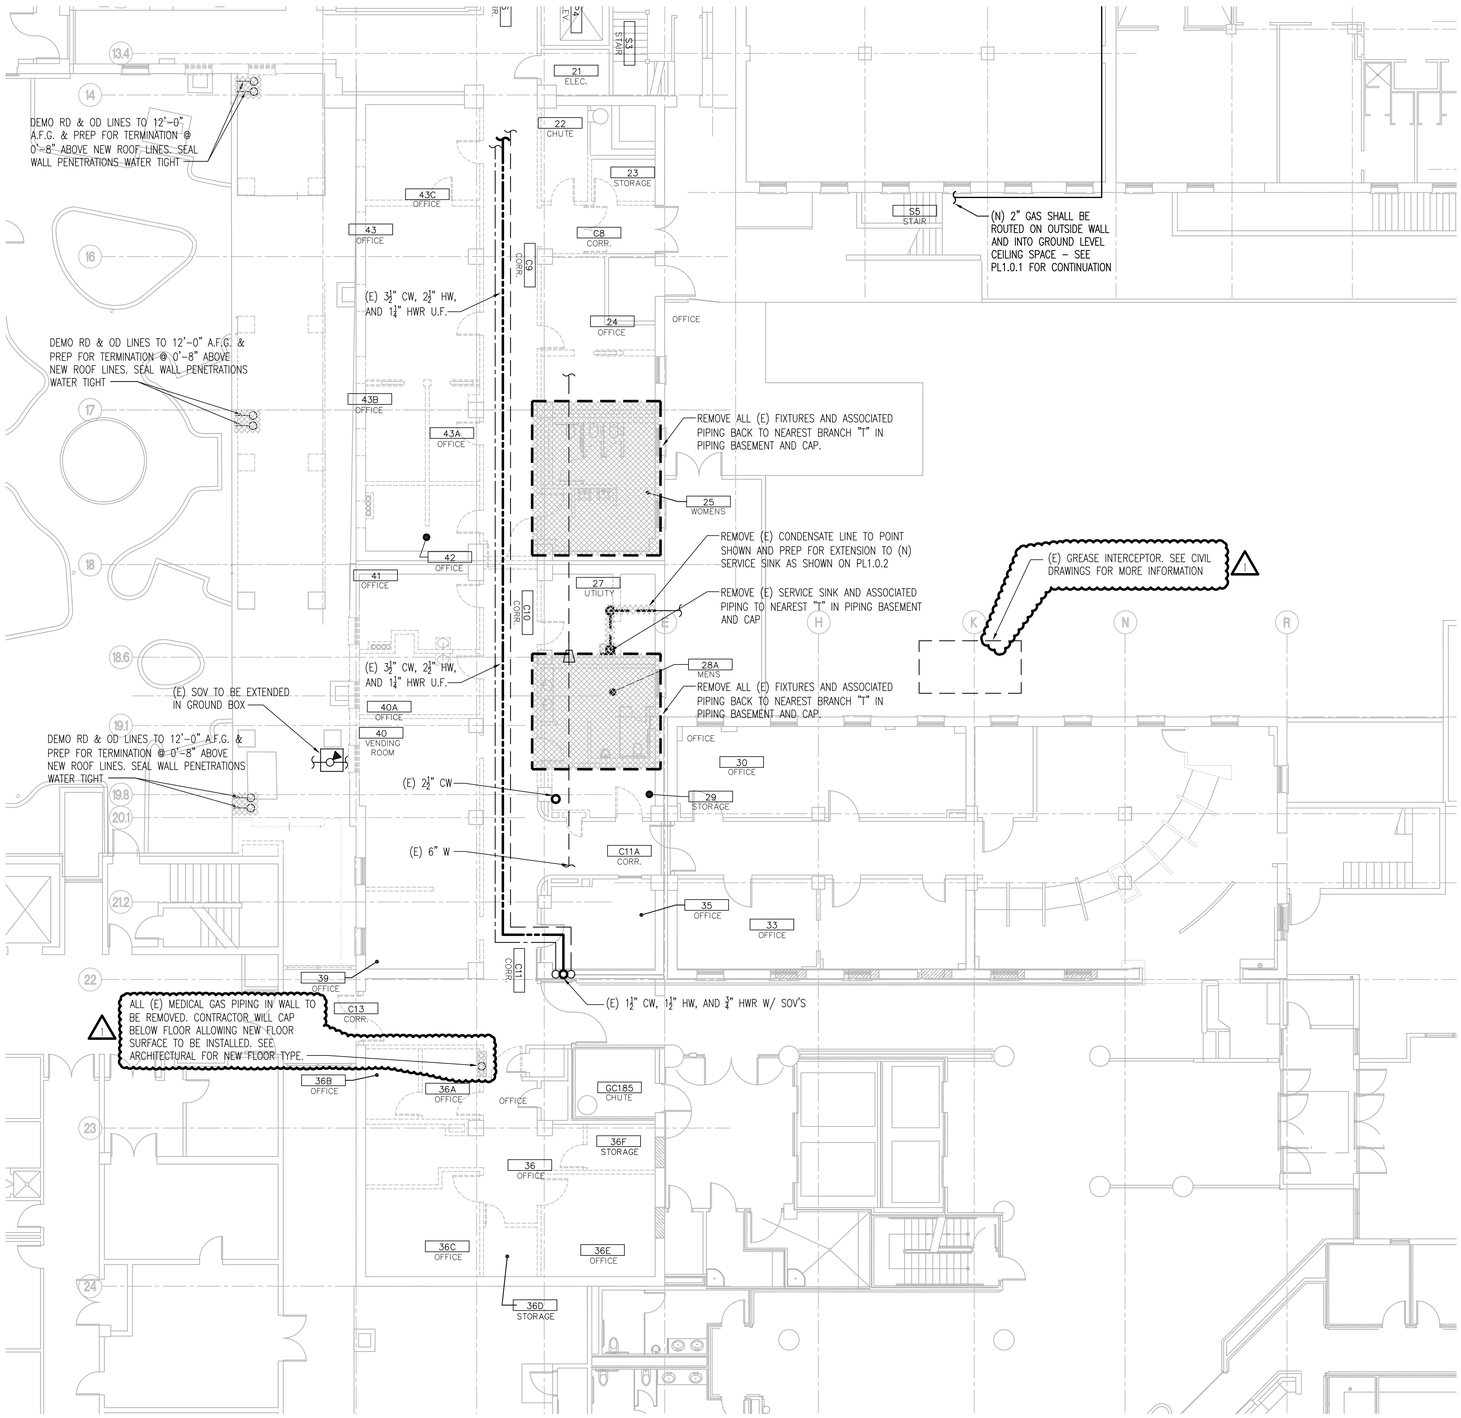

PLUMBING DEMOLIITON PLAN - GROUND FLOOR
AREA 1-5

A / PD1.0.1 SCALE: 1/8" = 1'0"

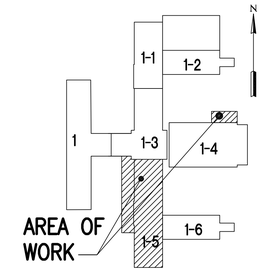

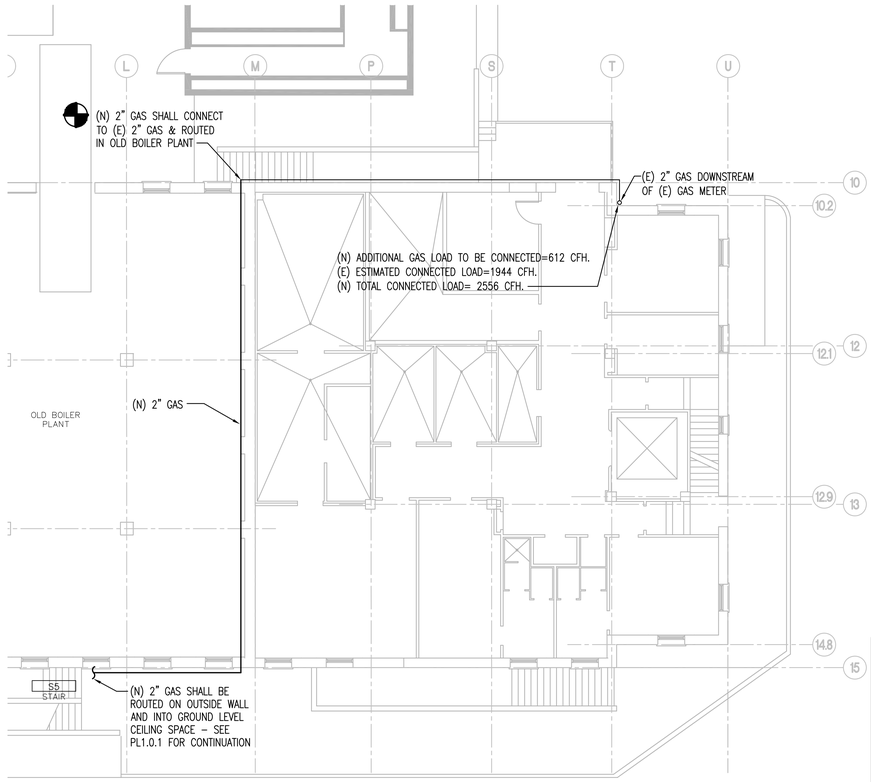

PLUMBING GAS METER LOCATION - GROUND FLOOR
AREA 1-5

B / PD1.0.1 SCALE: 1/8" = 1'0"

FULLY SPRINKLERED

⚠ ADDENDUM 2	5-24-12
Revisions:	Date

CONSULTANTS:

DINTER ENGINEERING CONFIDENCE
Airfield Electrical Mechanical
385 Gentry Way
Reno, NV 89502
Ph: 775.826.4044
Fax: 775.826.4190
www.dinter.com J-4217.6

REGISTERED PROFESSIONAL ENGINEER - STATE OF NEVADA
THOMAS P. FEDERICI
Exp. 6/30/13
No. 4926

ARCHITECT/ENGINEERS:

vern martin design associates
(a Nevada Corporation)
Food Facilities Design
760 Robin St., Reno, Nevada 89509
P:(775) 240-2637 F:(775) 201-0066
E:vern@martinreno.com

VanWoert Bigotti architects
1400 s. virginia st suite c
reno, nevada 89502
p:775.328.1010
f: 775.328.1020
info@vwbarchitects.com

Drawing Title	PLUMBING DEMOLITION PLAN
Approved Project Director	
Project Title	VA SIERRA NEVADA HEALTH CARE SYSTEM - CANTEEN RELOCATION DESIGN - , RENO, NEVADA
Location	975 KIRMAN AVE, RENO, NEVADA 89502
Date	25 JAN, 2012
Checked	TPF
Drawn	EBW
Project Number	654-11-227
Building Number	1
Drawing Number	PD1.0.1
Dwg. – of –	

Office of Construction and Facilities Management
Department of Veterans Affairs

VA FORM 08-6231