

construction and materials shall comply
with 2006 international building code
(ibc).
the design and drawings contained
herein are protected under n.r.s. 623
and usc copyright title 17.
unauthorized duplication or distribution
is a violation of state and federal law.

drawn: Author
checked: Checker

VA SIERRA NEVADA HEALTH CARE SYSTEM -
CANTEEN RELOCATION DESIGN - RENO, NEVADA
975 KIRMAN AVE., RENO, NEVADA 89502


drawing title:
Modify 1-AE1.1,
Ground Floor
Patterns

job number:
654-11-227

date:
05/24/12

clarification drawing number:

CL-2

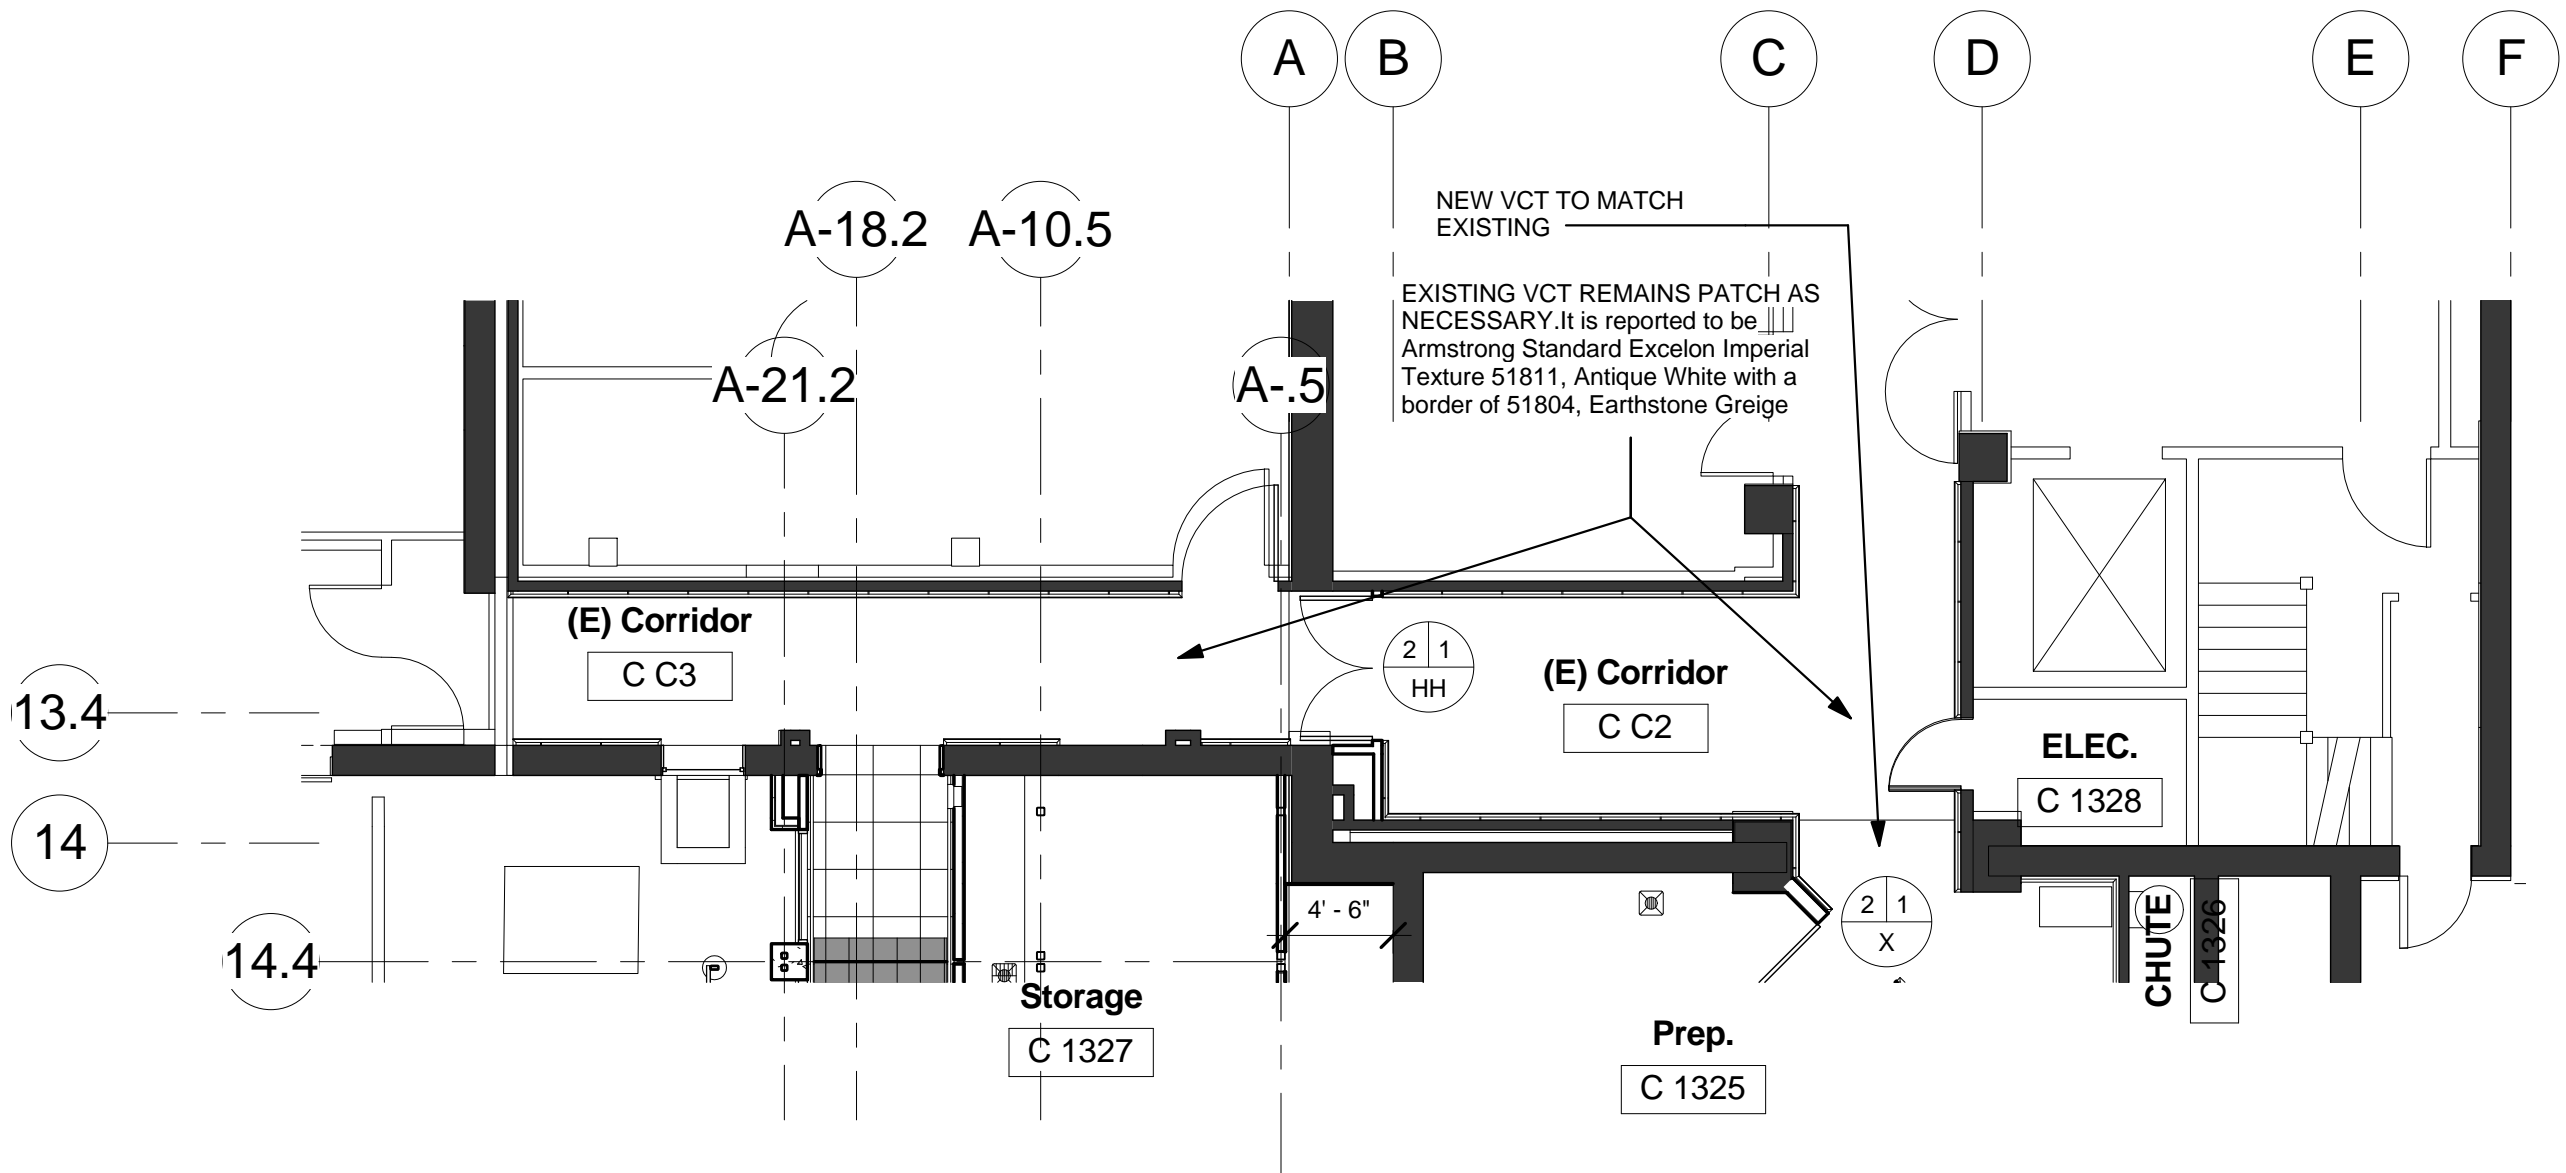

1 Revised Ground Floor-TILE PATTERN
1/8" = 1'-0"