

"B" WING - N.I.C.

"A" WING

NOTE: BID ALTERNATE THE P2A LAVATORY LOCATED IN THE PATIENT ROOMS ARE TO BE DELETED INCLUDING HOT AND COLD WATER FROM FIXTURE TO MAIN ABOVE THE CEILING.

PLUMBING DOMESTIC WATER - NEW WORK - "A" WING


SCALE: 1/8"=1'-0"

NEW WORK NOTE THIS DRAWING

- 1 WATER LINE VALVED AND CAPPED FOR FUTURE CONNECTION ON 6TH FLOOR RENOVATION
- 2 VALVE AND CAP 1/4" COLD WATER AND 3/4" HOT WATER FOR FUTURE

WORK NOTE:

ALL FIXTURES ON THE 5TH FLOOR TO BE CONNECTED TO NEW PIPING SYSTEM. THE EXISTING 6TH FLOOR FIXTURES ARE TO BE CONNECTED TO NEW PIPING SYSTEM. THE EXISTING 6TH FLOOR FIXTURES ARE TO BE DISCONNECTED AND SKIPPED TO THE NEW SYSTEM AT ANY TIME COORDINATE CHANGE OVER WITH OWNER.

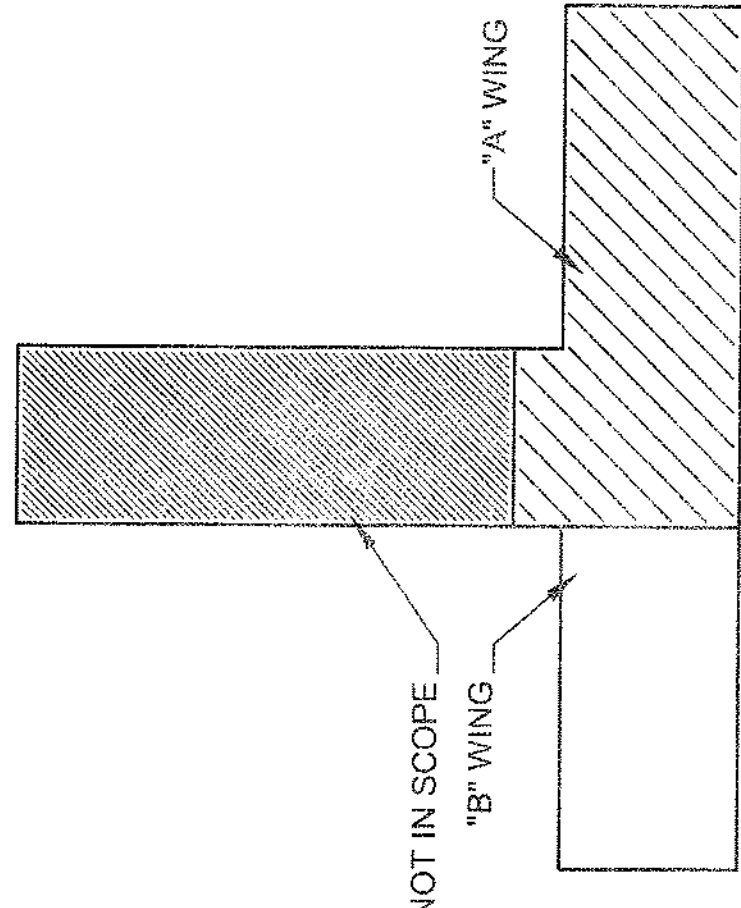

KEY PLAN

Note: Drawing Revised To Report Size of water main piping only

100% CONSTRUCTION DOCUMENTS - FOR CONSTRUCTION

CONSULTANTS:

Nelson-Tremain Partnership
125 Southeast Main Street, Suite 245
Minneapolis, MN 55414
Phone 612.331.6200
Fax 612.331.6205

ARCHITECT/ENGINEERS:

S3E KINGSTON
8000 Reservoir Rd., Suite 200
Springfield, VA 22151
Phone 703.538.0100
Fax 703.538.0306

HUELAT PARRUCHIA HEALING DESIGN
655 South Feller St.
Springfield, VA 22151
Phone 703.538.0144
Fax 703.538.0173
www.healingdesign.com

Drawing Title

PLUMBING DOMESTIC WATER -
NEW WORK - "A" WING

Project Title

COMMUNITY LIVING CENTER (CLC)
CULTURAL TRANSFORMATION PHASE 2

Project Number

613-09-0201

Building Number

500

Drawing Number

SK-1

Location

MARTINSBURG, WEST VIRGINIA

Date

5/24/12

Checked

Drawn

Office of
Construction
and Facilities Management

Department of
Veterans Affairs

SSBK 10131.0