





VETERANS ADMINISTRATION MEDICAL CENTER
222 RICHMOND AVENUE
BATAVIA, NEW YORK 14020

DWG 2-1

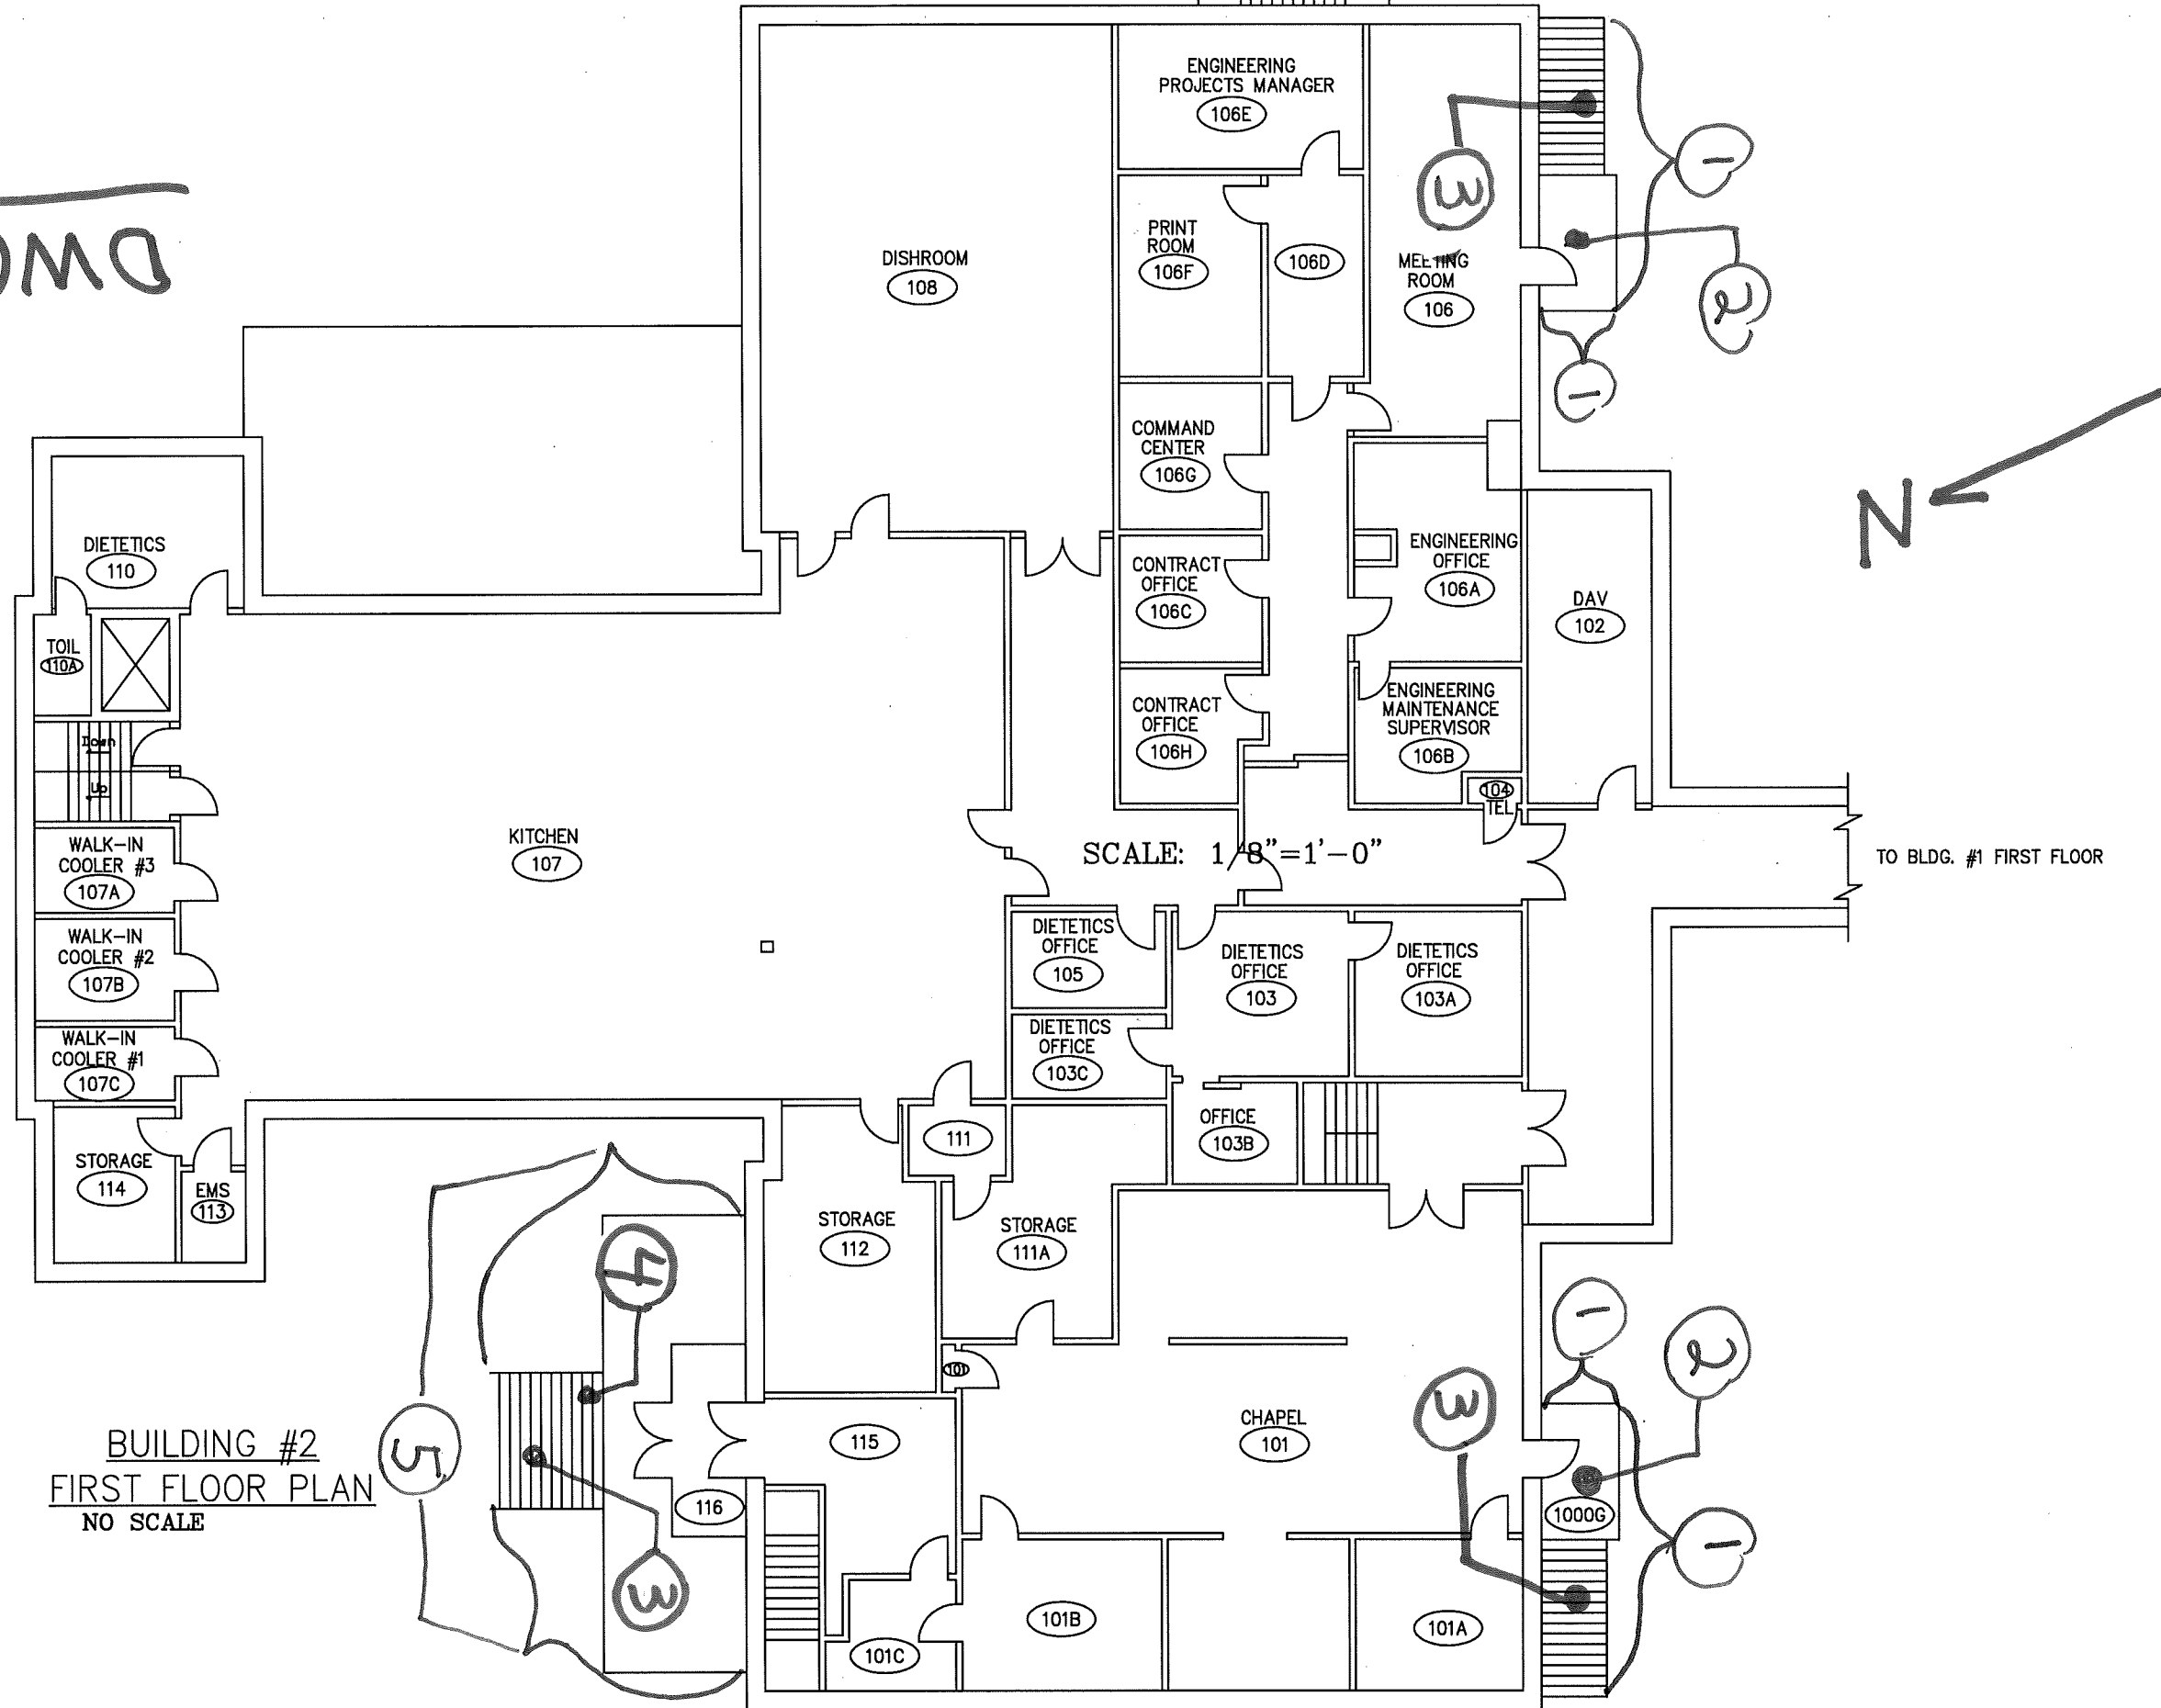

BUILDING #2
FIRST FLOOR PLAN
NO SCALE

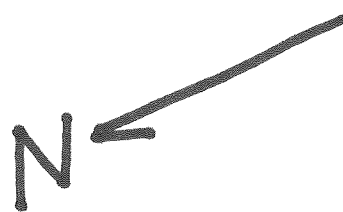

TO BLDG. #1 FIRST FLOOR

SCALE: 1/8" = 1'-0"