


UNDERFLOOR PLUMBING
SECOND FLOOR

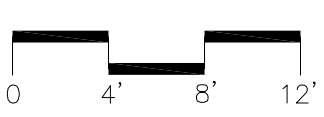


CONTRACTOR EXISTING UTILITIES NOTE:
CONTRACTOR IS TO ALLOCATE MONEY IN THE FINAL PRICE AS REQUIRED TOWARD THE RE-WORKING OF EXISTING UTILITIES AND INSTALLATION OF NEW UTILITIES COMING IN AND GOING OUT OF ALL EXISTING CHASES AND COORDINATE RE-WORKING AND INSTALLATION OF UTILITIES WITH OTHER TRADES.

- KEY NOTES**
- 1. CONNECT NEW 3" WASTE LINE TO EXISTING. FIELD VERIFY EXACT CONNECTION POINT.
 - 2. CONNECT NEW 3" WASTE LINE TO EXISTING 5" WASTE STACK. FIELD VERIFY EXACT CONNECTION POINT.
 - 3. CONNECT NEW 3" WASTE LINE TO EXISTING 4" WASTE STACK. FIELD VERIFY EXACT CONNECTION POINT.
 - 4. NOT USED
 - 5. CONNECT NEW 3" WASTE LINE TO EXISTING WASTE LINE SERVING PUBLIC TOILETS ABOVE.
 - 6. CONNECT NEW 5" RWL TO EXISTING 5" RWL.
- ** APPLIES TO THIS SHEET ONLY ****


GENERAL NOTE:
ALL WORK SHOWN ON THIS SHEET OCCURS IN THE CEILING OF THE SECOND FLOOR. WORK SHALL BE COORDINATED WITH OWNER FOR ACCESS AND INTERRUPTION OF OPERATION OF SECOND FLOOR. ALL WORK SHALL BE PLANNED TO BE PERFORMED AFTER NORMAL OPERATING HOURS.

FULLY SPRINKLERED


Revisions	Date
1. AMENDMENT #4	5/24/12




Tennessee Valley Healthcare System
MURFREESBORO CAMPUS

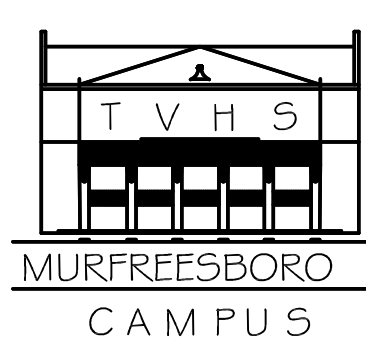

Tennessee Valley Healthcare System
MURFREESBORO CAMPUS

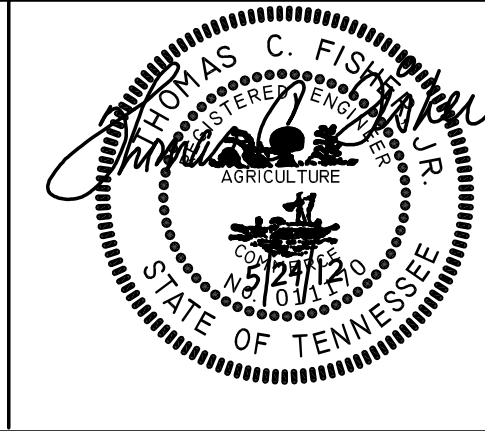

PHOENIX DESIGN GROUP
104 Woodmont Blvd. #218
Nashville, TN 37205

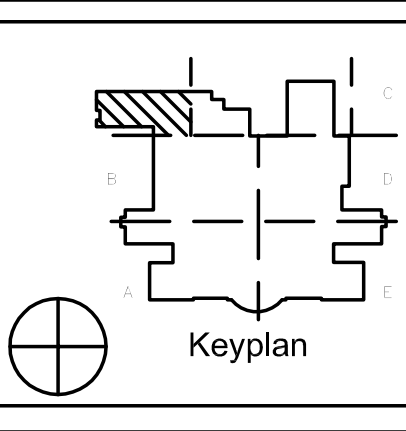

Project Title	VA Renovation Research Lab Phase 3
Drawing Title	OVERALL PLAN- THIRD FLOOR - UNDERFLOOR PLUMBING
Approved By	
Location	NASHVILLE, TN
Building Number	
Floor	
Checked By	RSM
Drawn By	BDA

Date	3-5-2012
Project No.	626-11-101
Drawing No.	1-PL2.02-357
Drawn	62
Of	92

Department of
Veterans Affairs