



# VA Southern Nevada Healthcare System

- Service Department**
- - Dental Clinic
  - - Dermatology Clinic
  - - Nursing Service-Telehealth
  - - Privacy Officer
  - - Social Worker
  - - Medicine Service
  - - Home & Community Programs
  - - Audiology/Speech Pathology Clinic
  - - Rheumatology/Neurology Clinic
  - - Gastroenterology/ Endocrinology Clinic
  - - Primary Care Clinic
  - - Health Administration Service
  - - Fiscal Service
  - - Research
  - - Laboratory
  - - Sterile Processing Service
  - - Mental Health Inpatient Ward (2E)
  - - Speciality Offices
  - - Common Space/ Circulation Space
  - - Electrical/ IT/ Mechanical Areas
  - - Environmental Management Service
  - - Restrooms

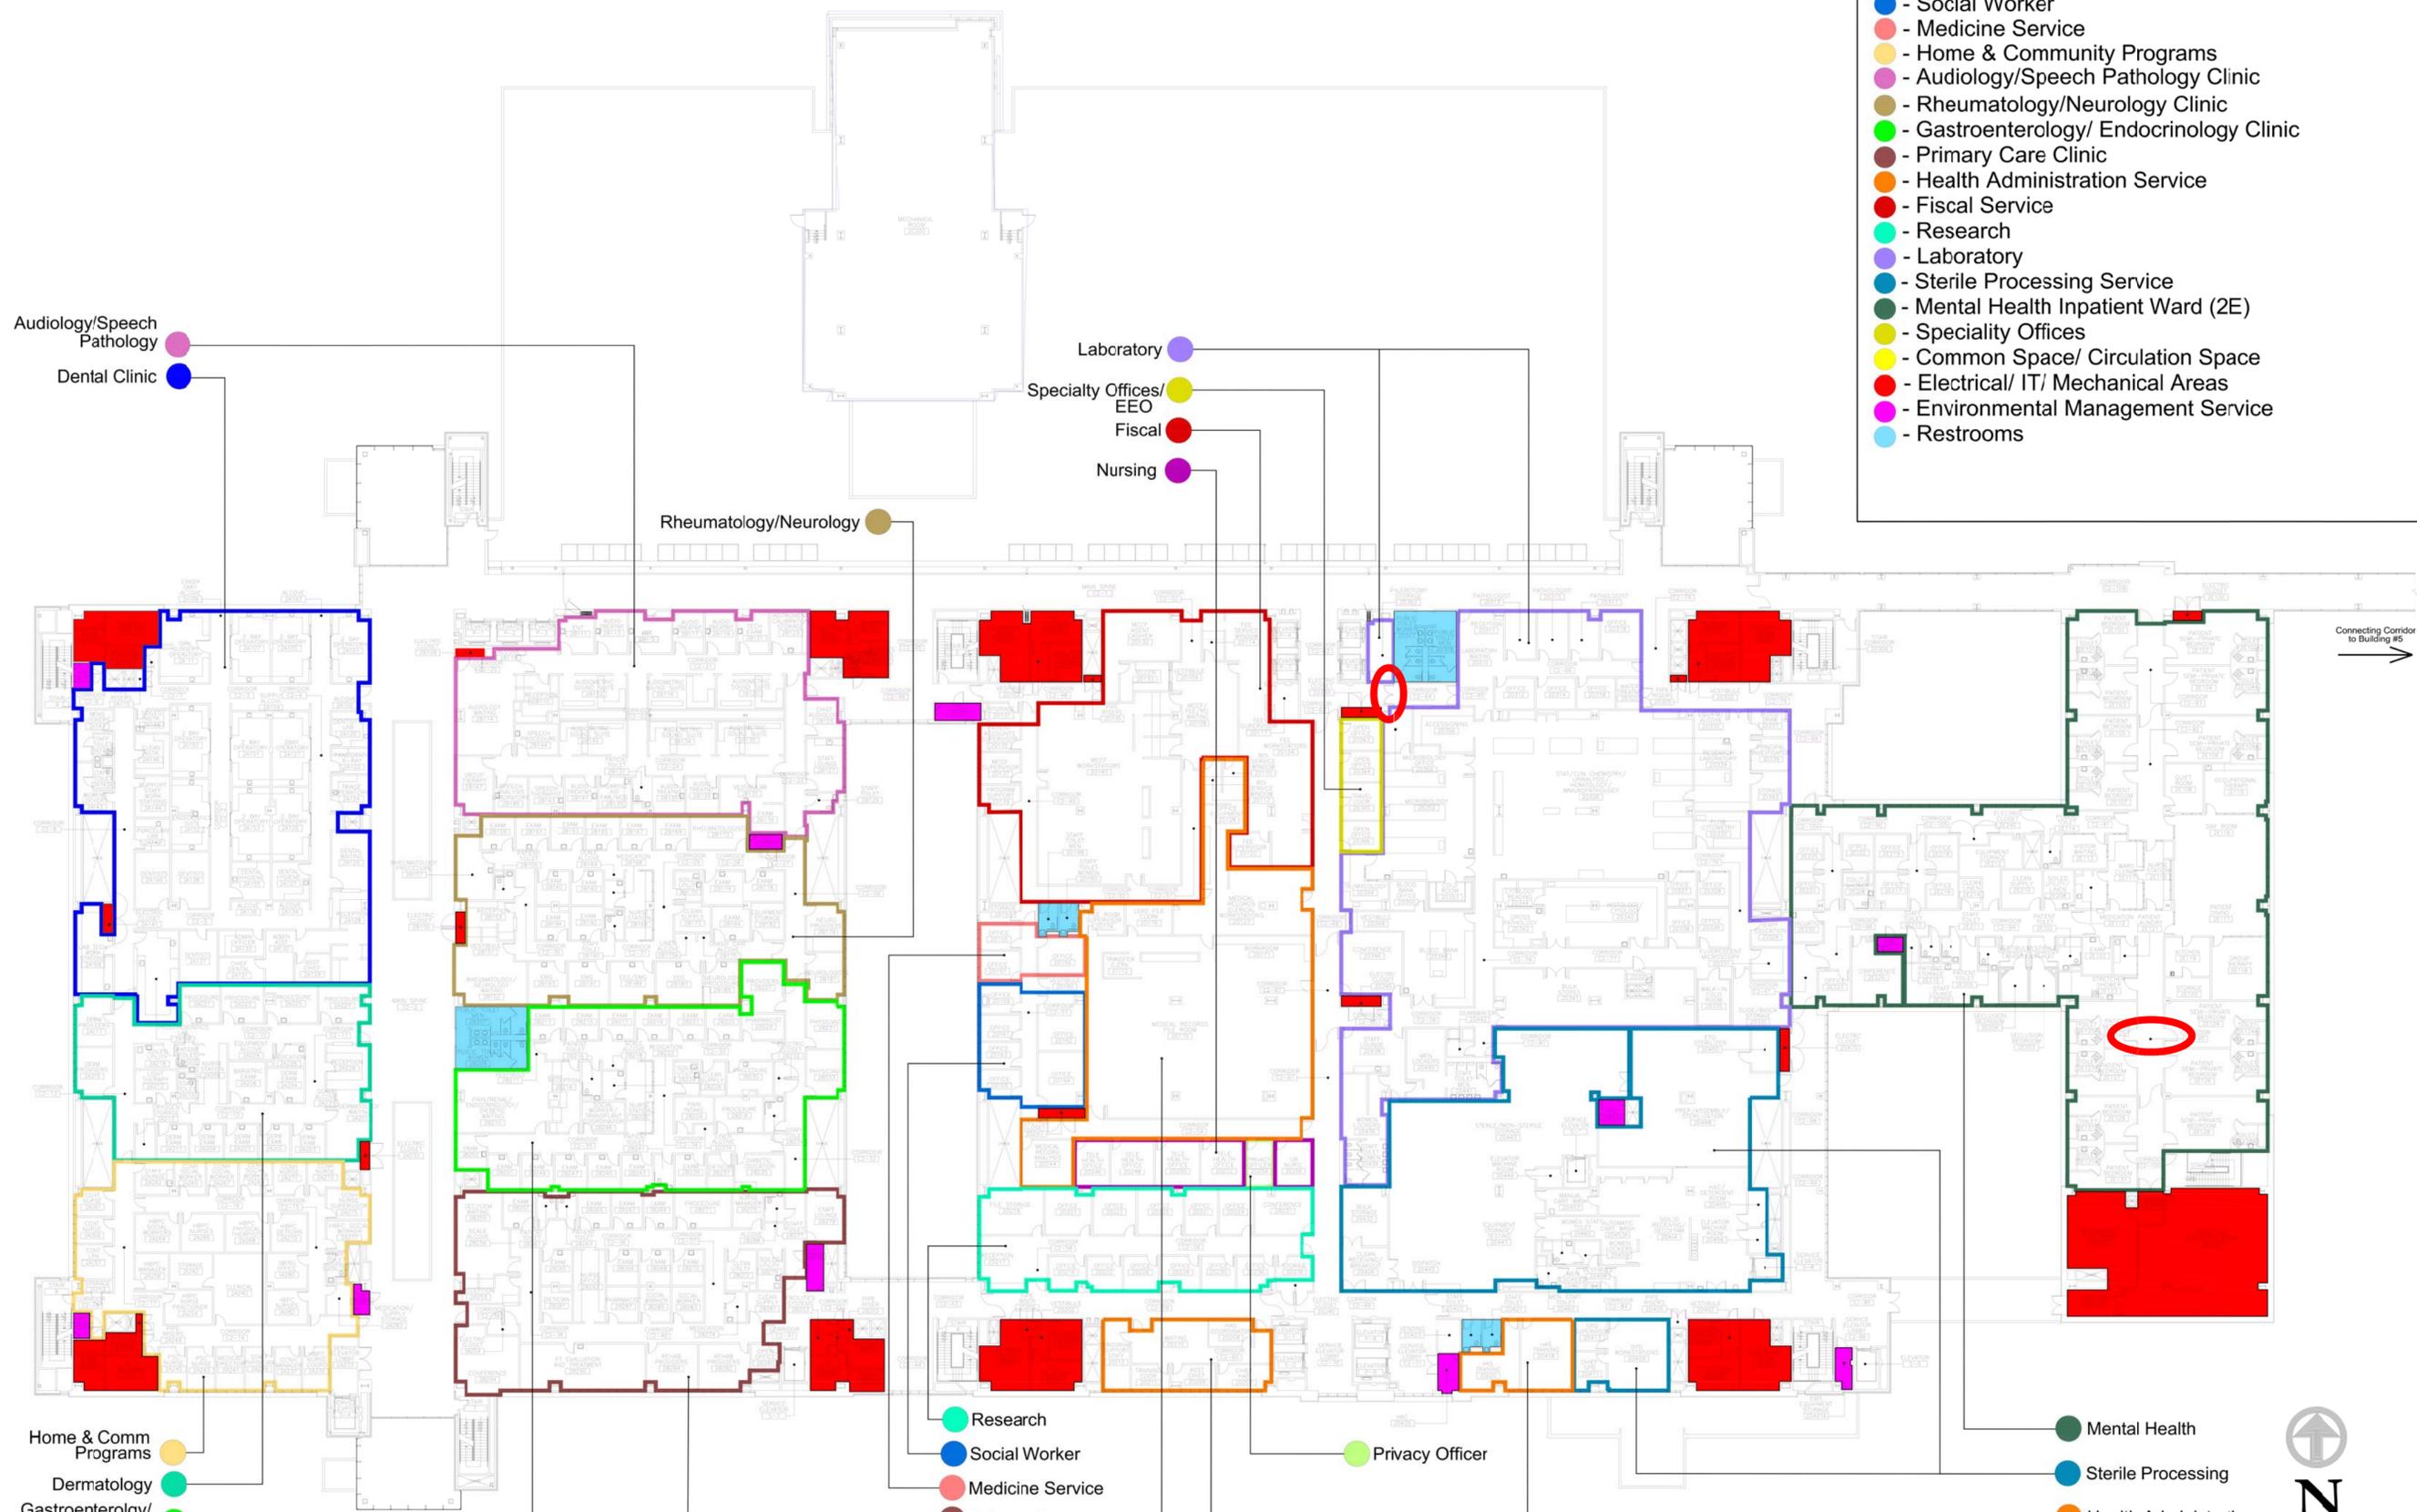

**Building 1 - 2nd Floor**

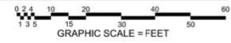





# VA Southern Nevada Healthcare System

## Service Department

- - Physical Medicine and Rehab Service
- - Pain Medicine Service
- - Vacant Space
- - Common Space/ Circulation Space
- - Electrical/ IT/ Mechanical Areas
- - Environmental Management Service
- - Restrooms, Staff Lounge

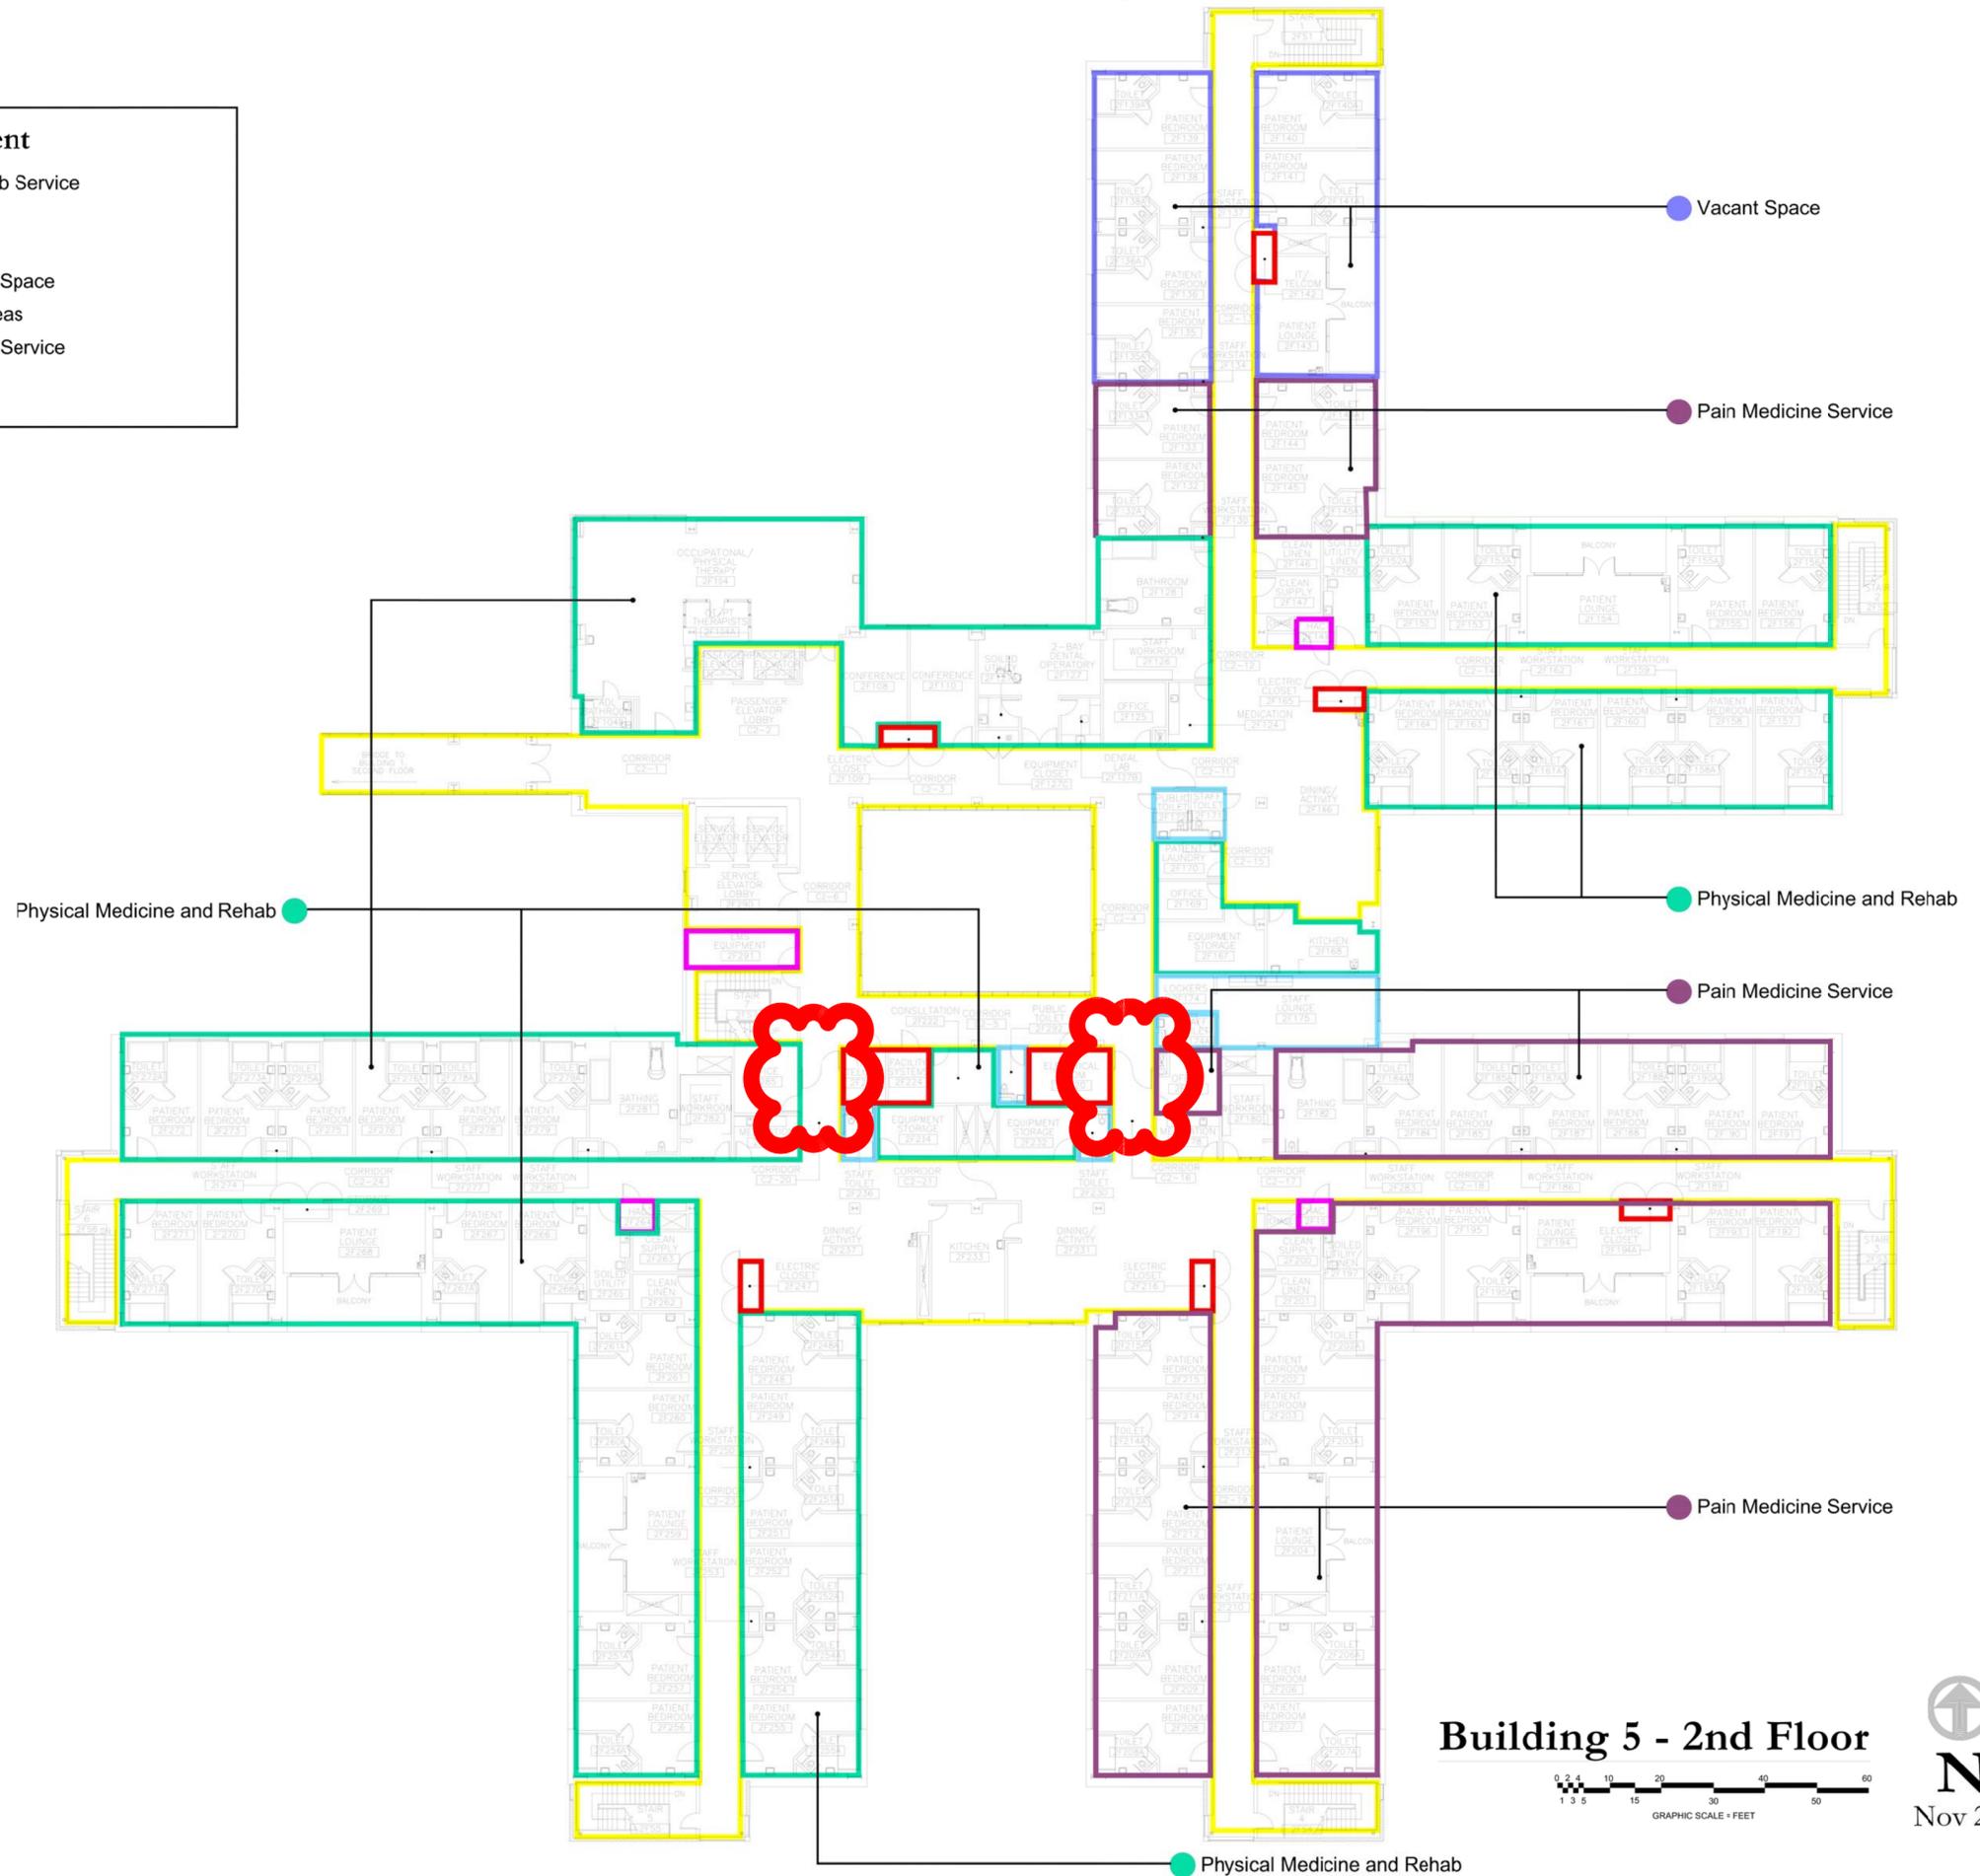

Building 5 - 2nd Floor

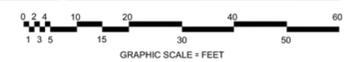

Nov 2016


# VA Southern Nevada Healthcare System

## Bldg 6 - Service Department

- - Fiscal/CBO
- - Human Resources Service
- - Union/AFGE
- - Police/Security
- - Engineering
- - Employee Wellness
- - Vacant Space
- - Common Space/ Circulation Space
- - Electrical/ IT/ Mechanical Areas
- - Environmental Management Service
- - Restrooms

## Bldg 7 - Service Department

- - Canteen Service
- - Education Service
- - Common Space/ Circulation Space
- - Electrical/ IT/ Mechanical Areas
- - Environmental Management Service
- - Restrooms

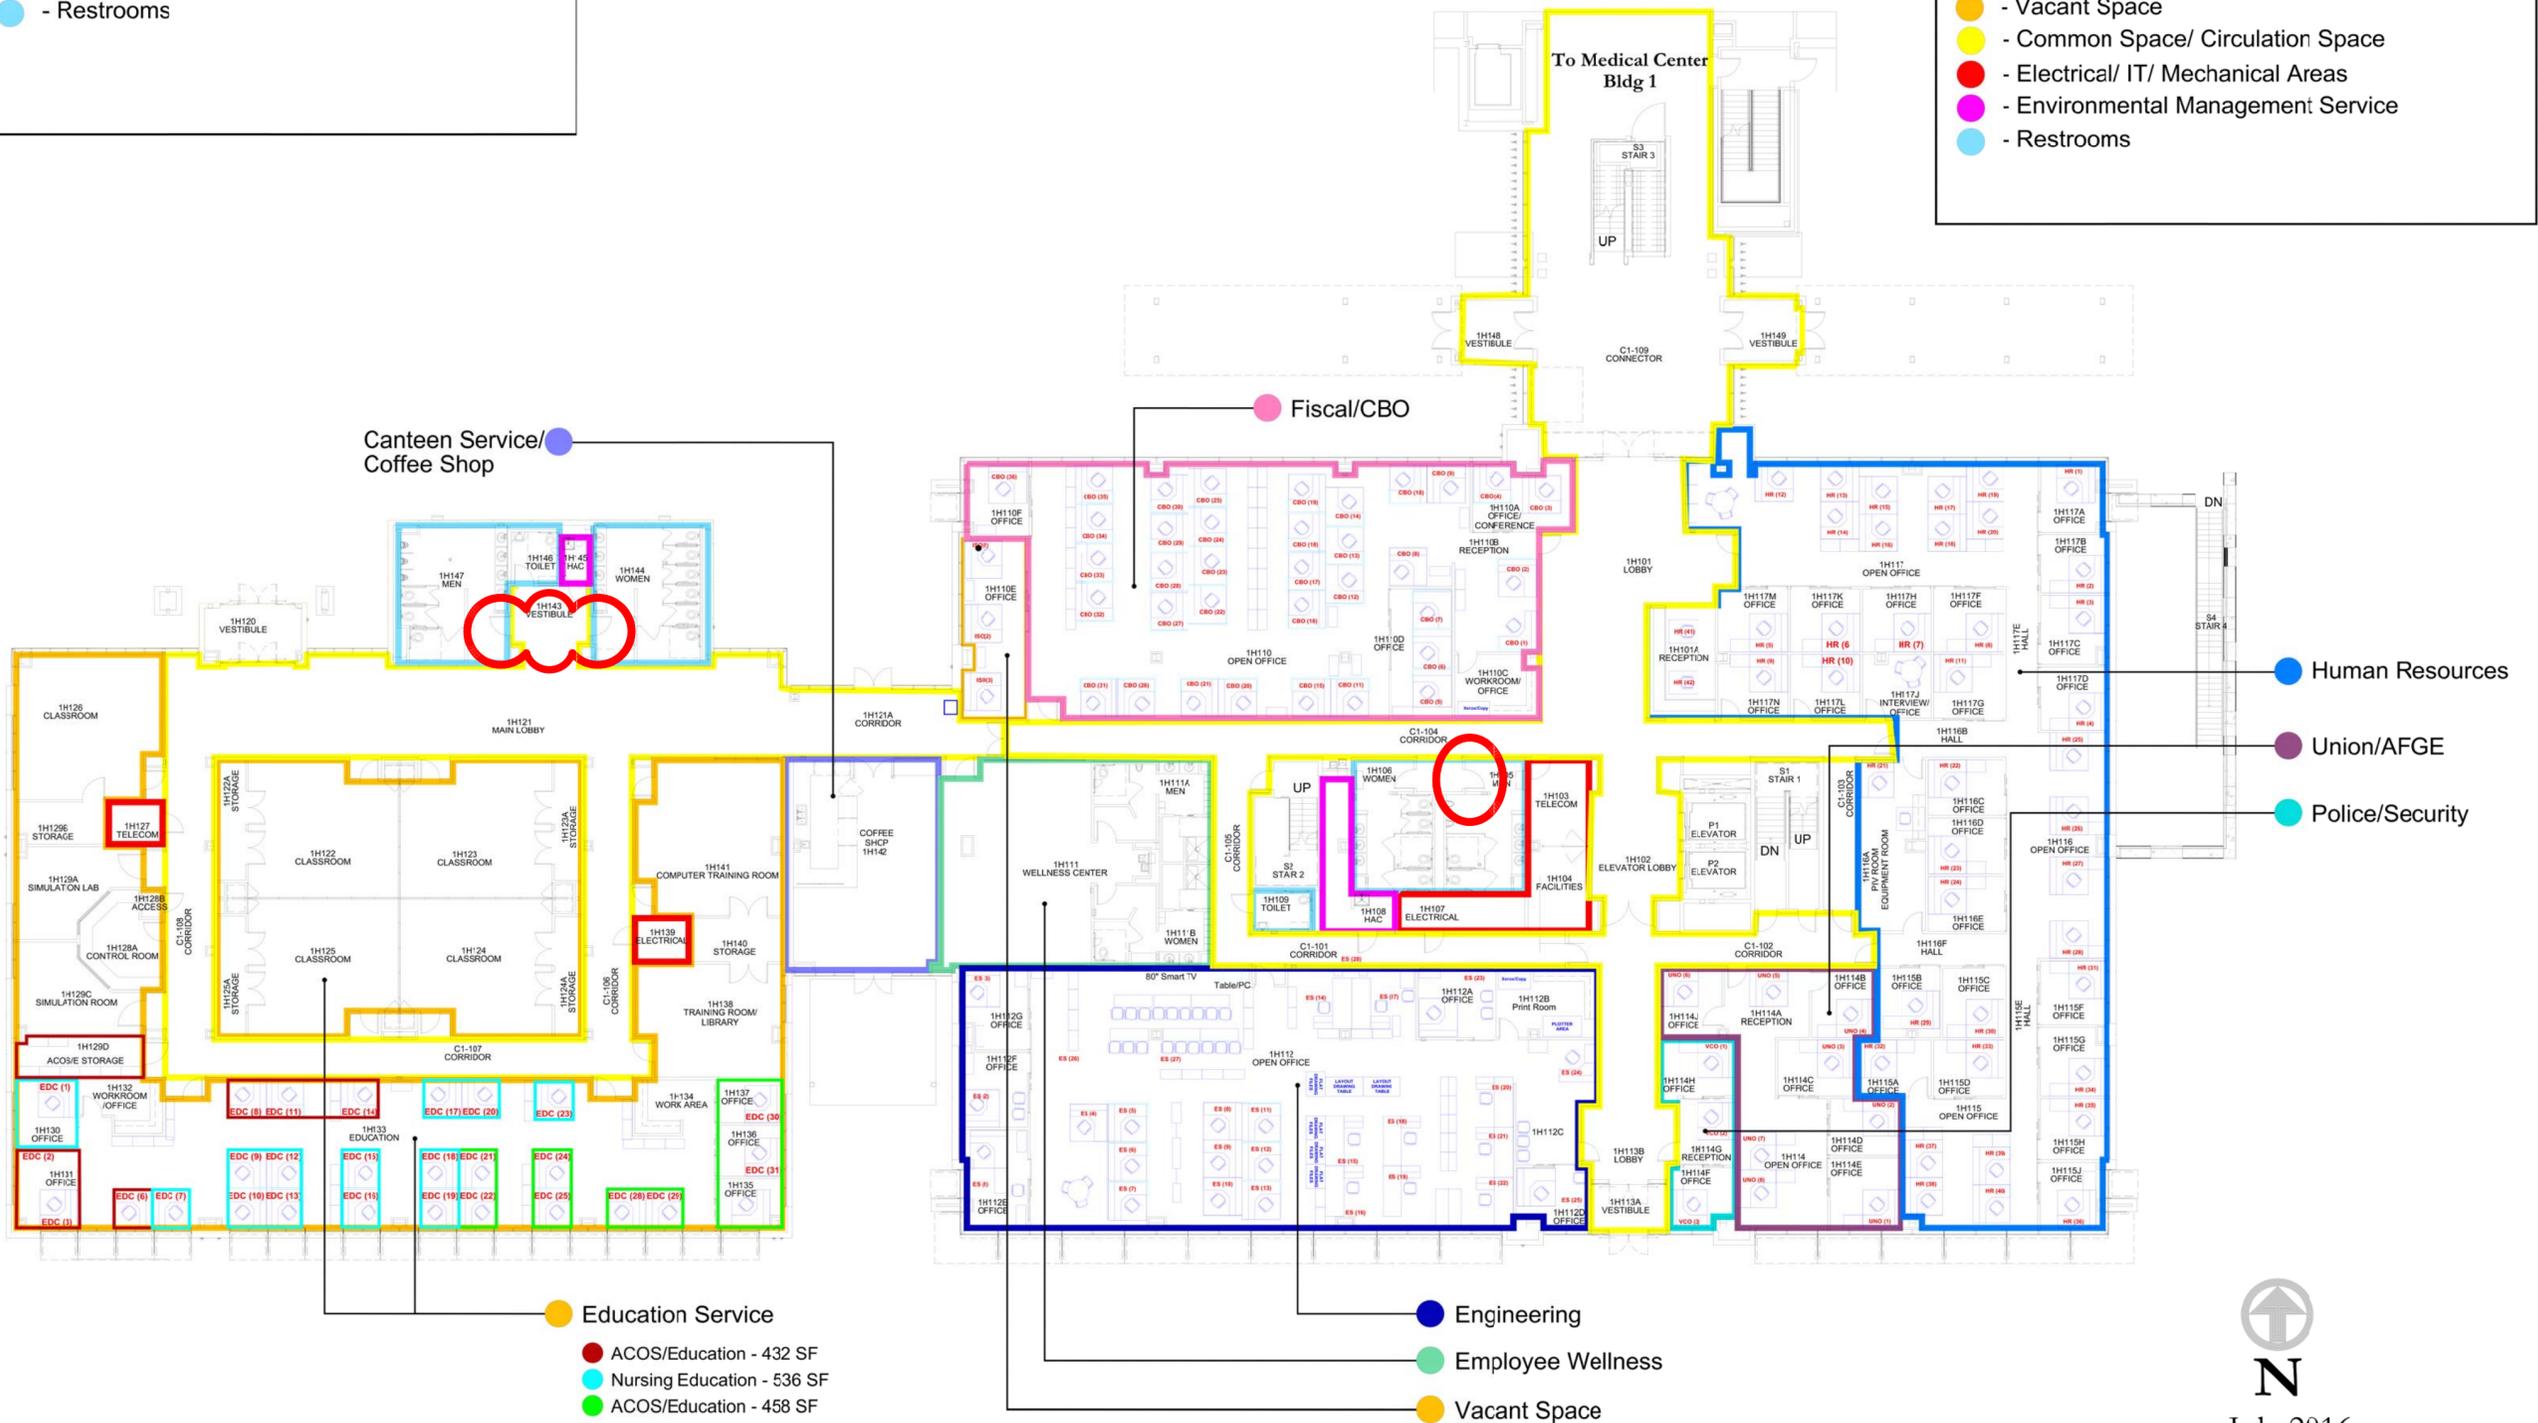

**Education Building 7 - 1st Floor**

**Administration Building 6 - 1st Floor**

