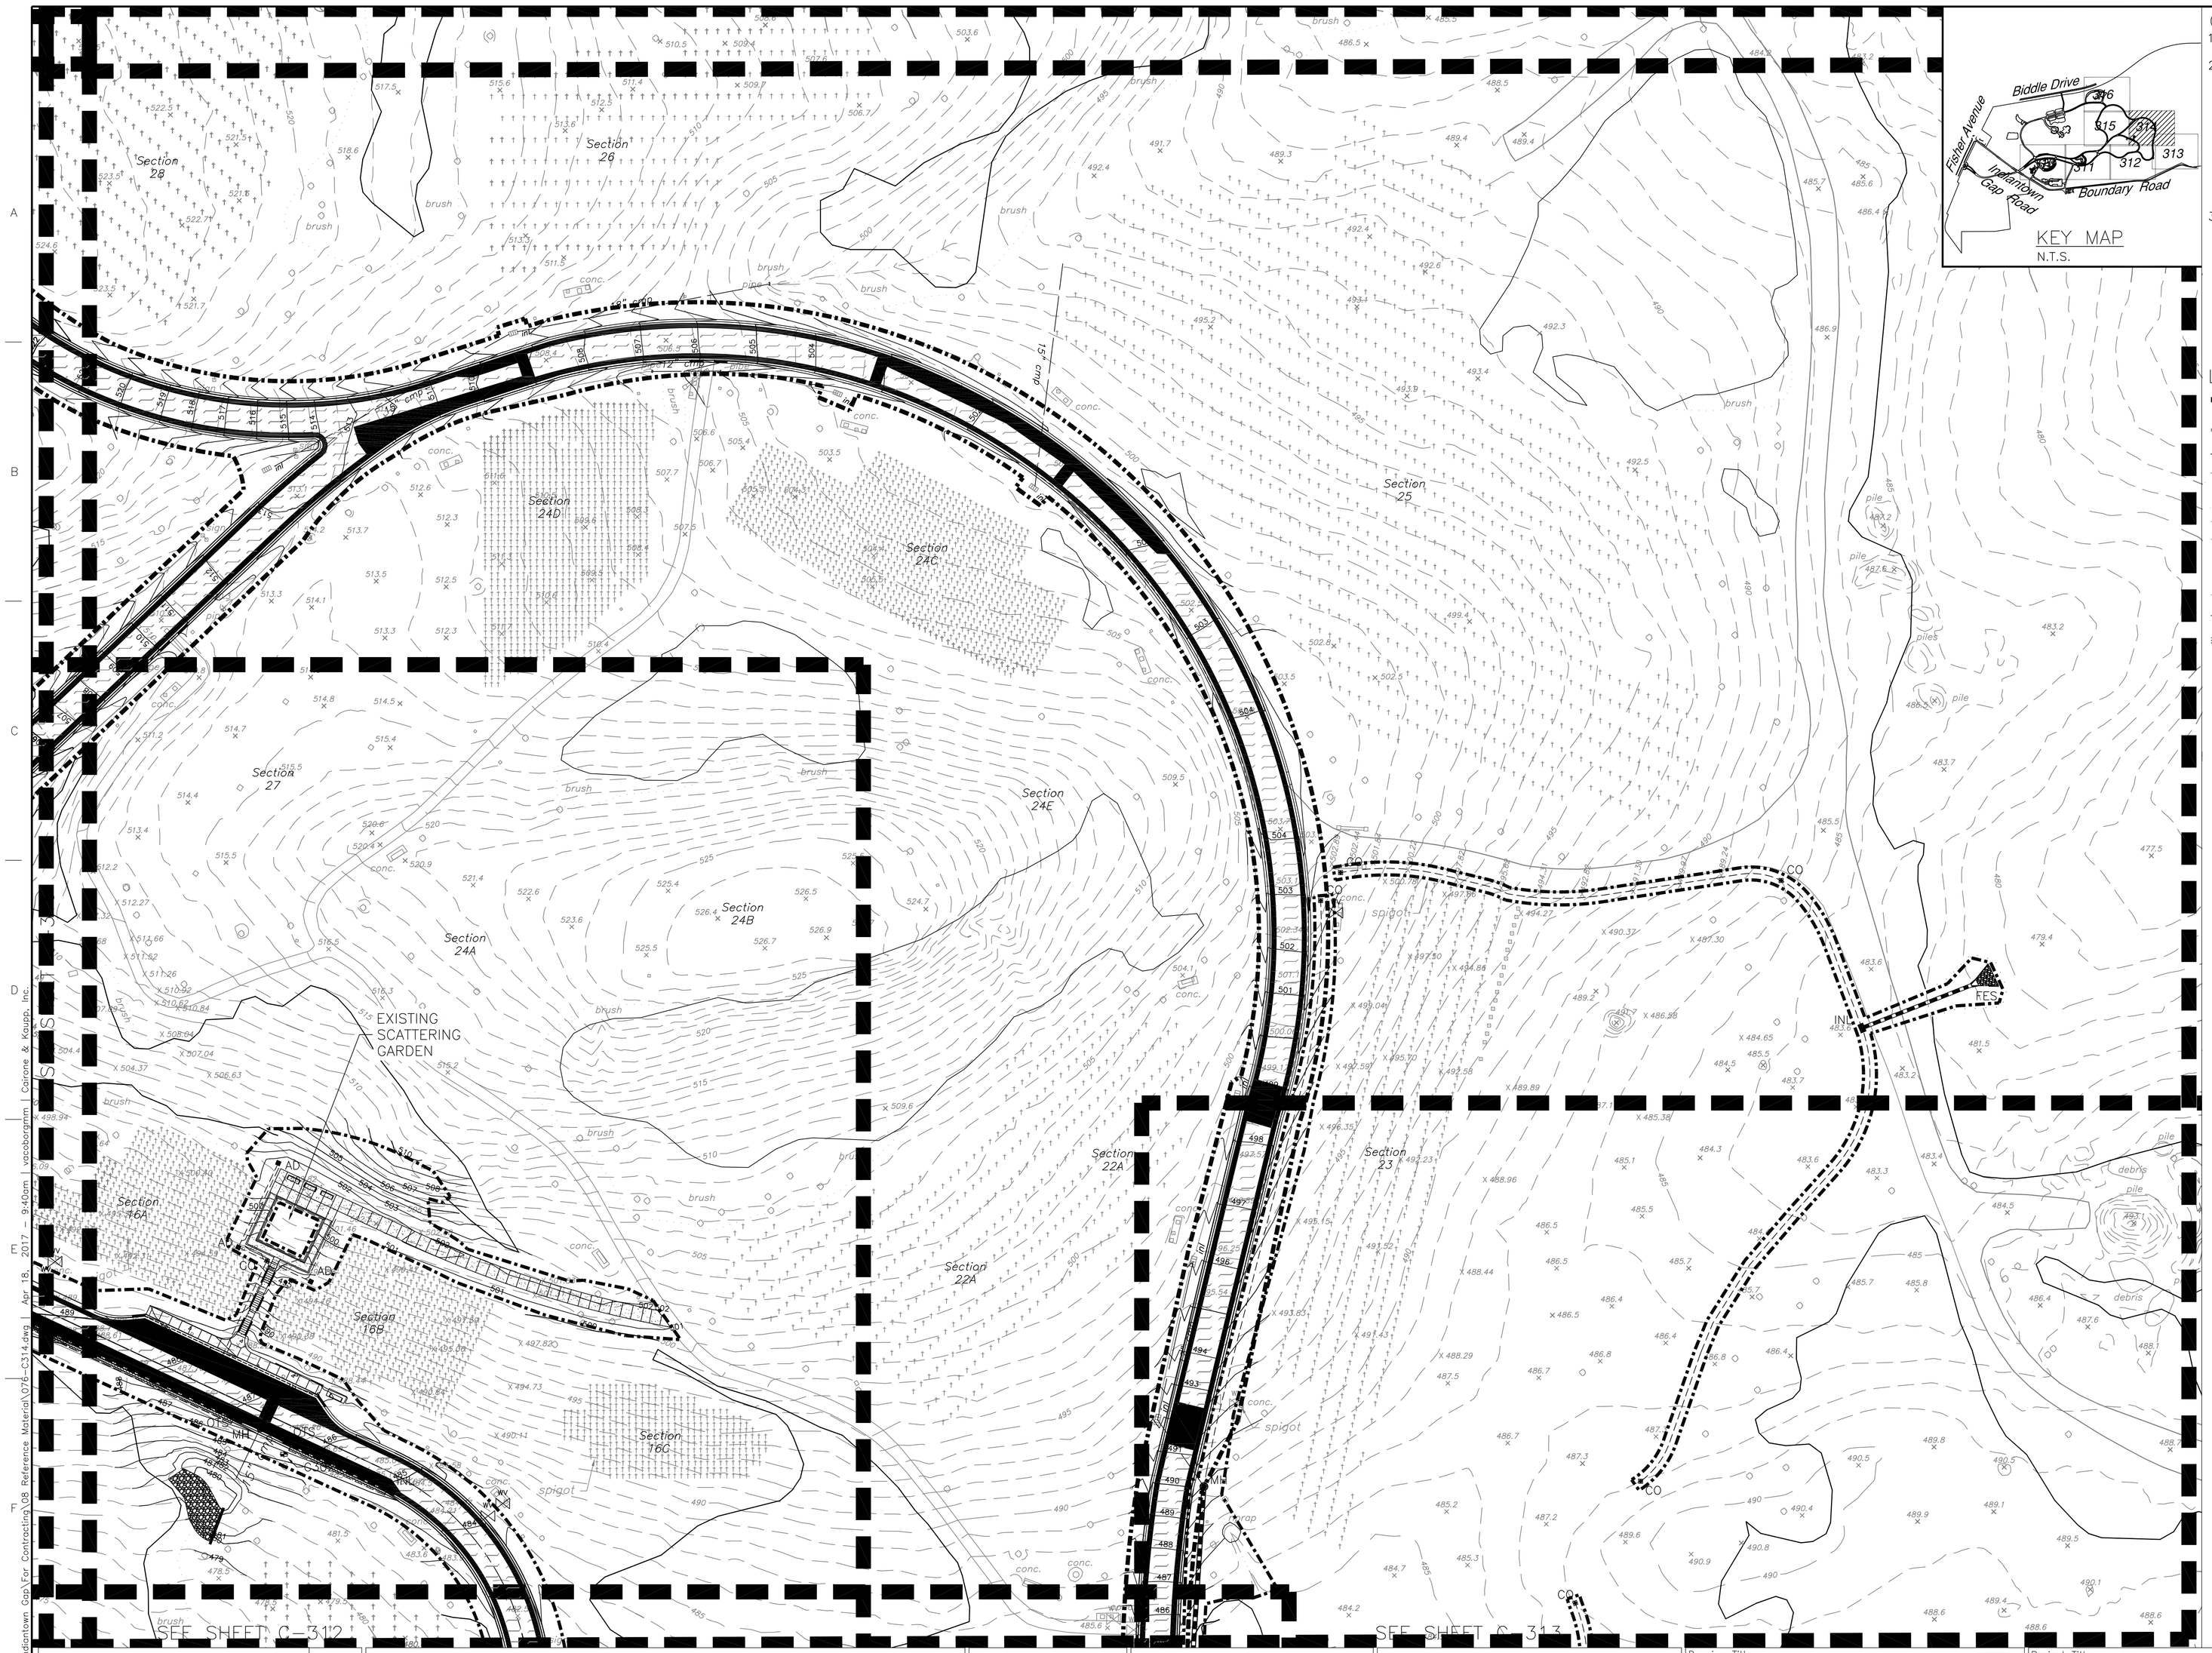

GENERAL NOTES

1. EXISTING CONDITIONS BASED UPON SURVEY BY L. ROBERT KIMBALL & ASSOCIATES, DATED MAY 9, 2011.
2. DATE OF AERIAL PHOTOGRAPHY: MARCH 17, 2010.CONTRACTOR SHALL INSPECT AND VERIFY ALL FIELD DIMENSIONS AND SITE CONDITIONS SHOWN HEREIN BEFORE PROCEEDING WITH THE WORK. DISCREPANCIES BETWEEN FIELD CONDITIONS AND THESE PLANS SHALL BE BROUGHT TO THE DEPARTMENT OF VETERANS AFFAIRS RESIDENT ENGINEER'S ATTENTION PRIOR TO ANY COMMENCEMENT OF THE WORK. ONCE CONSTRUCTION HAS BEGUN CONTRACTOR SHALL NOT USE FIELD INFORMATION DISCREPANCIES AS THE BASIS FOR CHANGE ORDER CLAIMS.
3. THE LOCATION OF EXISTING UNDERGROUND UTILITIES ARE SHOWN IN AN APPROXIMATE WAY ONLY AND HAVE NOT BEEN INDEPENDENTLY VERIFIED. THE CONTRACTOR SHALL DETERMINE THE EXACT LOCATION OF ALL EXISTING UTILITIES BEFORE COMMENCING WORK, AND AGREES TO BE FULLY RESPONSIBLE FOR ANY AND ALL DAMAGES WHICH MIGHT BE OCCASIONED BY THE CONTRACTOR'S FAILURE TO EXACTLY LOCATE AND PRESERVE ANY AND ALL UNDERGROUND UTILITIES. CONTRACTOR SHALL COMPLY WITH "PENNSYLVANIA ONE CALL" REQUIREMENTS.

LEGEND

- LIMIT OF ADD ALTERNATIVE EARTH DISTURBANCE
- LIMIT OF BASE BID EARTH DISTURBANCE
- PROPERTY LINE
- STREAM CENTERLINE
- TREE LINE
- BRUSH LINE
- EDGE OF ROAD
- DITCH LINE
- OVERHEAD LINE
- NEW BRUSH/TREE LINE
- 000 CONTOUR LINE
- 000 NEW CONTOUR LINE
- NEW MOUNTABLE CONCRETE CURB & GUTTER
- TREE OR BUSH
- HEADSTONE
- FLAGS
- POST
- SIGN
- inl INLET
- E S ⊕ mh ELECTRIC, SANITARY OR STORM MANHOLE
- UTILITY POLE
- CO NEW CLEAN OUT
- INL NEW INLET
- MH NEW MANHOLE
- FES NEW FLARED END SECTION
- X 000.0 SPOT ELEVATION
- + 000.0 NEW SPOT ELEVATION
- LP LOW POINT
- HP HIGH POINT
- FFE FINISHED FLOOR ELEVATION
- WETLANDS
- NEW ASPHALT PAVMENT
- NEW ASPHALT PAVMENT OVERLAY

GRAPHIC SCALE
0 15 30 60 120

THIS RECORD DRAWING HAS BEEN PREPARED, IN PART, BASED UPON INFORMATION FURNISHED BY OTHERS. WHILE THIS INFORMATION IS BELIEVED TO BE RELIABLE, THE ENGINEER ASSUMES NO RESPONSIBILITY FOR THE ACCURACY OF THIS RECORD DRAWING OR FOR ANY ERRORS OR OMISSIONS THAT MAY HAVE BEEN INCORPORATED INTO IT AS A RESULT OF INCORRECT INFORMATION PROVIDED TO THE ENGINEER. THOSE RELYING ON THIS RECORD DOCUMENT ARE ADVISED TO OBTAIN INDEPENDENT VERIFICATION OF ITS ACCURACY.

RECORD DRAWING 04-14-14

Revisions: Date

CONSULTANTS:

the LA group
Landscape Architecture and Engineering, PC
40 Long Alley
Saratoga Springs
New York 12866
P 518/587-8100
F 518/587-0180
www.thelagroup.com

L.R. Kimball
ARCHITECTURE • ENGINEERING • COMMUNICATIONS TECHNOLOGY
TWO COMMERCE SQUARE
2001 Market St., Suite 810
Philadelphia, PA 19103

Aqua Engineering, Inc.
Innovative Water Solutions
4803 Innovation Drive
Fort Collins, Colorado 80525
Phone (970) 229-9668
FAX (970) 226-3855

A.D. MARBLE & COMPANY
Environmental, Cultural & Engineering Services
375 East Elm Street, Suite 200
Conshohocken, PA 19428

PRIME CONSULTANT:

CAIRONE & KAUPP, INC
PLANNING, ENGINEERING AND LANDSCAPE ARCHITECTURE
1118 E. Columbia Avenue
Philadelphia, PA 19125
215 291 2500

NATIONAL CEMETERY ADMINISTRATION

Drawing Title: GRADING PLAN BID ALTERNATE #3

Approved: Project Director: .\PD sig.tif

Project Title: PHASE 4 - GRAVESITE DEVELOPMENT & CEMETERY IMPROVEMENTS

Location: INDIANTOWN GAP N.C. LEBANON COUNTY, PENNSYLVANIA

Date: 07-08-11 | Checked: BEL/WJK | Drawn: KW

Project Number: 813CM2024

Drawing Reference Number: 076

Drawing Number: C-314

Office of Construction & Facilities Management
CFM
Department of Veterans Affairs

VA FORM 08-6231, OCT 1978

C:\Temp\Borgmon Work Folder\Indiantown Gap\For Contracting\08 Reference Material\076-C314.dwg | Apr 19, 2017 - 9:40am | vdcobborgmon | Cairone & Kaupp, Inc.