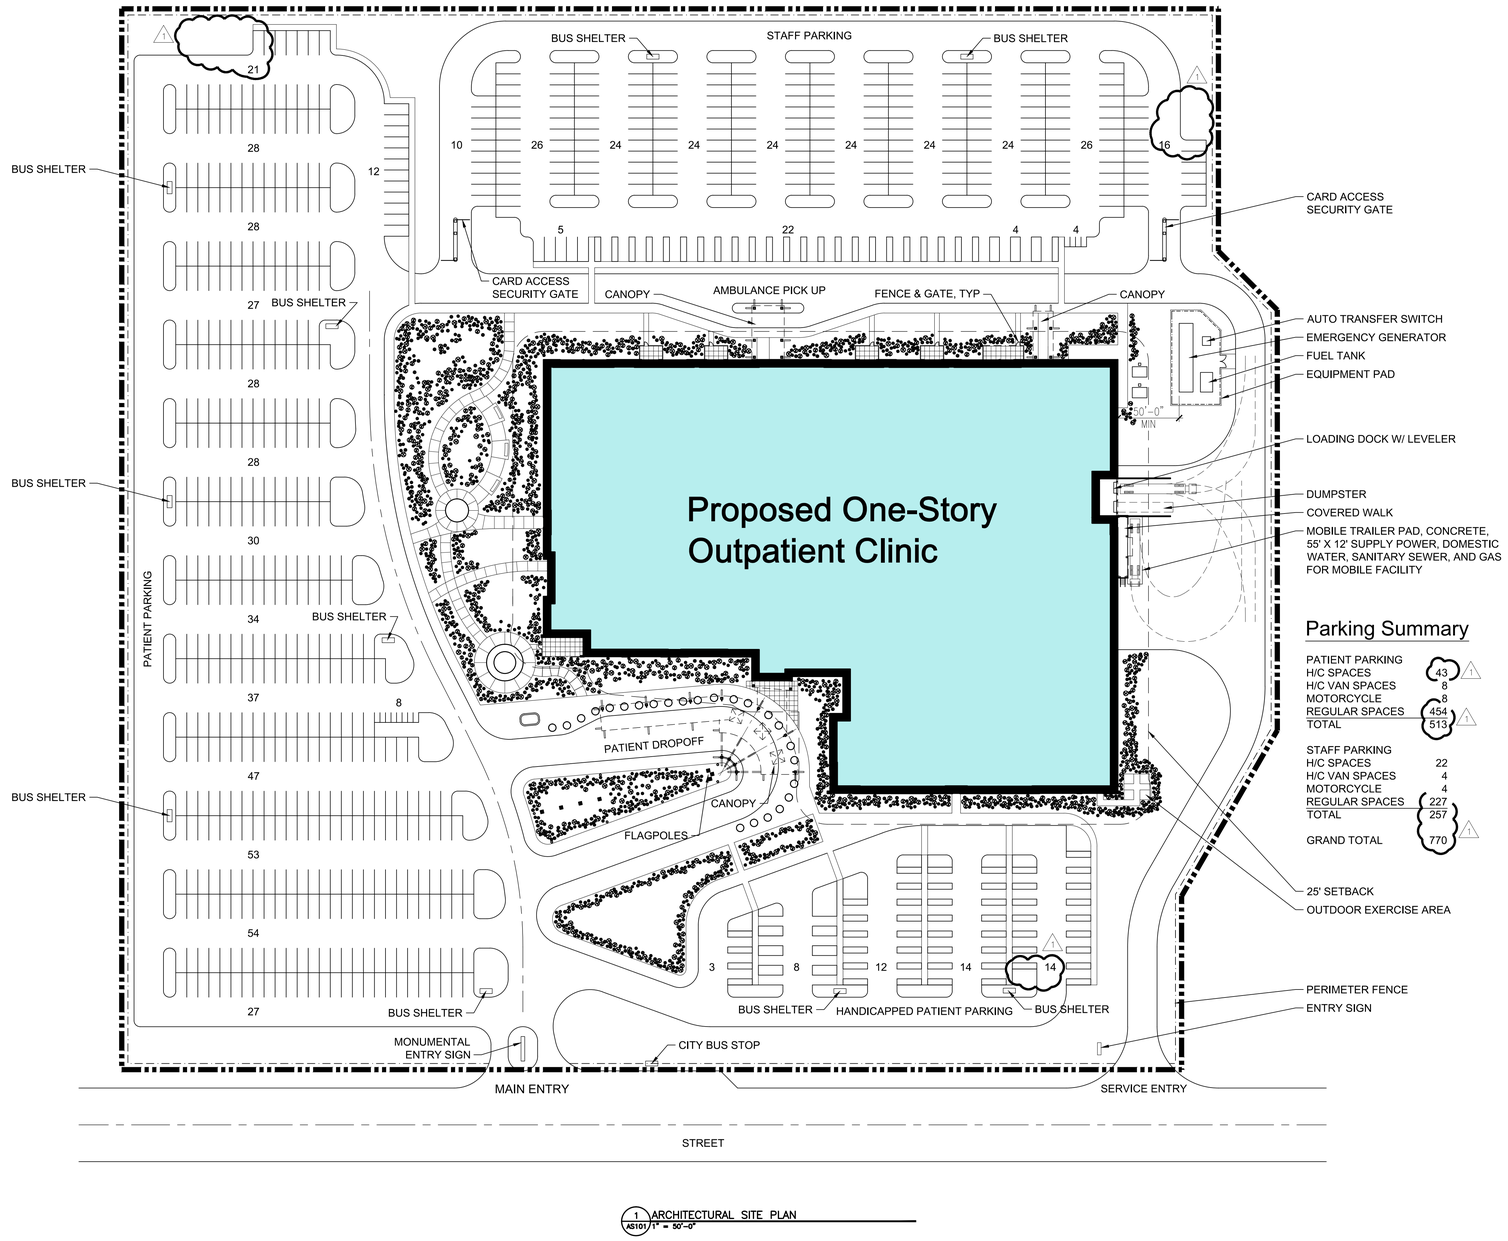

Parking Summary

PATIENT PARKING	
H/C SPACES	43
H/C VAN SPACES	8
MOTORCYCLE	8
REGULAR SPACES	454
TOTAL	513
STAFF PARKING	
H/C SPACES	22
H/C VAN SPACES	4
MOTORCYCLE	4
REGULAR SPACES	227
TOTAL	257
GRAND TOTAL	770

1 ARCHITECTURAL SITE PLAN
AS101 1" = 50'-0"

General Revision No. 1	5-18-17
Revisions:	Date

CONSULTANTS:

ARCHITECT:

TOLAND • MIZELL
ARCHITECTS, INC.

Drawing Title: ARCHITECTURAL SITE PLAN

Approved: Project Director

Project Title: COMMUNITY BASED OUTPATIENT CLINIC

Location: NEW PORT RICHEY, FL

Date: 3-21-2016 | Checked: AT | Drawn: MB

FINAL SUBMITTAL

Building Number: XX

Drawing Number: AS101

Dwg. XX of XX

OFFICE OF CONSTRUCTION AND FACILITIES MANAGEMENT

Department of Veterans Affairs

VA FORM 08-6231

Drawing File: G:\PROJECTS\2015 PROJECTS\15046 New Port Richey SFO\3 15046 Drawings\VA New Port Richey SFO\Sheets\AS101 ARCHITECTURAL SITE PLAN.dwg
Plotted By: CCampbell
Plotted Date: May 18, 2017 - 2:52pm