MACHINE BEAM REACTIONS	
R1	14,550 #
R2	28,600 #
R3	450 #
R4	2,100 #
R5	8,500 #
R6	3,550 #

BUFFER REACTIONS	200 F.P.M.	350 F.P.M.
CAR R7	16,050 #	20,100 #
CWT. R8	23,000 #	28,800 #

CAPACITY	4,000 LBS.
SPEED F.P.M.	200 F.P.M.

SERVICE ELEVATORS REACTIONS

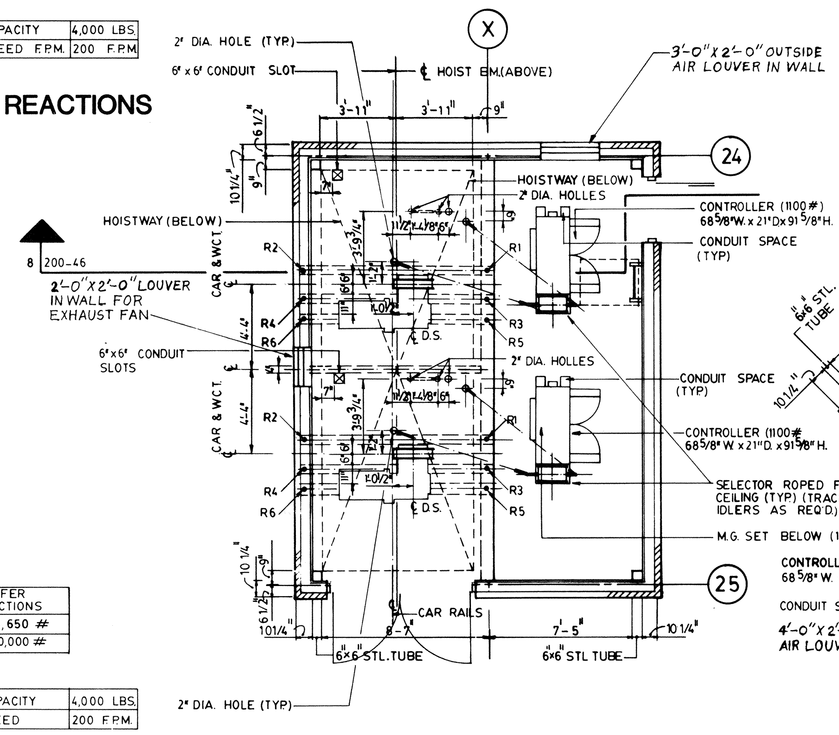

MACHINE BEAM REACTION	
R1	13,050 #
R2	9,250 #
R3	250 #
R4	200 #
R5	6,750 #
R6	4,850 #

BUFFER REACTIONS	
R7	15,650 #
R8	20,000 #

CAPACITY	4,000 LBS.
SPEED	200 F.P.M.

PASSENGER ELEVATORS REACTIONS

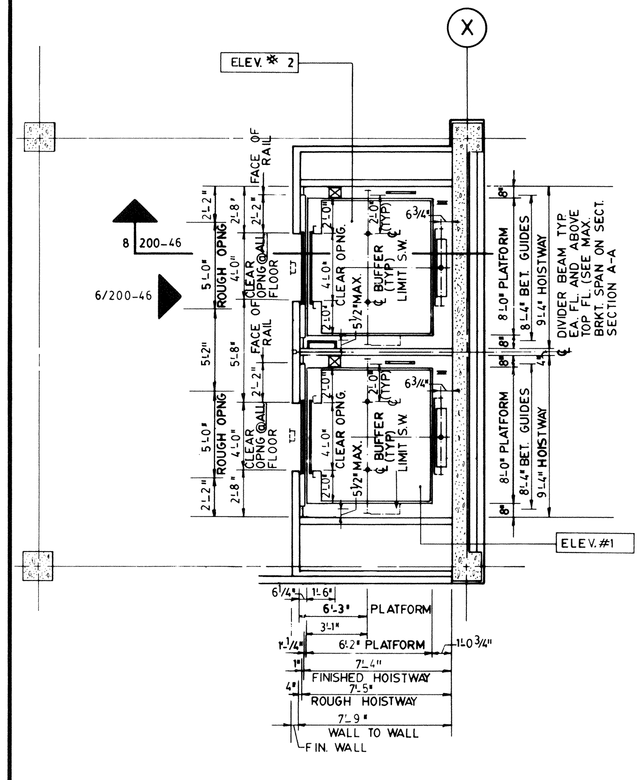

ELEVATOR CORE 'A' MECH. ROOM

0 5'

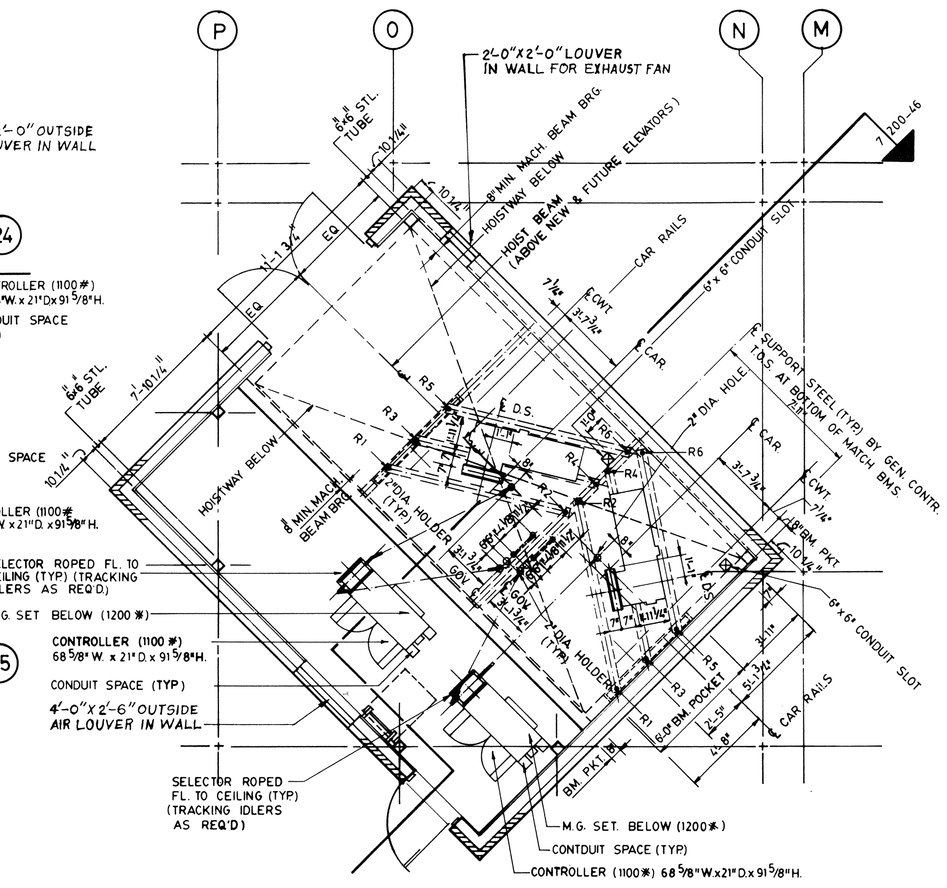

ELEVATOR CORE B/C MECH. ROOM

0 5' ELEVATOR CORE D/E IS OPPOSITE HAND

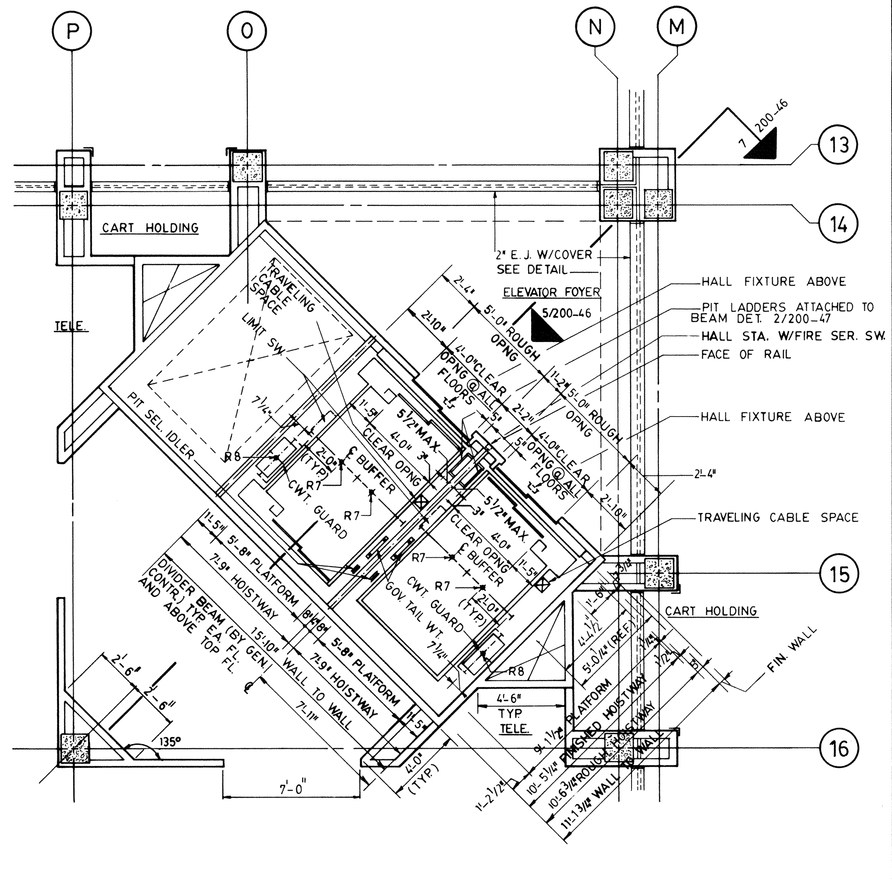

ELEVATOR CORE B/C FIRST AND SECOND FLOOR

0 5' ELEVATOR CORE D/E IS OPPOSITE HAND

ELEVATOR CORE 'A' FIRST AND SECOND FLOOR

0 5'

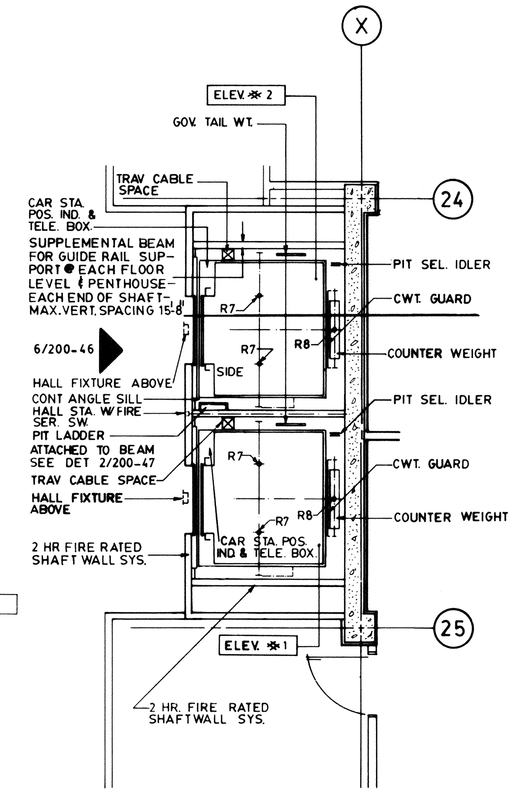

ELEVATOR CORE 'A' GROUND FLOOR

0 5'

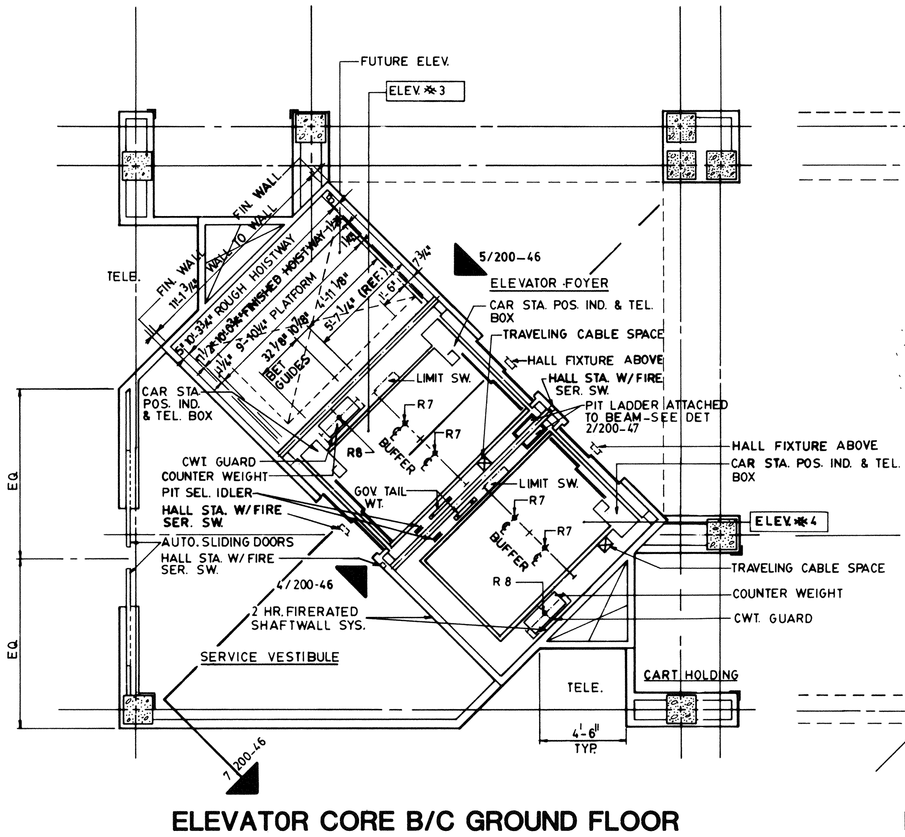

ELEVATOR CORE B/C GROUND FLOOR

0 5' ELEVATOR CORE D/E IS OPPOSITE HAND

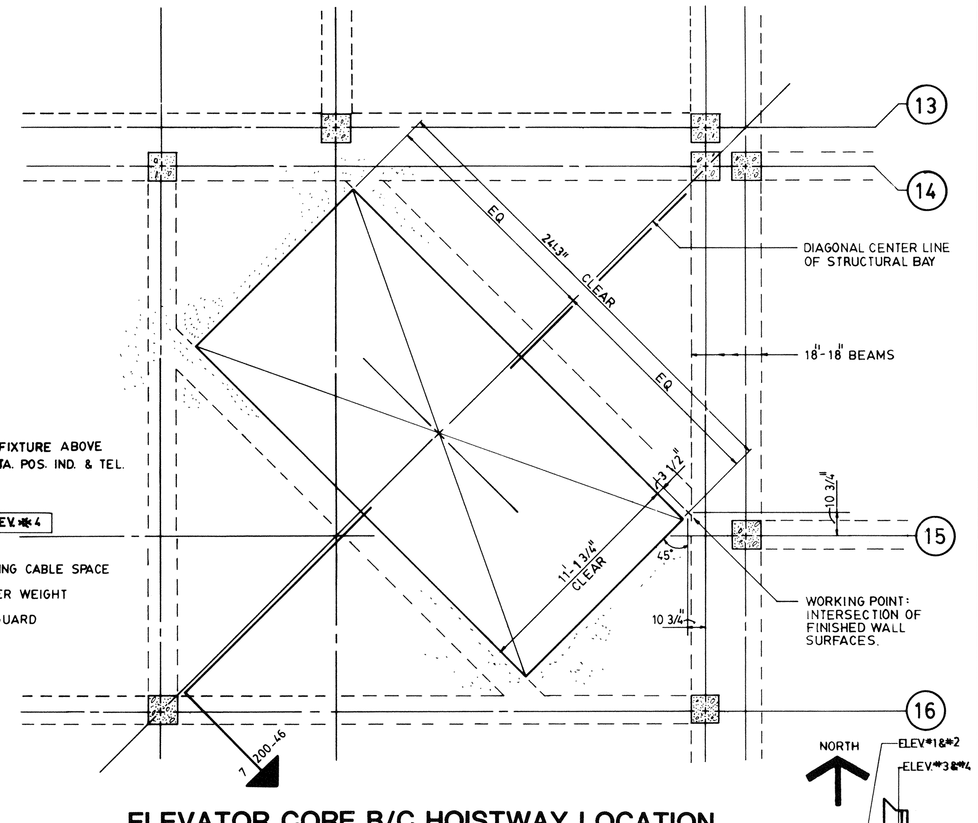

ELEVATOR CORE B/C HOISTWAY LOCATION

0 5' ELEVATOR CORE D/E IS OPPOSITE HAND

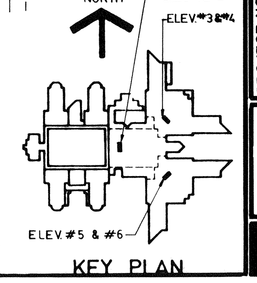

KEY PLAN

7-4-2-0113

GRESHAM, SMITH AND PARTNERS
3310 West End Avenue, Post Office Box 1625
Nashville, Tennessee 37202-1625

AREAS OF NEW CONSTRUCTION ARE FULLY PROTECTED BY AN AUTOMATIC FIRE EXTINGUISHMENT SYSTEM

PROJECT TITLE: BED TOWERS/ RENOVATION PHASE 2

LOCATION: VAMC MOUNTAIN HOME, TN.

BLDG NO. 200

DRAWN BY :

DRAWING TITLE: ENLARGED ELEVATOR PLANS

PROJECT DIRECTOR APPROVAL

PROJECT NO. 621-064

DATE 01 13 86

DRAWING NO. 200-45

RECORD DRAWING 09/25/90

Veterans Administration

1 1
267 267 GRN
268 268

1A 14