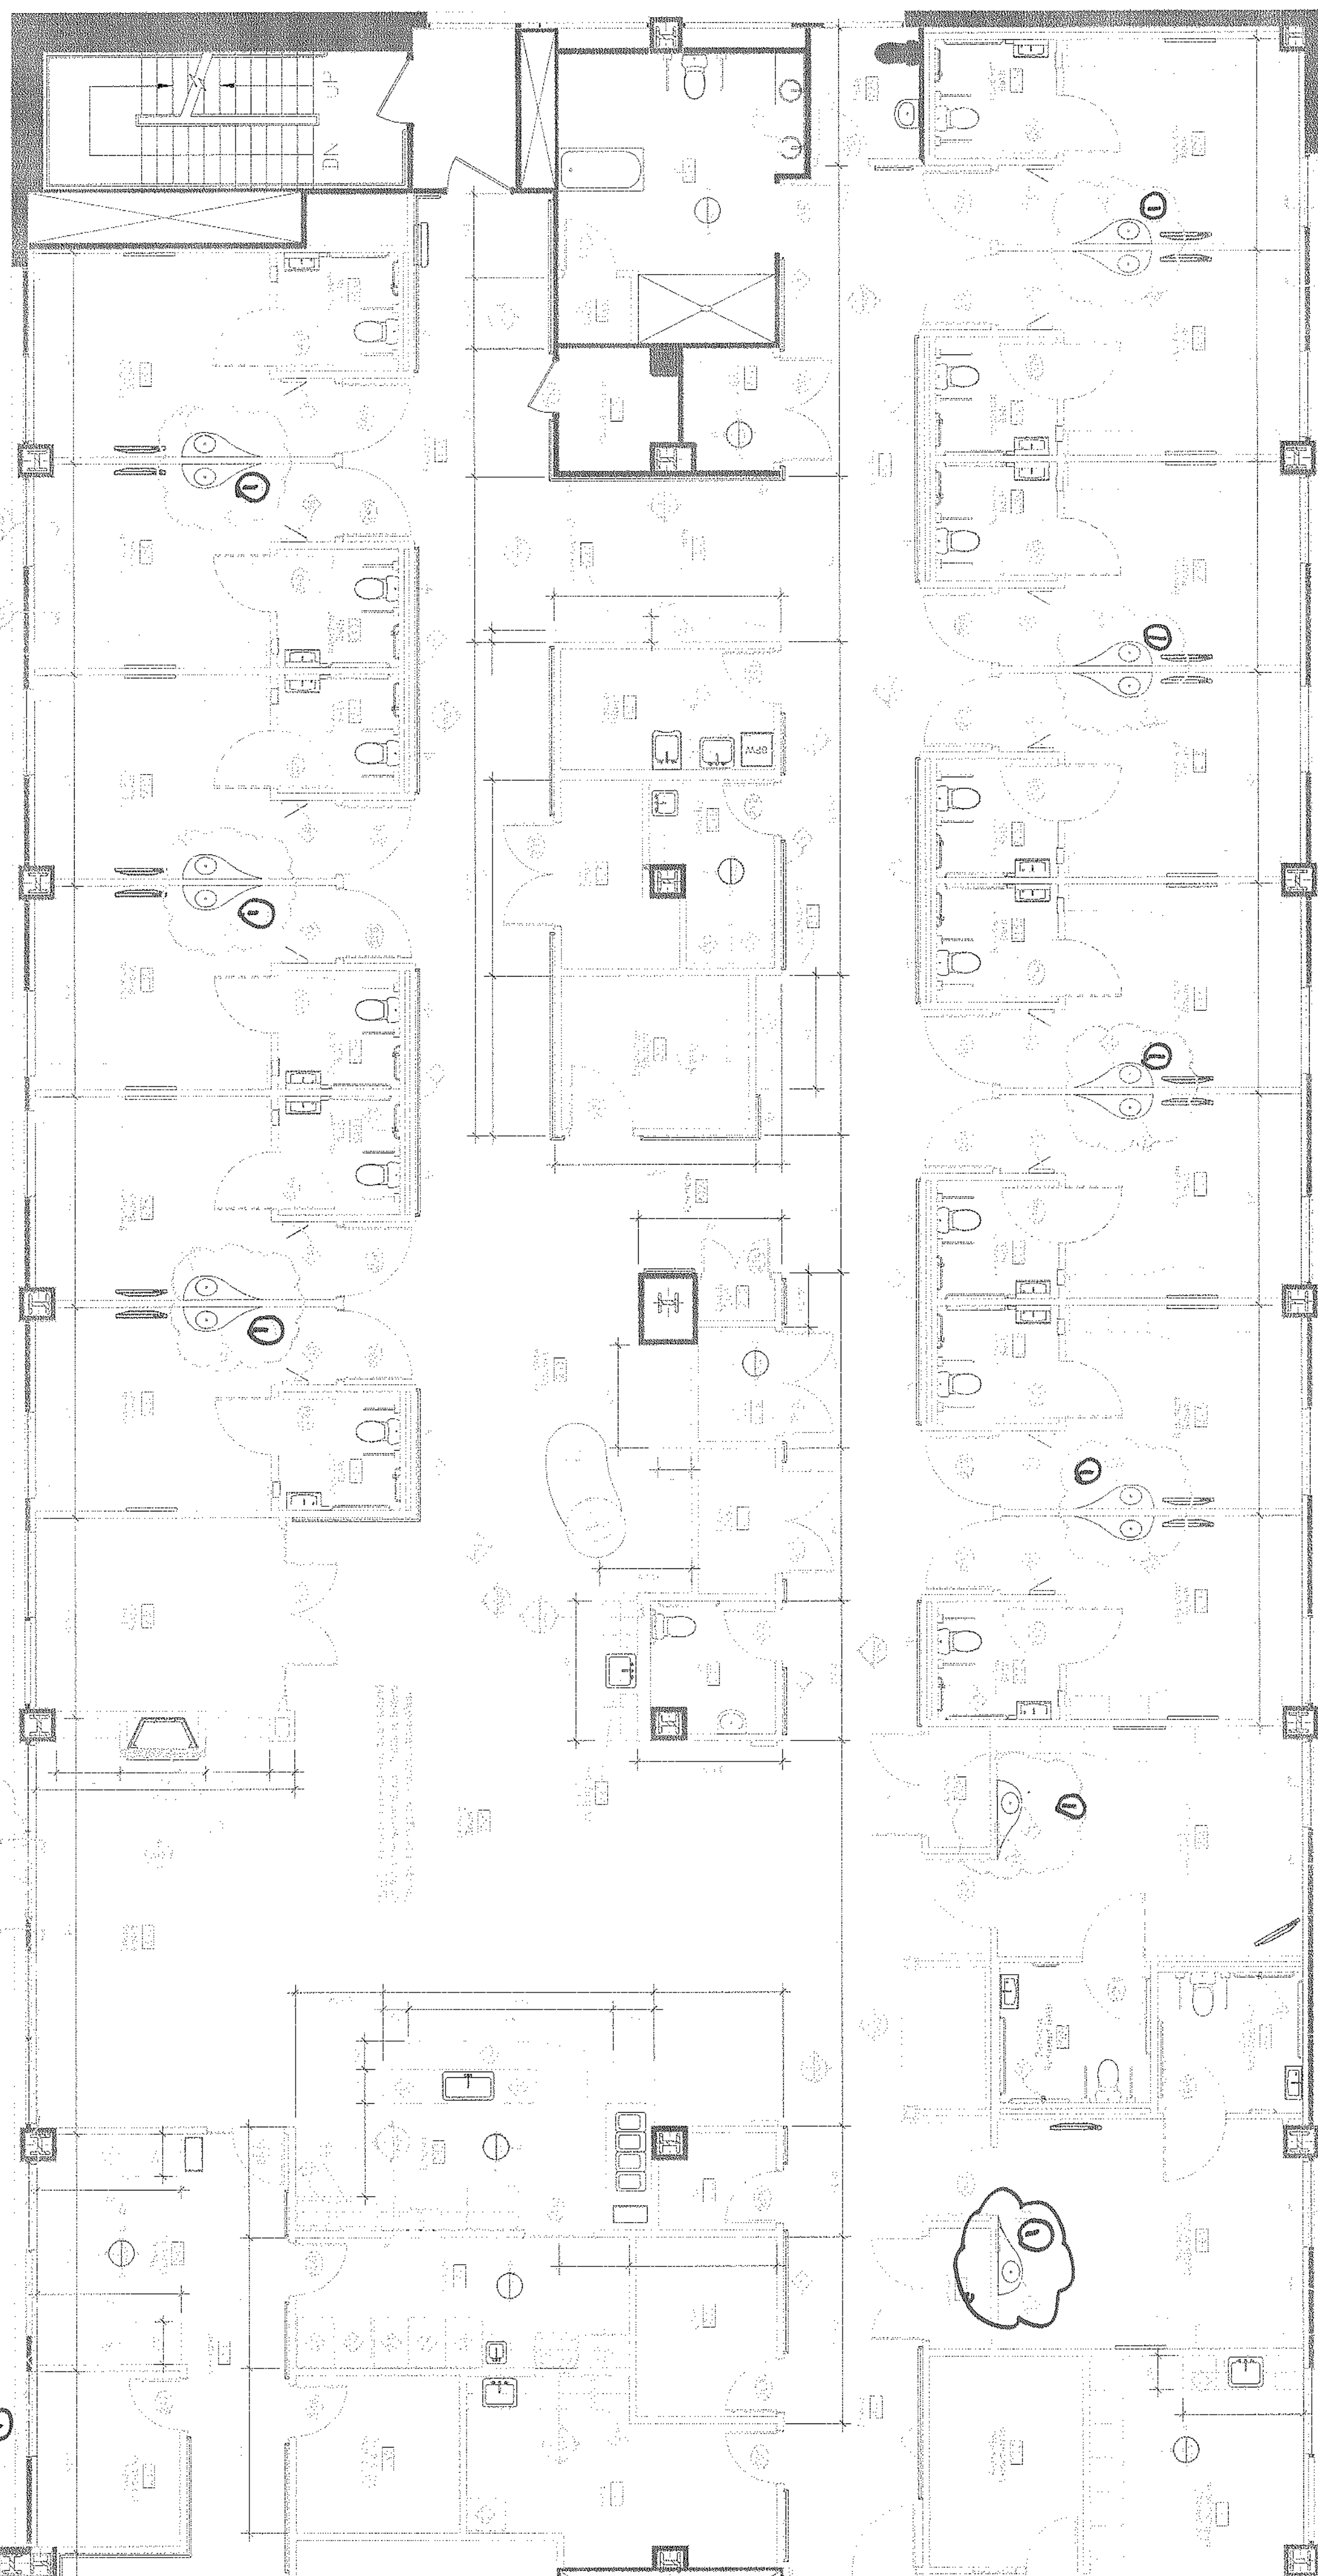



NOTE #1 – DELETE SINKS AND ASSOCIATED WASTE, WATER AND VENT LINES FROM PATIENT BEDROOMS ONLY. SINKS WILL REMAIN IN PATIENT PRIVATE BATHROOMS.

[illegible][illegible]