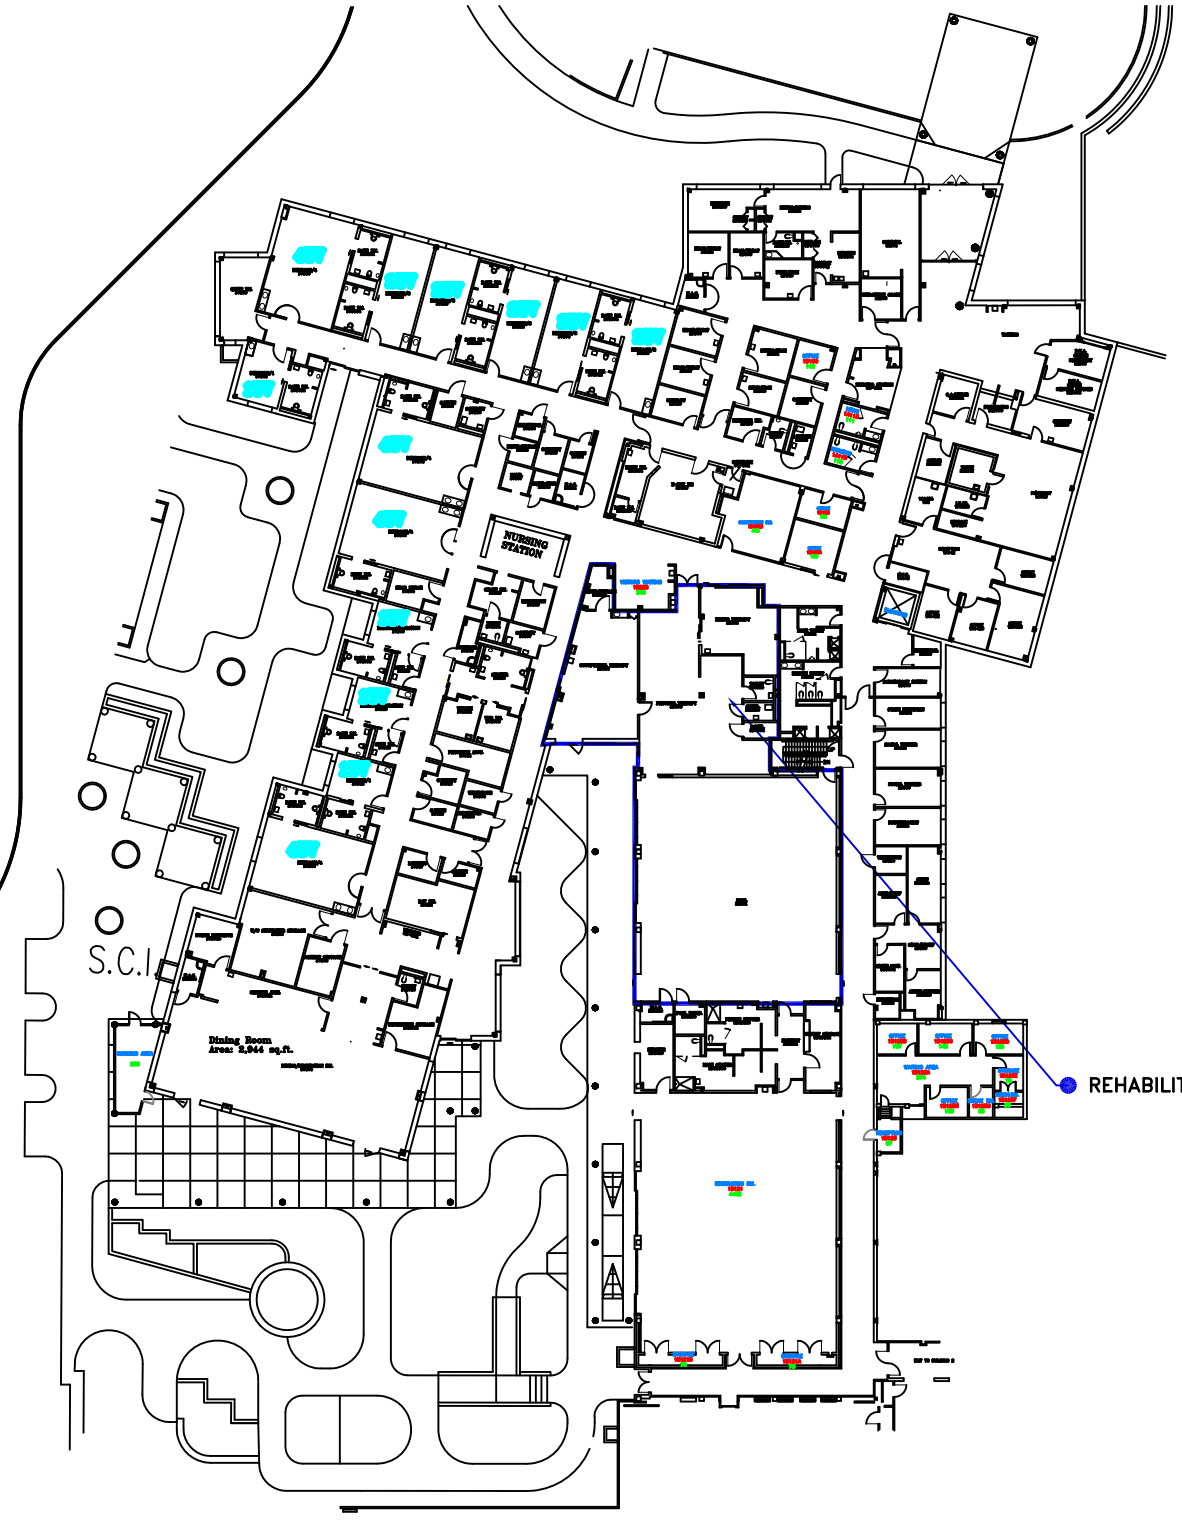

REHABILITATION MEDICINE SVC....7,309gsf

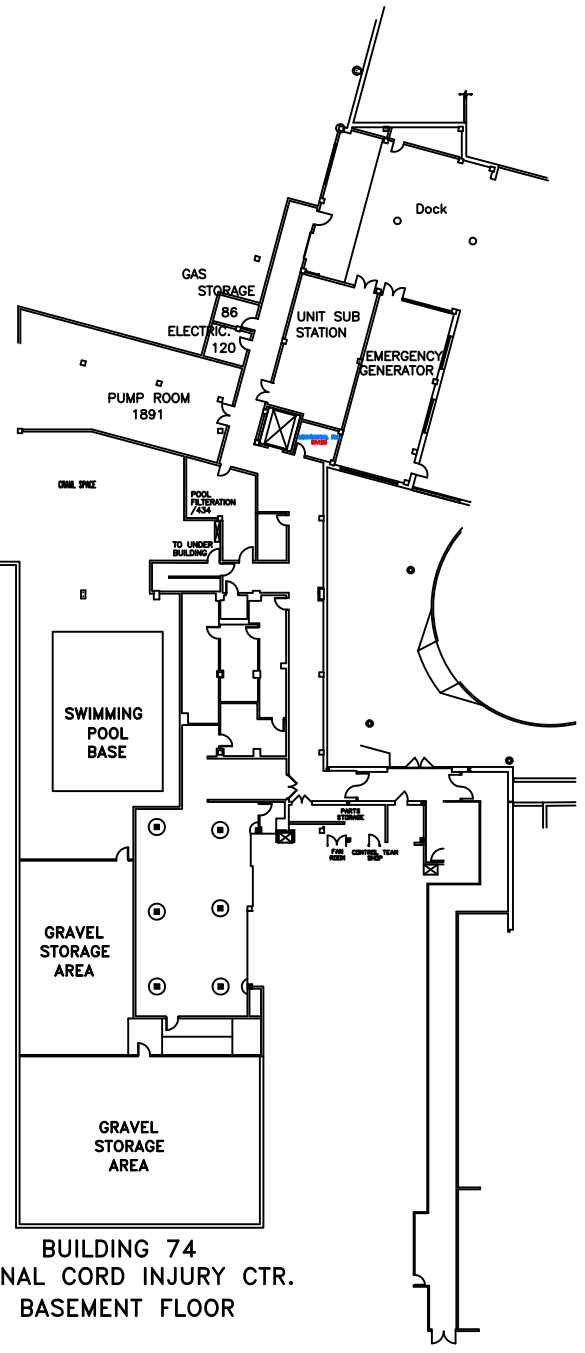

BUILDING 74
SPINAL CORD INJURY CTR.
BASEMENT FLOOR

Scale for Drawing

NORTH

Revisions	Date

Computer Filename:

Seal

Seal

Drawing Title: Building 74/Spinal Cord Injury Ctr. First Floor/Basement

Approved: Area Project Manager

Project Title: "As Built" Drawing

Building Number: 74 | Checked | Drawn: D.G.

Location: 4500 S. Lancaster Rd. Dallas, Texas 75216

Date: 5/10/99

Project No.

Drawing No.: SI-66

Dwg. of

VANTHCS Dallas, Texas

VA FORM 08-6231A, JAN 1990