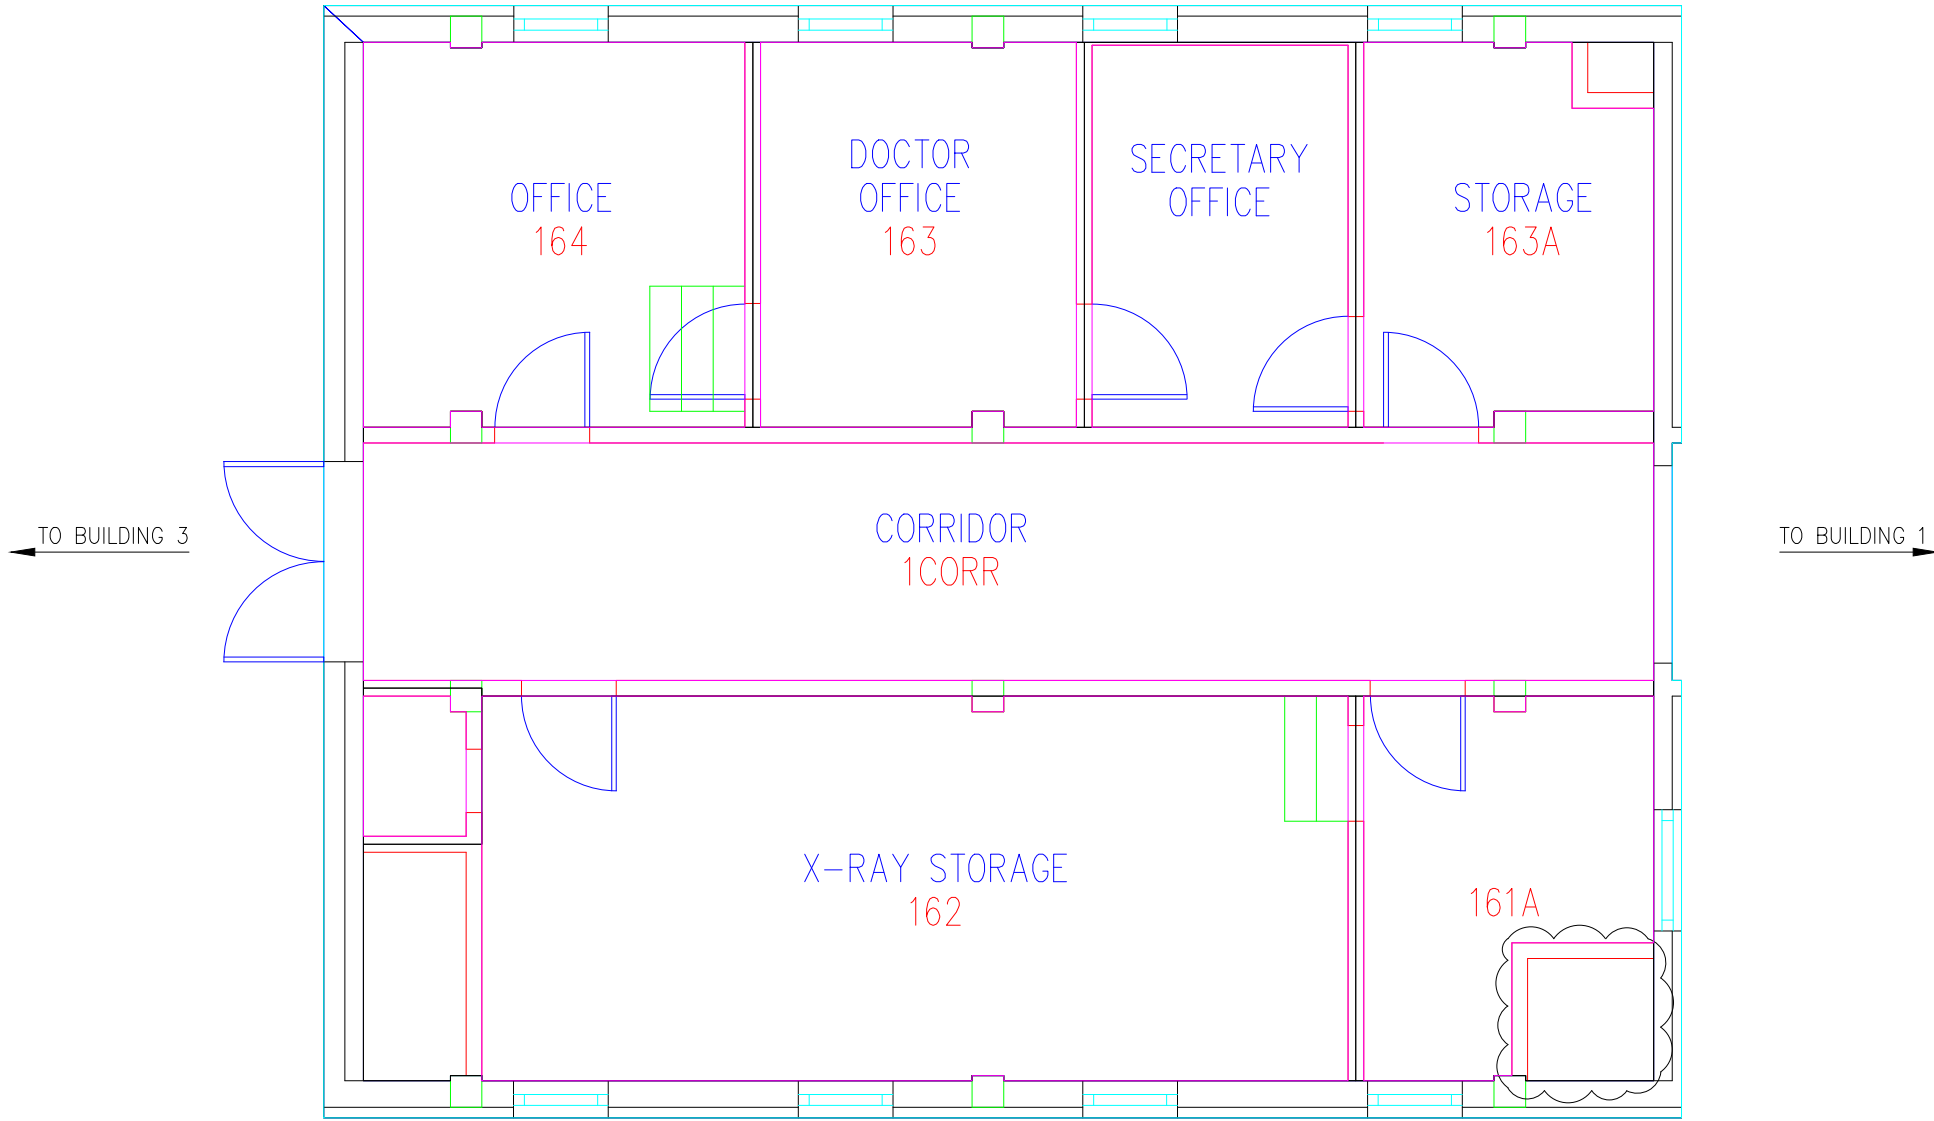

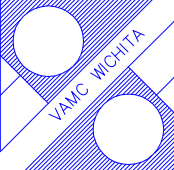


NORTH



BUILDING 1A, FLOOR 1

				 Indus Systems, Inc. 2352, Main Street, Concord MA 01742 Tel: 978-461-0555 www.indus-systems.com		Drawing Title FIRST FLOOR PLAN ARCHITECTURAL		Date 01-23-2012			VA Department of Veterans Affairs	
						Checked		Drawn				Drawing No. WI-1A-01AR
Revisions		Date		Professional Seal		Location VAMC & ROC WICHITA, KS						