


LEGEND

○ REPLACE 3,220 L.F. OF CONCRETE CURB, FOR THE REPLACEMENT THE FENCE POST WILL ALIGN WITH THE JOINTS OF THE NEW CURB.

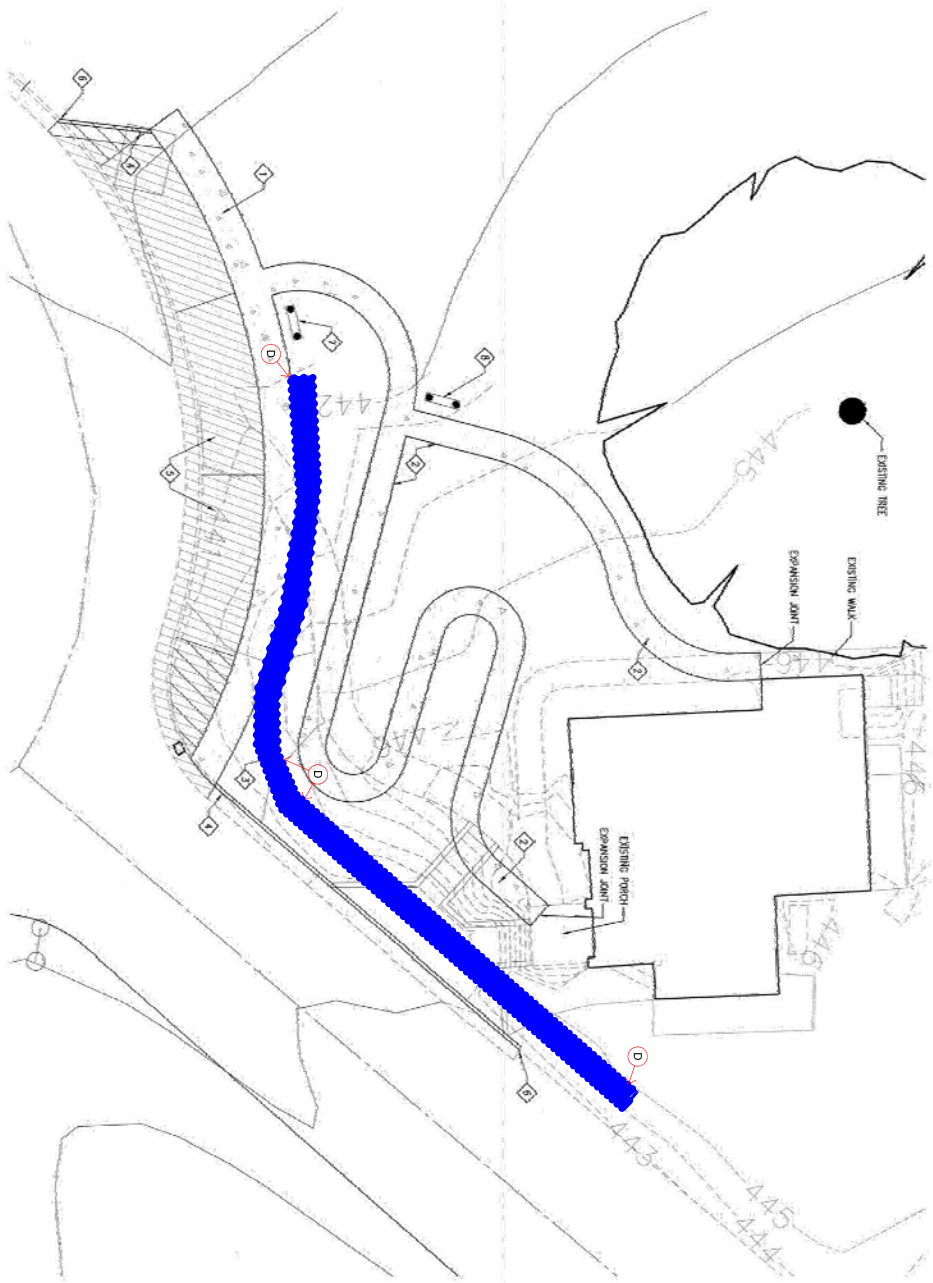

KEY NOTES:

- SITE PLAN KEY NOTES:**
1. NEW 5' WIDTH SIDEWALK - SEE DETAIL H/L-17
 2. NEW 4' WIDTH SIDEWALK - SEE DETAIL H/L-17
 3. NEW 12" WIDTH CAST-IN-PLACE CONCRETE WALL - SEE DETAIL N/L-23
 4. TRANSITION CURB FLUSH TO NEW ASPHALT - SEE DETAIL B/L-17
 5. NEW ASPHALT PAVING - SEE DETAILS C/L-17 AND D/L-17
 6. NEW CURB AND GUTTER, BE TO EXISTING - SEE DETAILS N/L-17
 7. INSTALL NEW ADMINISTRATION LOCATION SIGN - SEE DETAIL 1/L-19 TYPE AS
 8. INSTALL NEW DOUBLE SLOPED RESTROOM SIGN - SEE DETAIL 1/L-19 TYPE A&B

GENERAL NOTES:

1. SEE SHEET 3-1 FOR CIVIL, UTILITY, ASSESSMENTS, AND SPECIAL NOTES
2. CONTRACTOR IS RESPONSIBLE FOR ALL WORK SHOWN UNLESS SPECIFICALLY INDICATED OTHERWISE
3. CONTRACTOR SHALL VERIFY THE SITE PRIOR TO CONSTRUCTION TO DETERMINE THE EXTERIOR OF THE PROJECT.
4. CONTRACTOR SHALL CONTACT ARKANSAS ONE CALL AT 811 PRIOR TO ANY WORK. CONTRACTOR IS RESPONSIBLE FOR REDUCING AND PROTECTING ALL UTILITIES. CONTACT THE ENGINEER IN THE EVENT OF ANY UNEXPECTED UTILITIES.
5. ALL PROJECT STANDARDS SHALL BE PERFORMED BY AN ARKANSAS REGISTERED PROFESSIONAL SURVEYOR.

OWNER: STATE OF ARKANSAS



ADMINISTRATION BUILDING SITE PLAN

CEMETERY IMPROVEMENTS

Date: 09-15-2016

Project No.: 847COM30188

Approved: Director, Technical Support Service

Approved: Chief, Architectural & Engineering Division

Location: FORT SMITH, ARKANSAS

Sheet No.: L-2

Sheet Count: 183 of 184