


three inches = one foot  
 one and one half inches = one foot  
 one inch = one foot  
 one half inch = one foot  
 three quarters inch = one foot  
 one quarter inch = one foot  
 three eighths inch = one foot  
 one eighth inch = one foot  
 one eighth inch = one foot

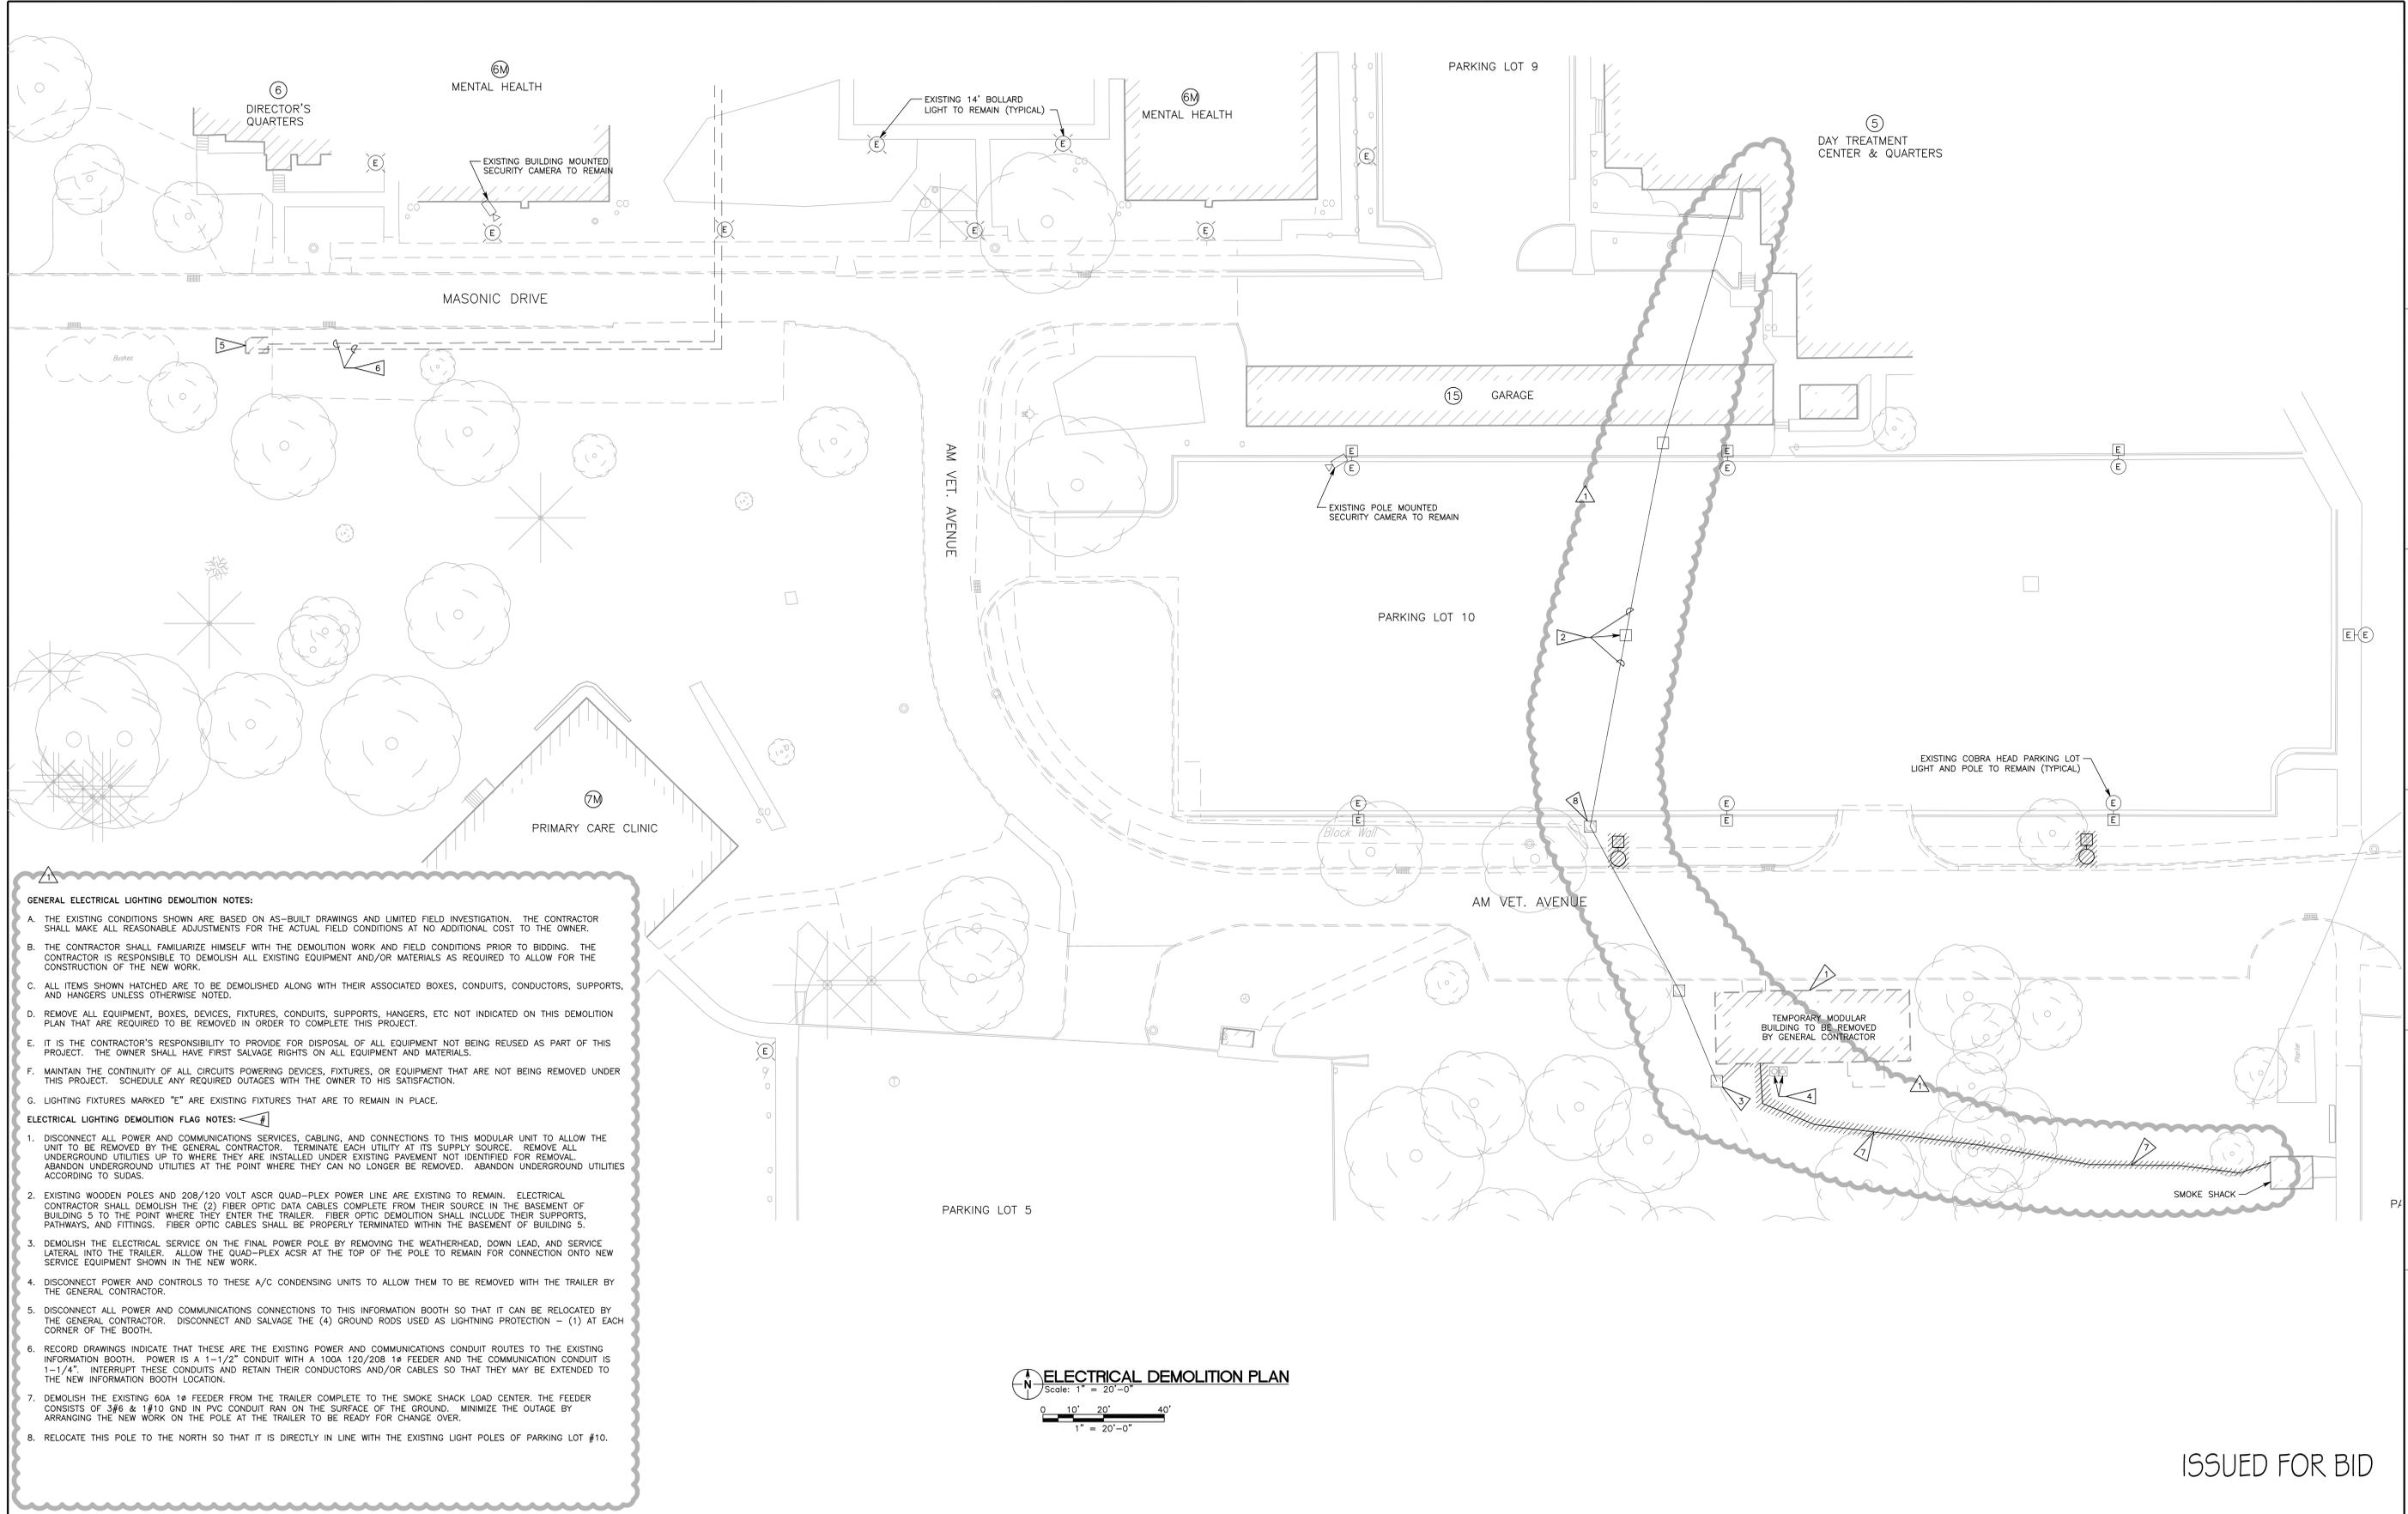

**ELECTRICAL DEMOLITION PLAN**  
 Scale: 1" = 20'-0"  
 0 10' 20' 40'  
 1" = 20'-0"

ISSUED FOR BID

<b>AMENDMENT #1</b> 06/01/2012	<b>CONSULTANTS:</b> LAMP RYNEARSON & ASSOCIATES 14710 West Dodge Road, Suite 100 Omaha, Nebraska 68154-2027 www.LRA-Inc.com 402.496.2498   P 402.496.2730   F	<b>ARCHITECT/ENGINEERS:</b> 21 Delta Engineers, LLC 3824 North 108th Street Omaha, Nebraska 68164 PH: (402) 496-4115 Fax: (402) 493-2744	<b>Drawing Title</b> ELECTRICAL DEMOLITION PLAN	<b>Project Title</b> UPGRADE ROADWAY, PARKING PHASE I	<b>Project Number</b> 636A6-11-301	<b>VACIHCS</b> 3600 30th ST Des Moines, Iowa Department of Veterans Affairs
			<b>Approved COTR</b>	<b>Location</b> DES MOINES VA MEDICAL CENTER	<b>Building Number</b> ED100	
<b>Revisions:</b>	<b>Date</b>	<b>Date</b> MAY 7, 2012	<b>Checked</b> P.J.M.	<b>Drawn</b> T.L.S.	<b>Dwg</b> 22 of 24	