


**ELECTRICAL MANHOLE SURVEY**  
**The JC Cross Corporation**  
**July 26, 2011**  
**PARTIAL DRAWING U-1.3**

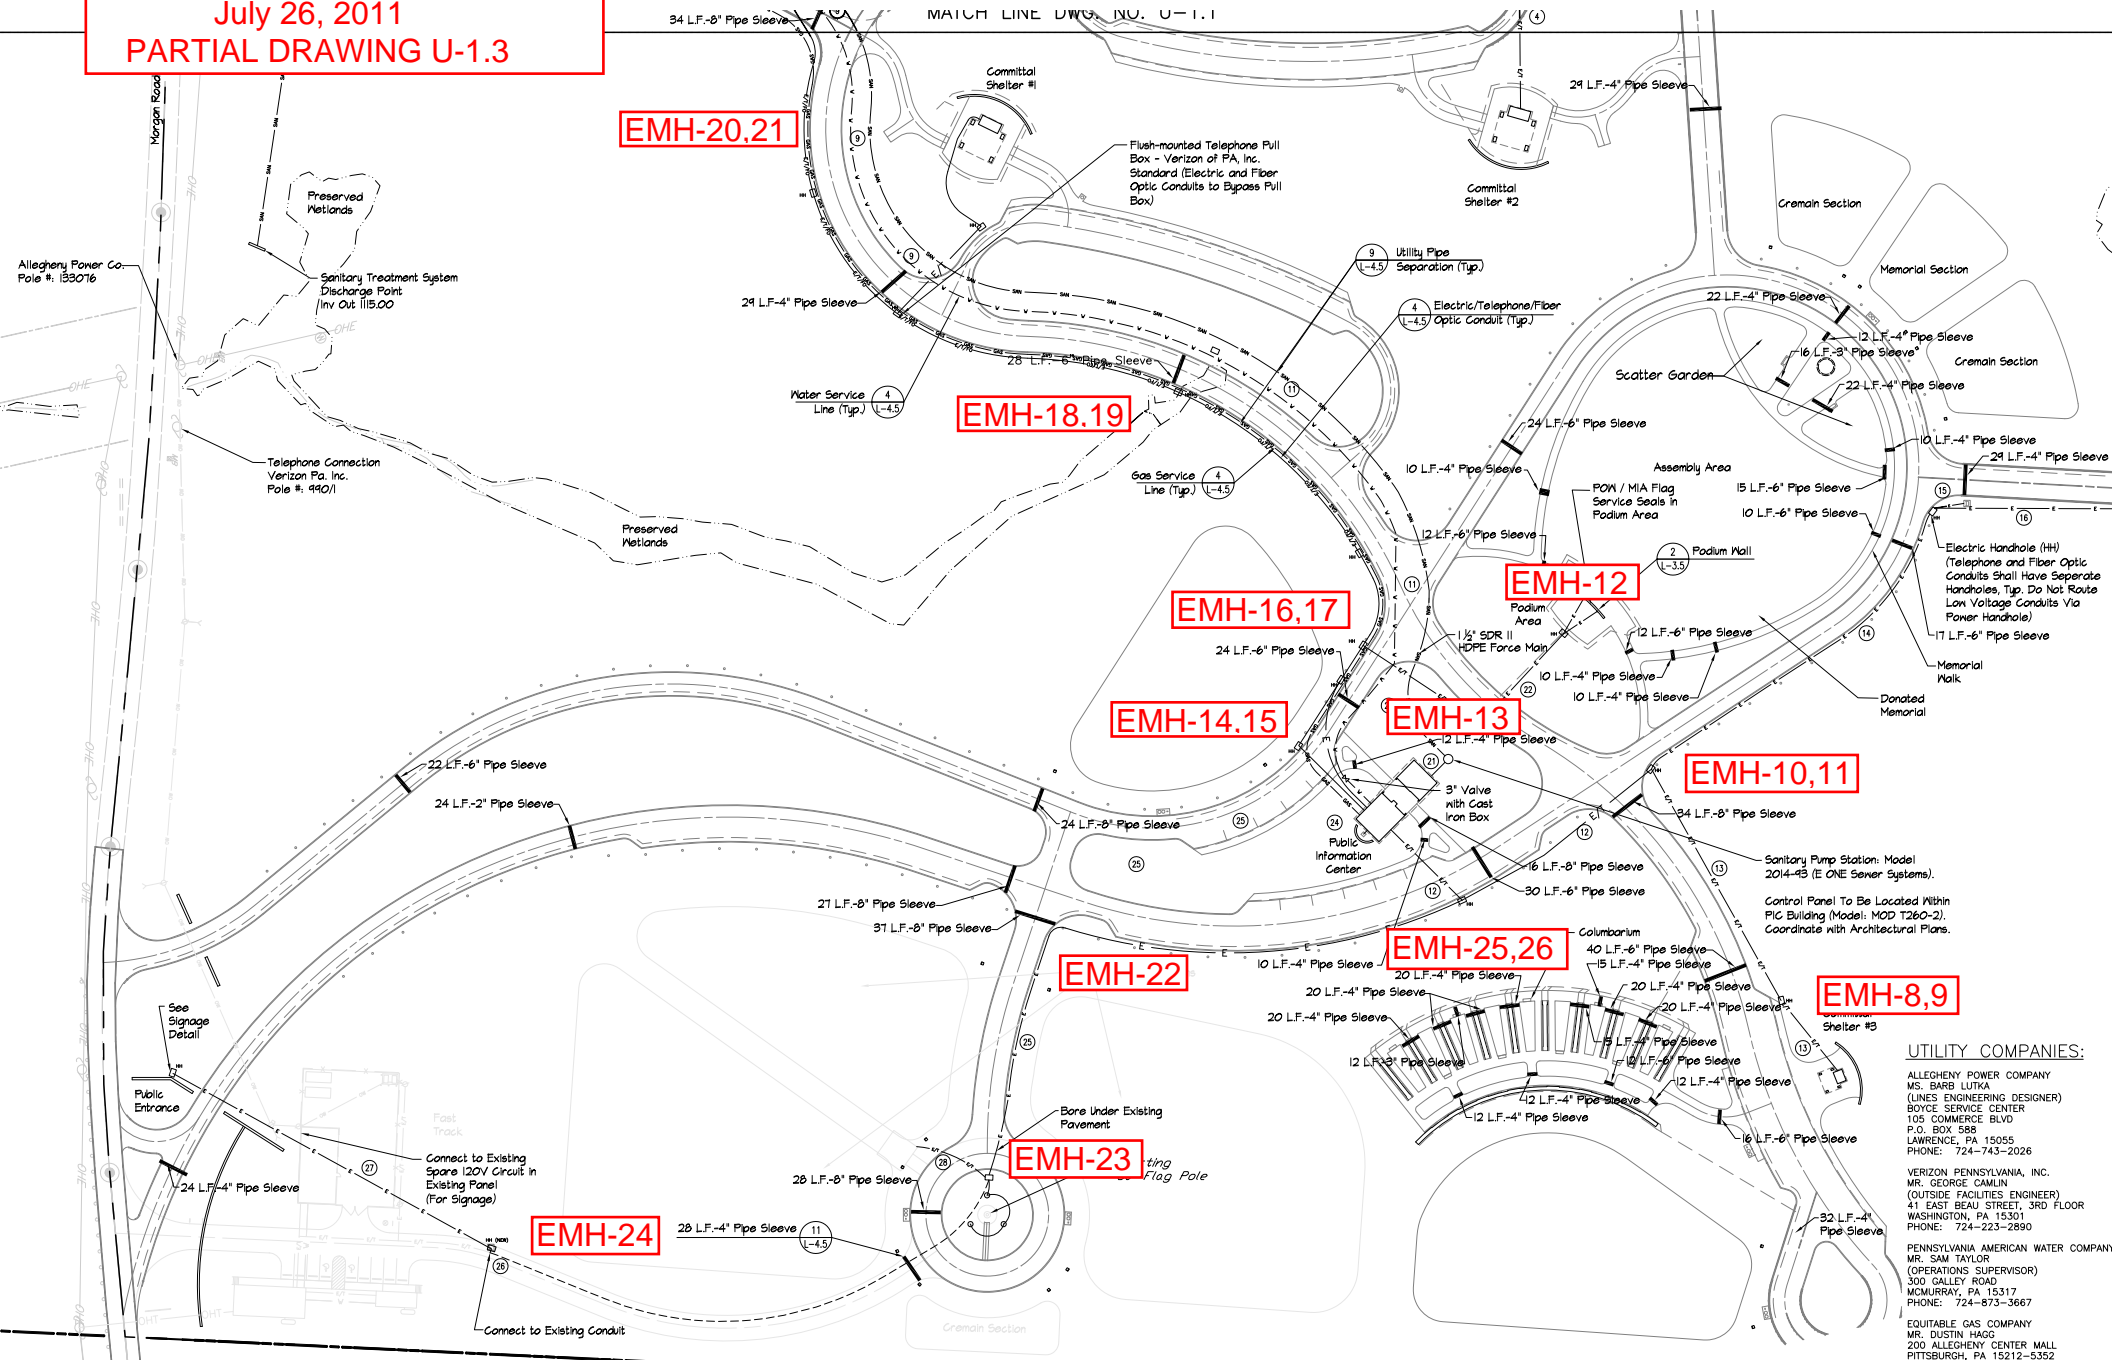

**UTILITY COMPANIES:**

ALLEGHENY POWER COMPANY  
 MS. BARB LUTKA  
 (LINES ENGINEERING DESIGNER)  
 BOYCE SERVICE CENTER  
 105 COMMERCE BLVD  
 P.O. BOX 588  
 LAWRENCE, PA 15055  
 PHONE: 724-743-2026

VERIZON PENNSYLVANIA, INC.  
 MR. GEORGE CAMLIN  
 (OUTSIDE FACILITIES ENGINEER)  
 41 EAST BEAU STREET, 3RD FLOOR  
 WASHINGTON, PA 15301  
 PHONE: 724-223-2890

PENNSYLVANIA AMERICAN WATER COMPANY  
 MR. SAM TAYLOR  
 (OPERATIONS SUPERVISOR)  
 300 GALLEY ROAD  
 MONMURRAY, PA 15317  
 PHONE: 724-873-3667

EQUITABLE GAS COMPANY  
 MR. DUSTIN HAGG  
 200 ALLEGHENY CENTER MALL  
 PITTSBURGH, PA 15212-5352