ELECTRICAL MANHOLE SURVEY
The JC Cross Corporation
July 26, 2011
PARTIAL DRAWING U-1.1
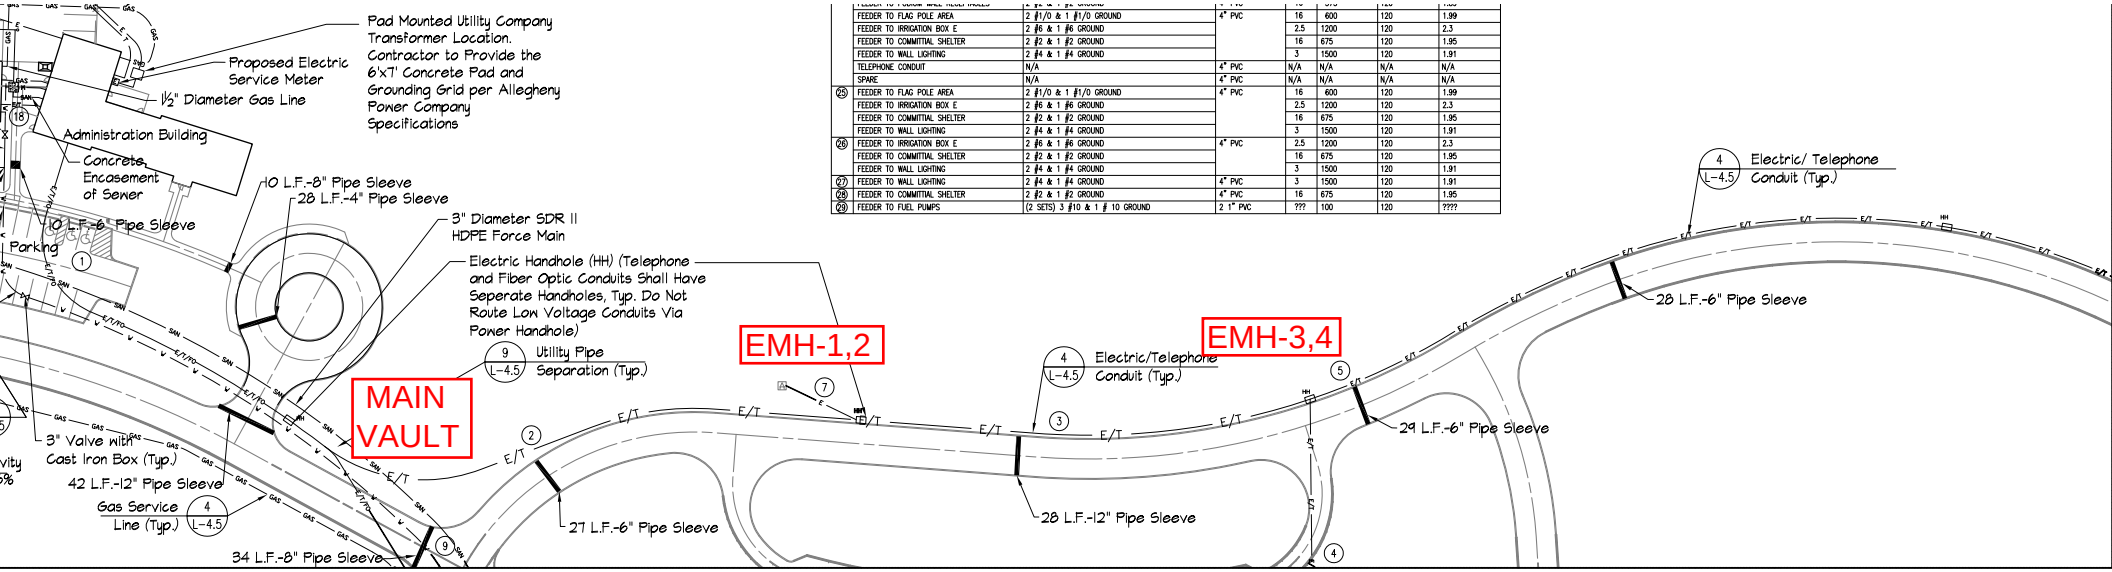
	FEEDER TO FLAG POLE AREA	2 #1/0 & 1 #1/0 GROUND	4" PVC	16	600	120	1.99
	FEEDER TO IRRIGATION BOX E	2 #6 & 1 #6 GROUND		2.5	1200	120	2.3
	FEEDER TO COMMITTIAL SHELTER	2 #2 & 1 #2 GROUND		16	675	120	1.95
	FEEDER TO WALL LIGHTING	2 #4 & 1 #4 GROUND		3	1500	120	1.91
	TELEPHONE CONDUIT	N/A	4" PVC	N/A	N/A	N/A	N/A
	SPARE	N/A	4" PVC	N/A	N/A	N/A	N/A
25	FEEDER TO FLAG POLE AREA	2 #1/0 & 1 #1/0 GROUND	4" PVC	16	600	120	1.99
	FEEDER TO IRRIGATION BOX E	2 #6 & 1 #6 GROUND		2.5	1200	120	2.3
	FEEDER TO COMMITTIAL SHELTER	2 #2 & 1 #2 GROUND		16	675	120	1.95
	FEEDER TO WALL LIGHTING	2 #4 & 1 #4 GROUND		3	1500	120	1.91
26	FEEDER TO IRRIGATION BOX E	2 #6 & 1 #6 GROUND	4" PVC	2.5	1200	120	2.3
	FEEDER TO COMMITTIAL SHELTER	2 #2 & 1 #2 GROUND		16	675	120	1.95
	FEEDER TO WALL LIGHTING	2 #4 & 1 #4 GROUND		3	1500	120	1.91
27	FEEDER TO WALL LIGHTING	2 #4 & 1 #4 GROUND	4" PVC	3	1500	120	1.91
28	FEEDER TO COMMITTIAL SHELTER	2 #2 & 1 #2 GROUND	4" PVC	16	675	120	1.95
29	FEEDER TO FUEL PUMPS	(2 SETS) 3 #10 & 1 # 10 GROUND	2 1" PVC	???	100	120	????