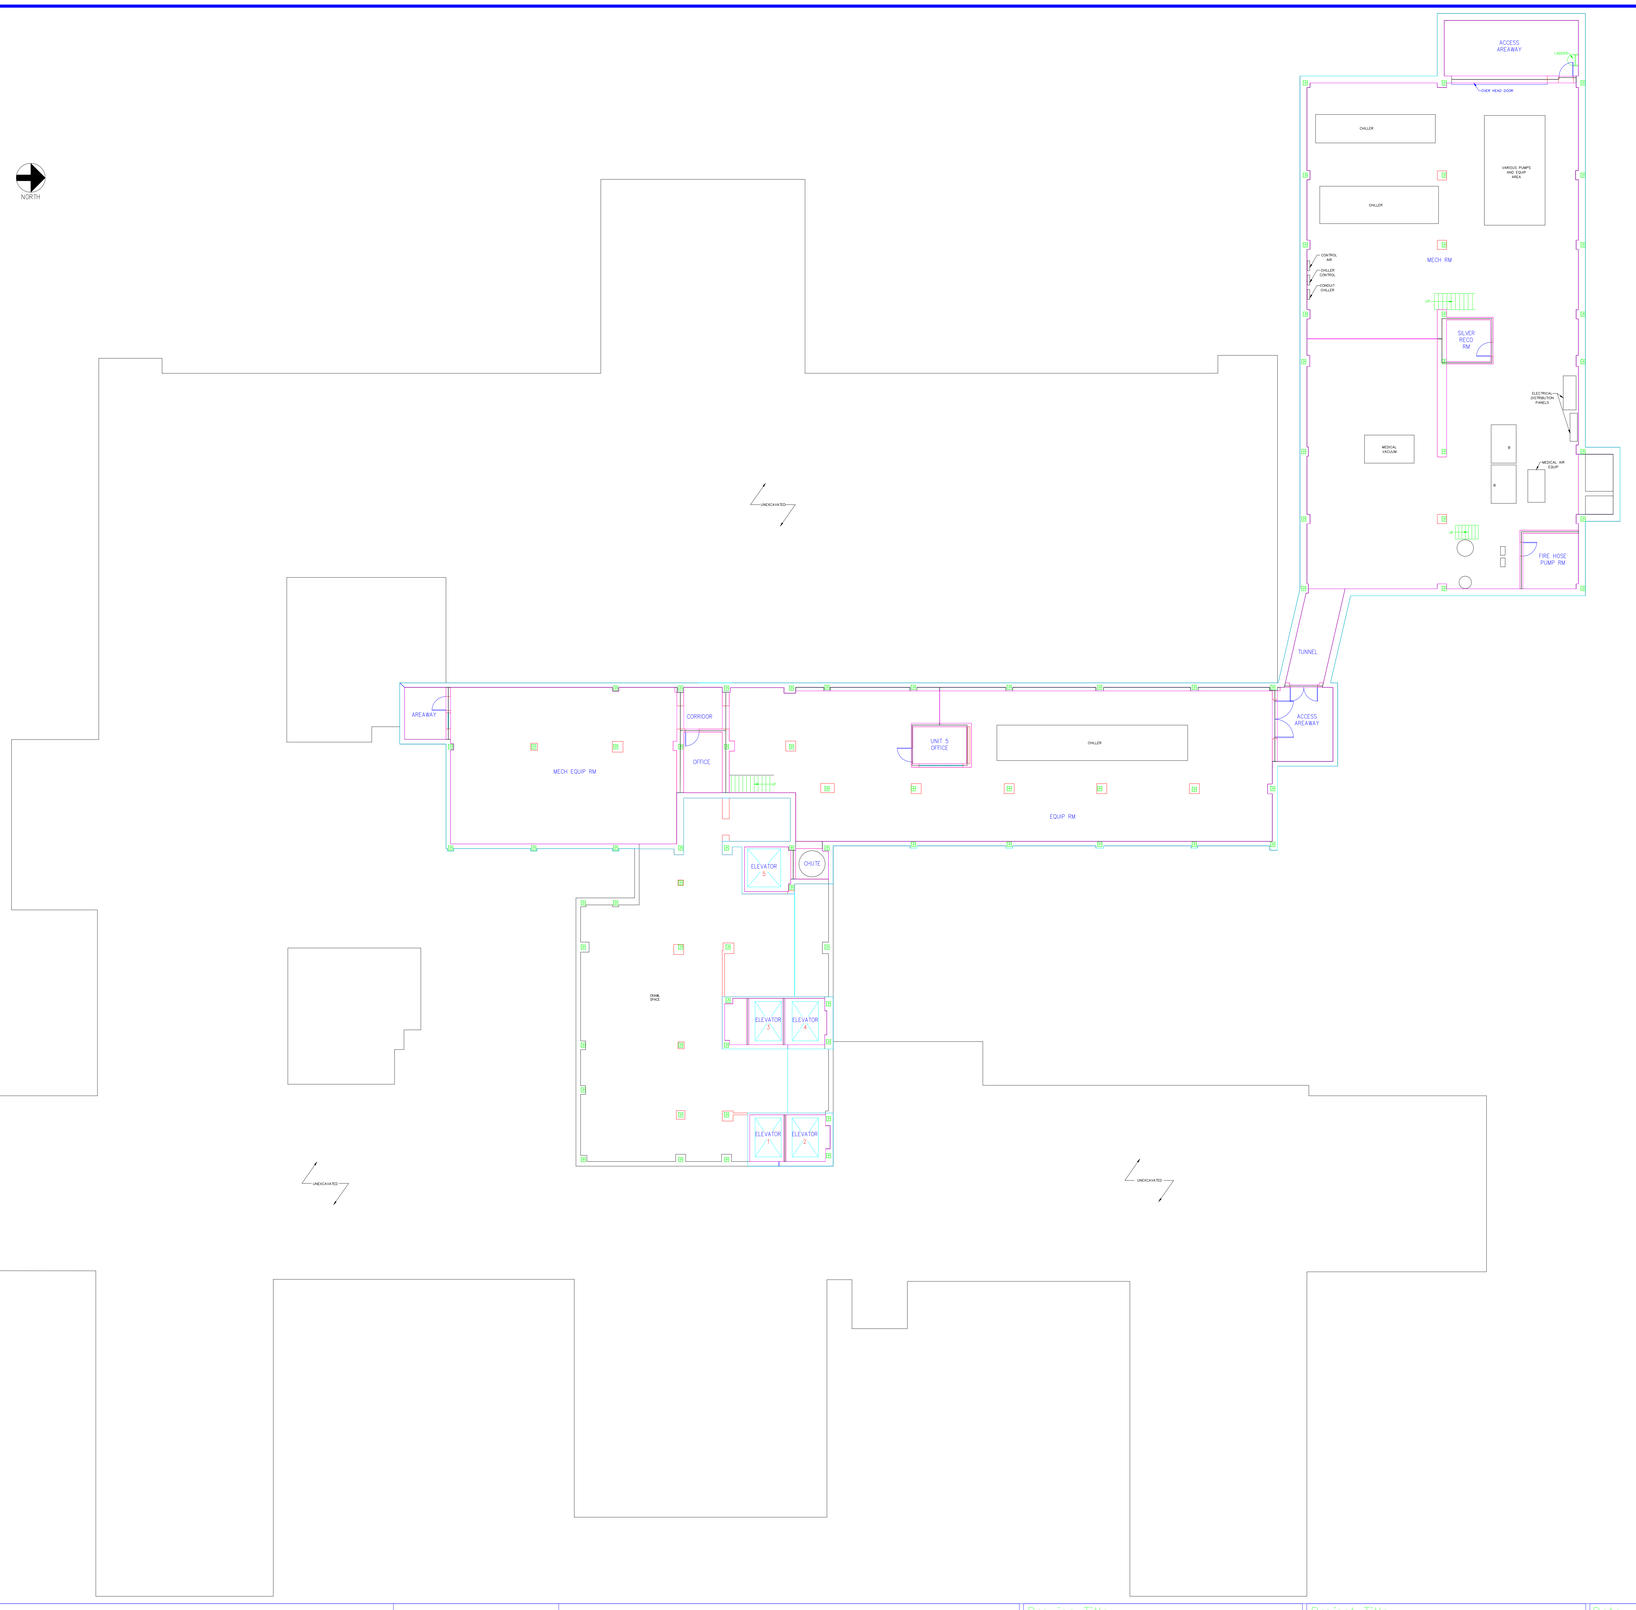

Revisions | Date

Professional Seal

Indus Systems, Inc.
2352, Main Street, Concord MA 01742
Tel: 978-461-0555
www.indus-systems.com

Drawing Title: SUB BASEMENT FLOOR ARCHITECTURAL	Project Title: AS-BUILT Drawings		Date: 11-30-2010
			Project No.
Approved:	Building Number: 01	Checked	Drawn
Approved:	Location: VAMC BIRMINGHAM		Drawing No.

VAMC, BIRMINGHAM

VA Department of Veterans Affairs

VA FORM 08-6231, OCT 1978