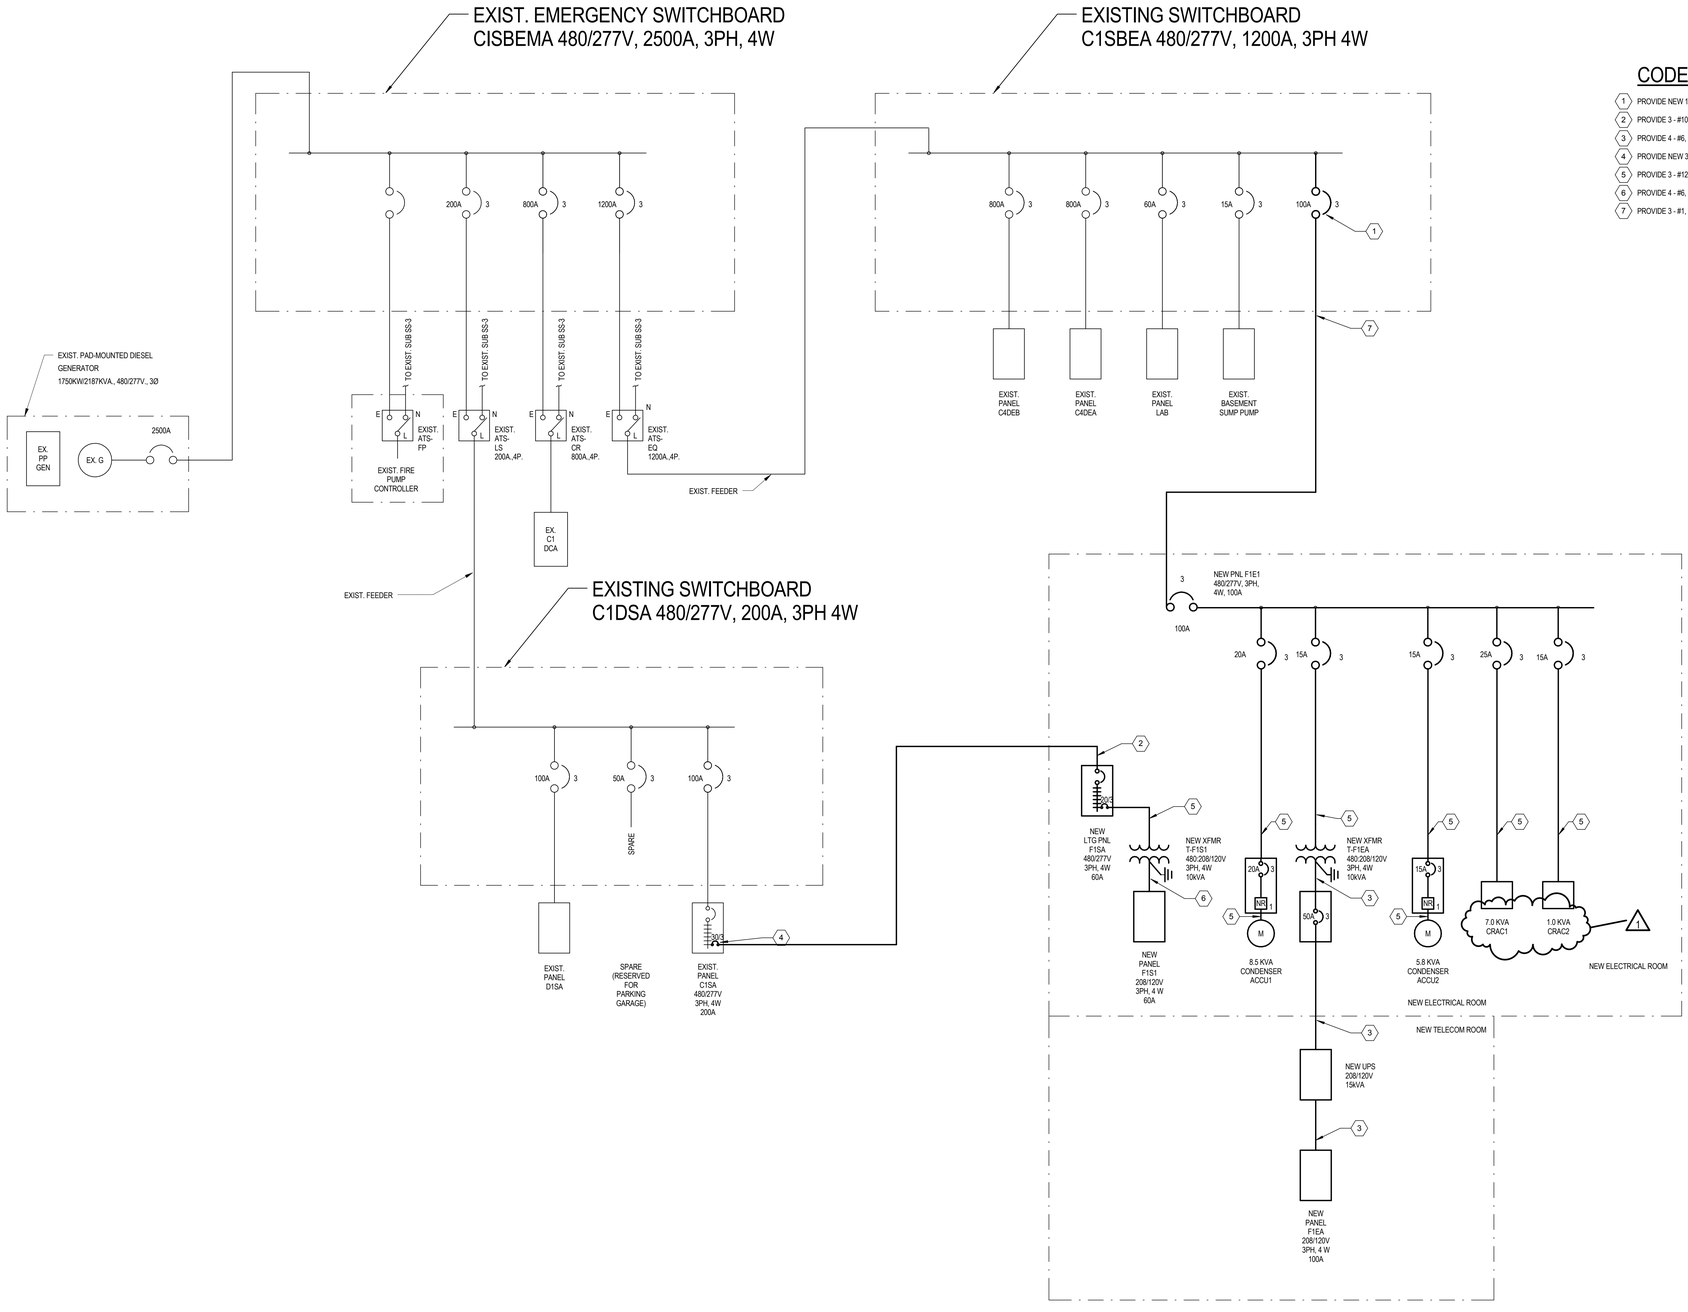

CODED NOTES

1. PROVIDE NEW 100A/3P CIRCUIT BREAKER.
2. PROVIDE 3 - #10, 1 - #10 GRD IN 1" CONDUIT.
3. PROVIDE 4 - #6, 1 - #10 GRD IN 1.25" CONDUIT.
4. PROVIDE NEW 30A/3P CIRCUIT BREAKER IN EXISTING PANEL.
5. PROVIDE 3 - #12, 1 - #12 GRD IN .75" CONDUIT.
6. PROVIDE 4 - #6, 1 - #10 GRD IN 1" CONDUIT.
7. PROVIDE 3 - #1, 1 - #8 GRD IN 1.25" CONDUIT.

1 EXISTING EMERGENCY POWER SINGLE LINE DIAGRAM
Scale: None

ADDENDUM 1	2017.06.05
Revisions:	Date

C:\Revit\Local\15.1021.06_Columbus VA_BH_Elec_tim.suk.rvt

U.S. Department of Veterans Affairs

CHALMERS P. WYLIE VA AMBULATORY CARE CENTER
420 N JAMES ROAD, COLUMBUS, OH 43219

STATE OF OHIO
BRIAN JAMES WALKER
E-61832
REGISTERED
PROFESSIONAL ENGINEER
12/23/2016

ARCHITECT/ENGINEERS:

PROJECT LEAD
Architect, Structural Engineer, Civil Engineer
GUIDON DESIGN
GUIDON DESIGN INC.
905 N. CAPITOL AVE., SUITE 100 | INDIANAPOLIS, IN 46204
317.800.6388 | WWW.GUIDONDESIGN.COM
SUSTAINABLE ARCHITECTURE + ENGINEERING

MEP Engineer
AECOM
277 W. NATIONWIDE BLVD
COLUMBUS, OH 43215

BID SET

Drawing Title: EXISTING EMERGENCY POWER SINGLE LINE DIAGRAM	Project Title: CONSTRUCT MENTAL HEALTH AND SPECIALTY CARE ADDITION	VA Project Number: 757-202	
		Building Number: 1A	
Approved for Design Concept: FARID MEHR, CHIEF ENGINEER	Location: CHALMERS P. WYLIE VAAMC	Drawing Number: EE702	
	Date: 23 DEC 2016 / Checked By: RA / Drawn By: BW		

Columbus VA
Chalmers P. Wylie Ambulatory Care Center