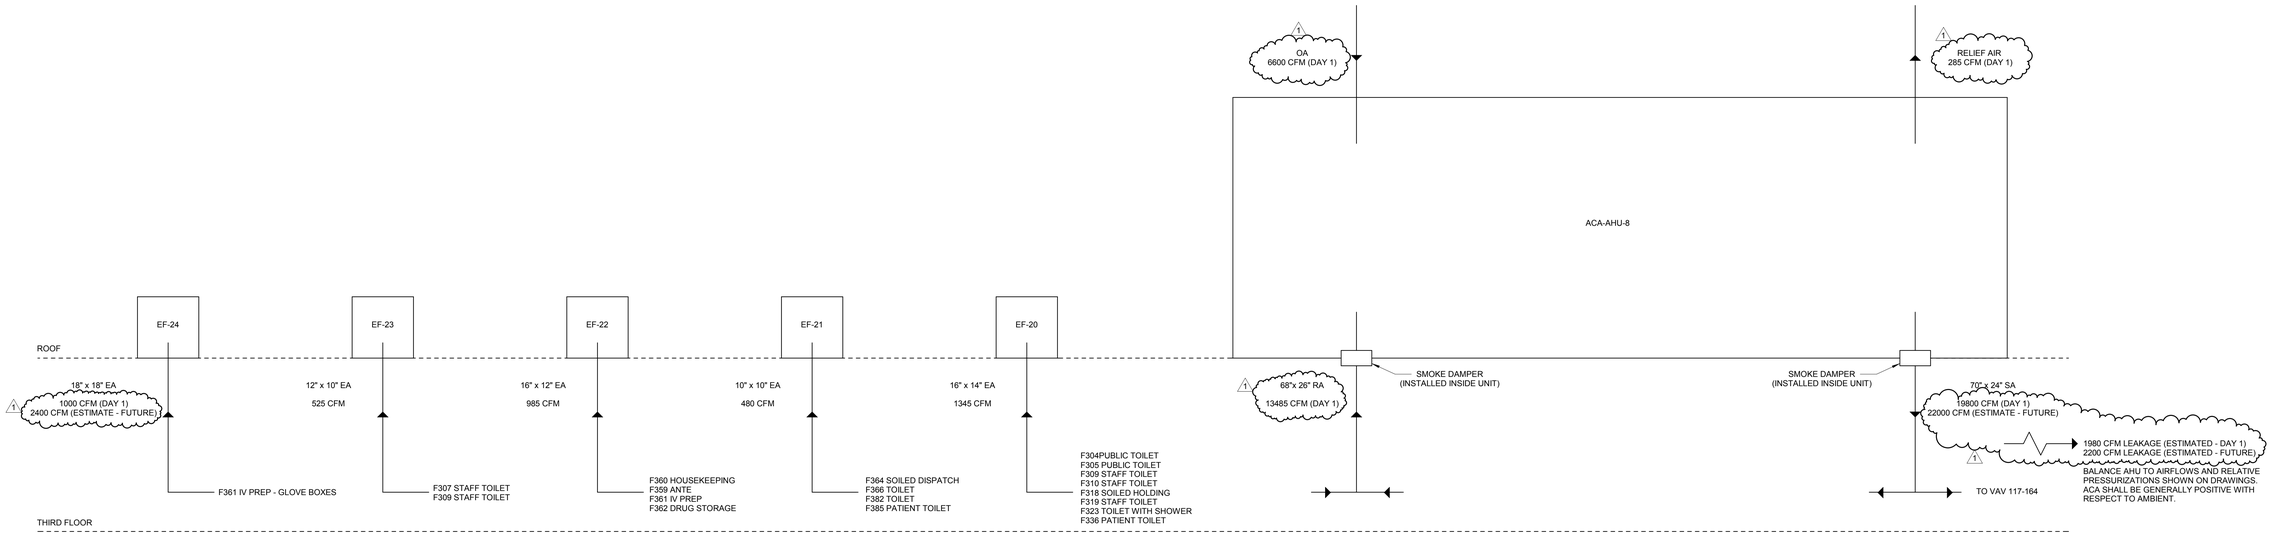

4C SCHEMATIC AIRFLOW DIAGRAM ACA-AHU-8

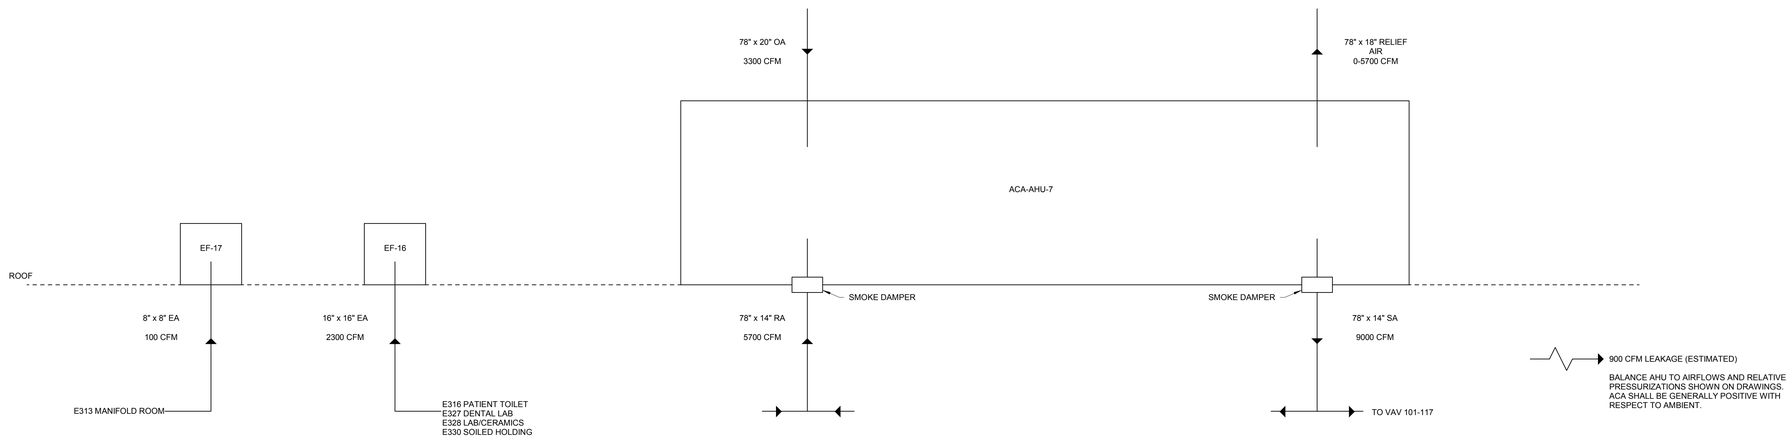

NOTES:

1. REBALANCE ACA-AHU-7.

4F SCHEMATIC AIRFLOW DIAGRAM ACA-AHU-7 (EXISTING)

100% CONSTRUCTION DOCUMENTS - ISSUE FOR BID

1	Addendum 01	06/01/17
Revisions:		Date

CONSULTANTS:

AcoustiControl
Acoustical Engineer
2464 Taylor Road
Suite 214
Wildwood, MO 63040
314.436.9770

The Schachinger Group
Elevator
4255 Stoney Creek Drive
Fort Collins, CO 80525
703.608.2263

STATE OF MISSOURI
NATALIE R. PETZOLDT
NUMBER A-2003002660
ARCHITECT
12/15/17

ARCHITECT/ENGINEERS:

CANNONDESIGN

1100 Clark Avenue
St. Louis, Missouri 63102
T: 314.241.6250
F: 314.241.2570

© CannonDesign 2017
All rights reserved. No part of this document may be reproduced or utilized in any form, without prior written authorization by the Cannon Corporation

Drawing Title: **SCHEMATIC AIRFLOW DIAGRAM**

Approved: Project Director

Project Title: **Harry S. Truman Memorial Veterans' Hospital Expand Ambulatory Care Addition**

Location: Columbia, Missouri

Date: JANUARY 13, 2017 | Checked: MEM | Drawn: BME

Project Number: 589-333
CANNON DESIGN PROJECT NO. 3850.06

Building Number

Drawing Number: **MH-401.2**
Dwg. of

Office of Construction and Facilities Management
Department of Veterans Affairs

VA FORM 08-6231

© Cannon Design 2016