


ACM REMOVAL ACTIVITIES
BUILDING 1 – HISTORICAL LOBBY AND ROOM 130

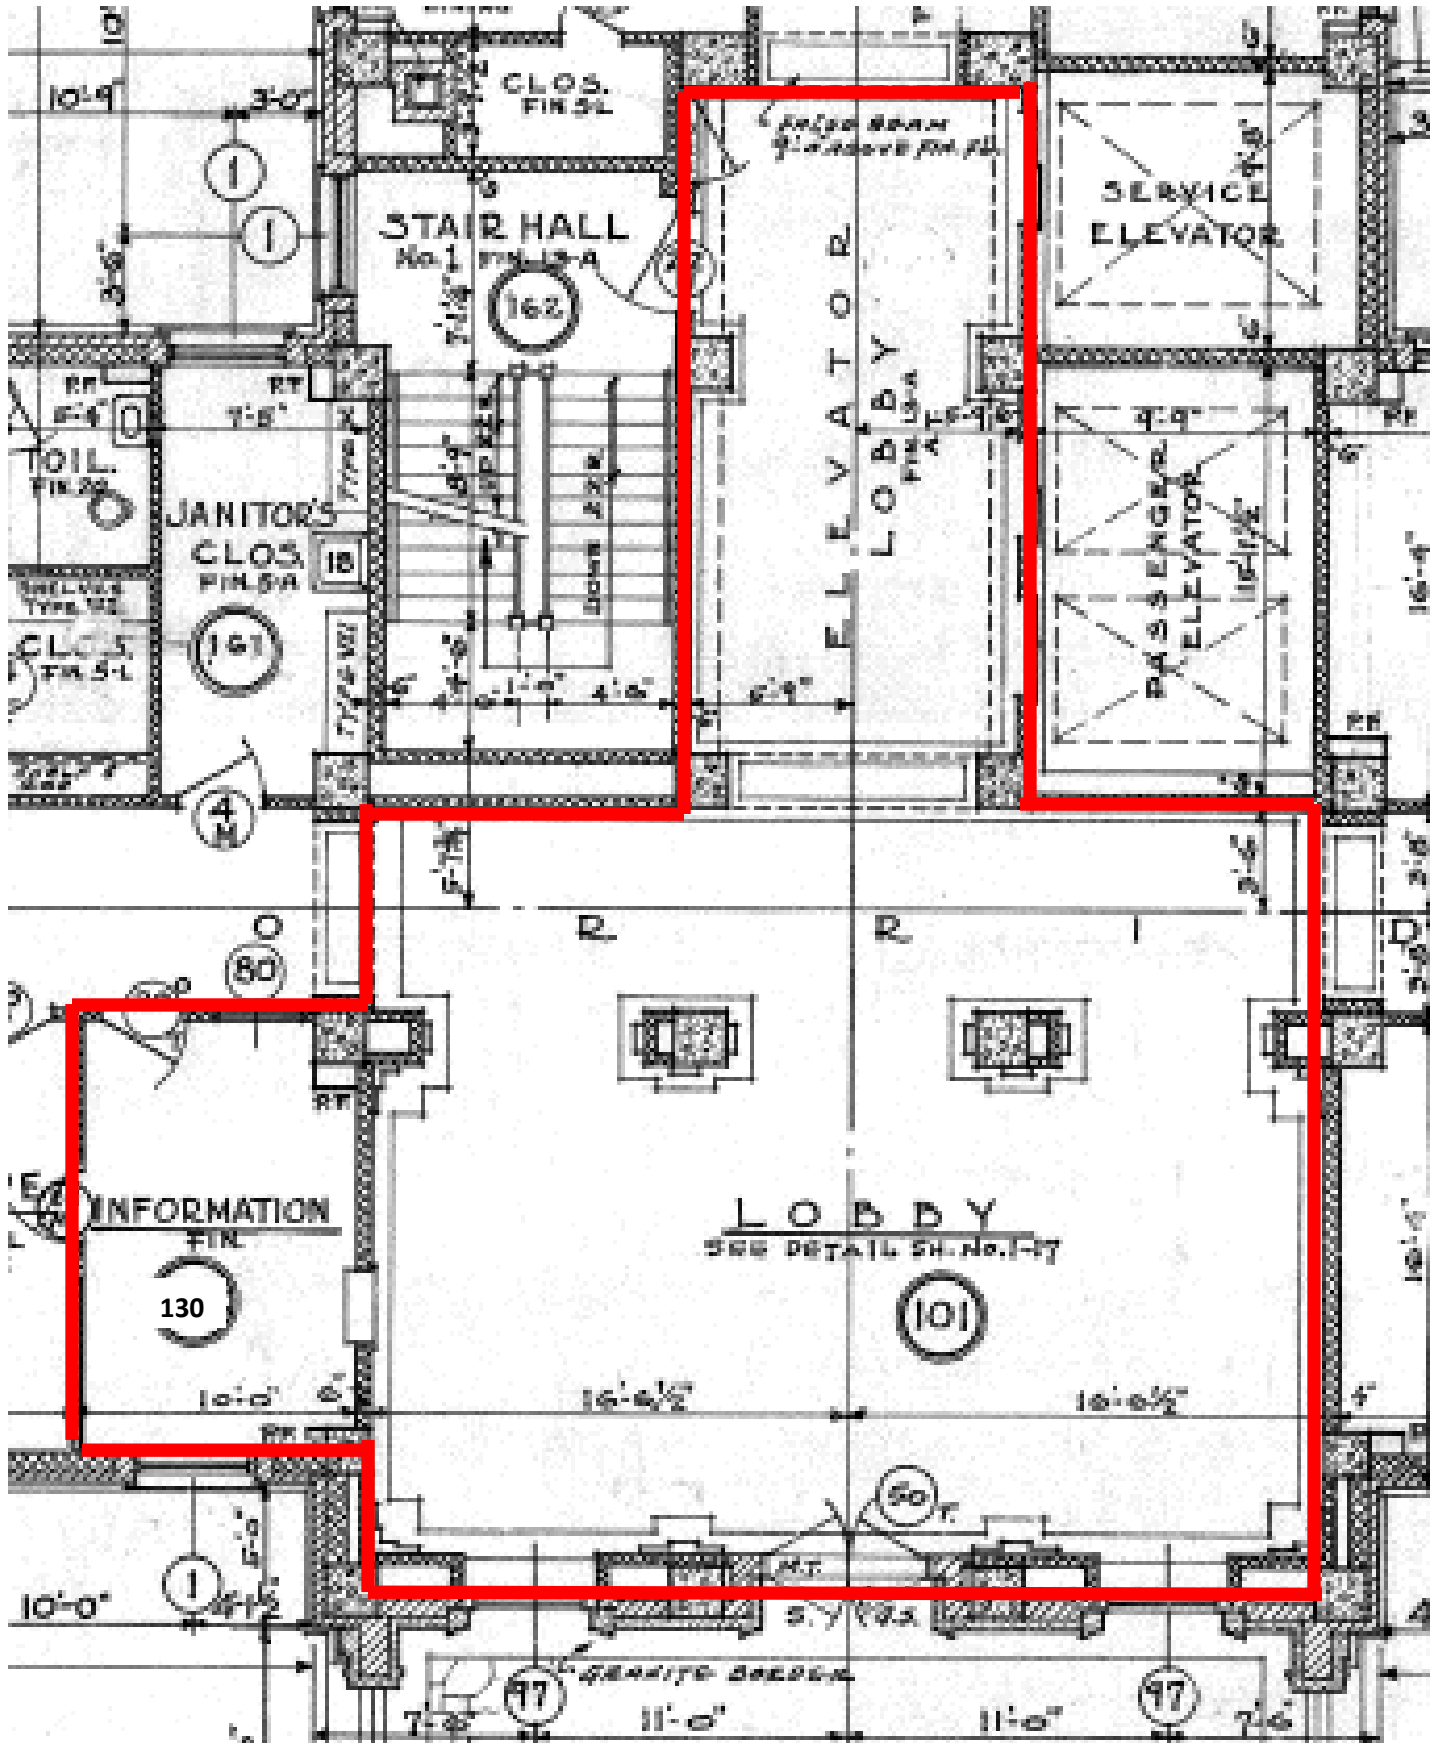

WORK AREA BOUNDARIES