



CSO Architects

PROJECT NAME
PROJECT NO.

MARION VA MEDICAL CENTER, INDIANA
11078


DATE
DWG #
DRAWN BY

06-01-12

1/A101

NW

SUPPLEMENTAL DRAWING

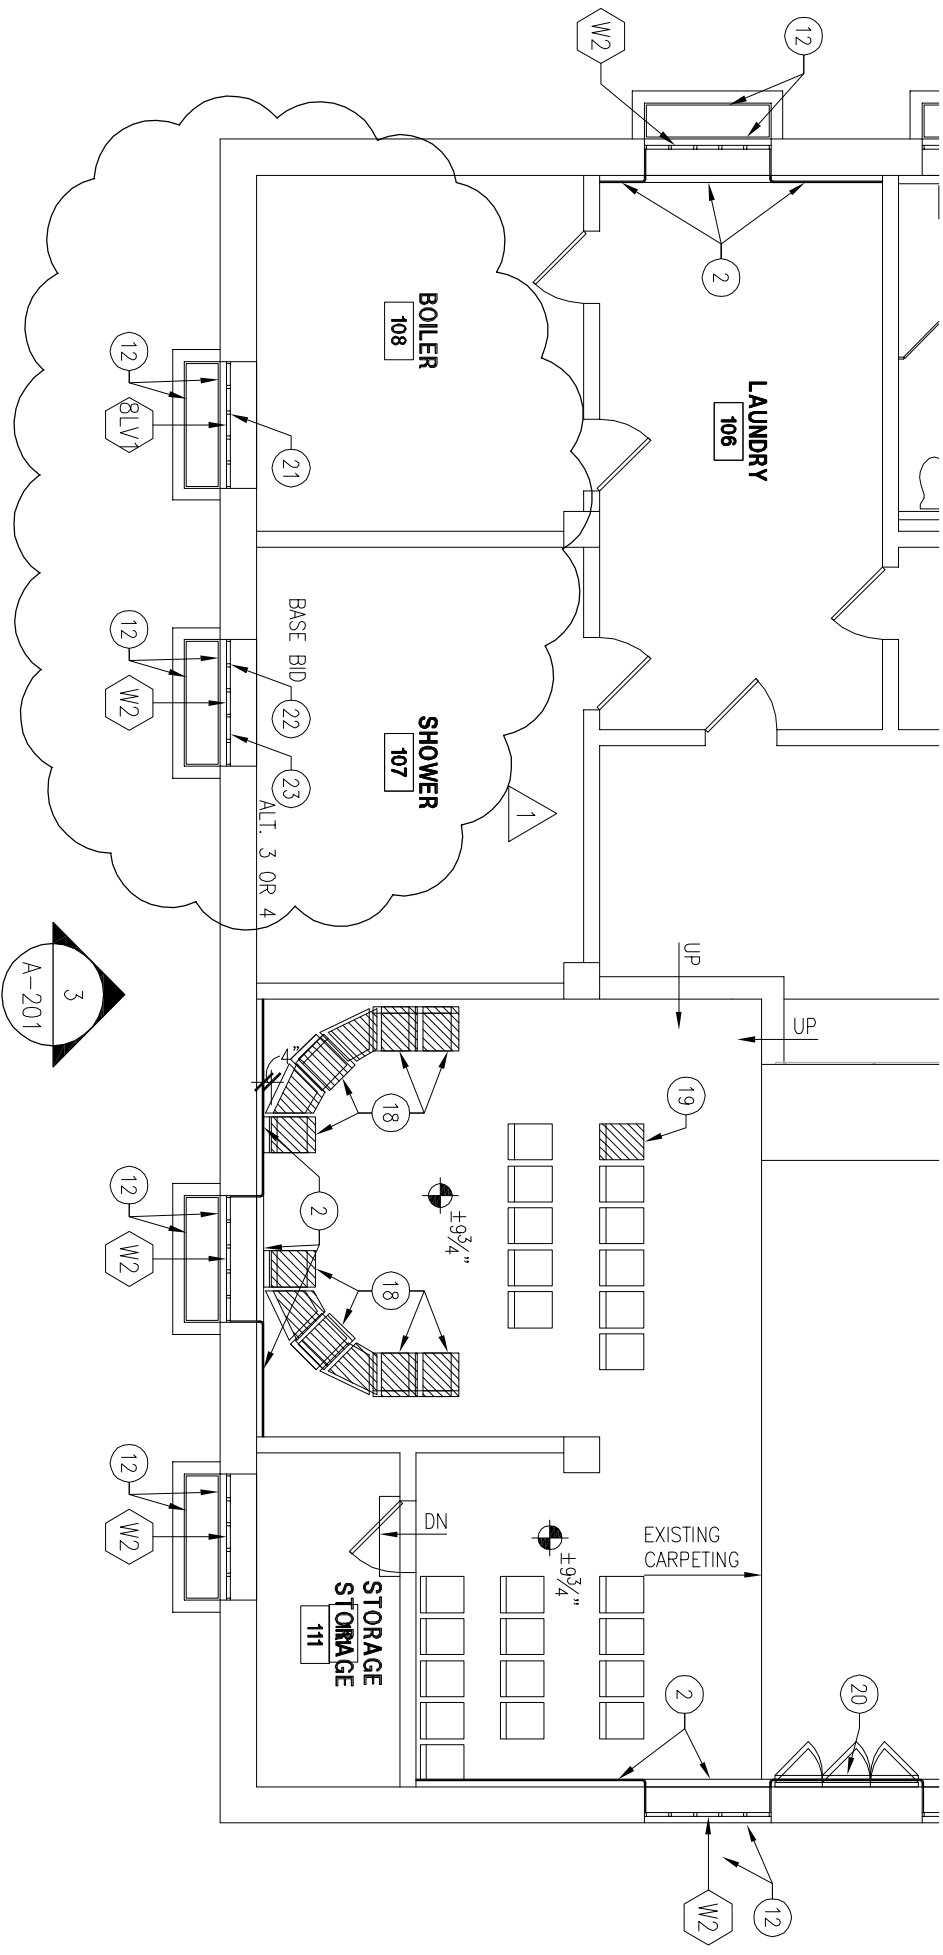

NEW LOWER LEVEL FLOOR PLAN

A-101

SCALE: 1/8" = 1'-0"

