



CSO Architects

PROJECT NAME
PROJECT NO.

MARION VA MEDICAL CENTER, INDIANA


11078

DATE 06-01-12

DWG # 1/A101

DRAWN BY NW


SUPPLEMENTAL DRAWING

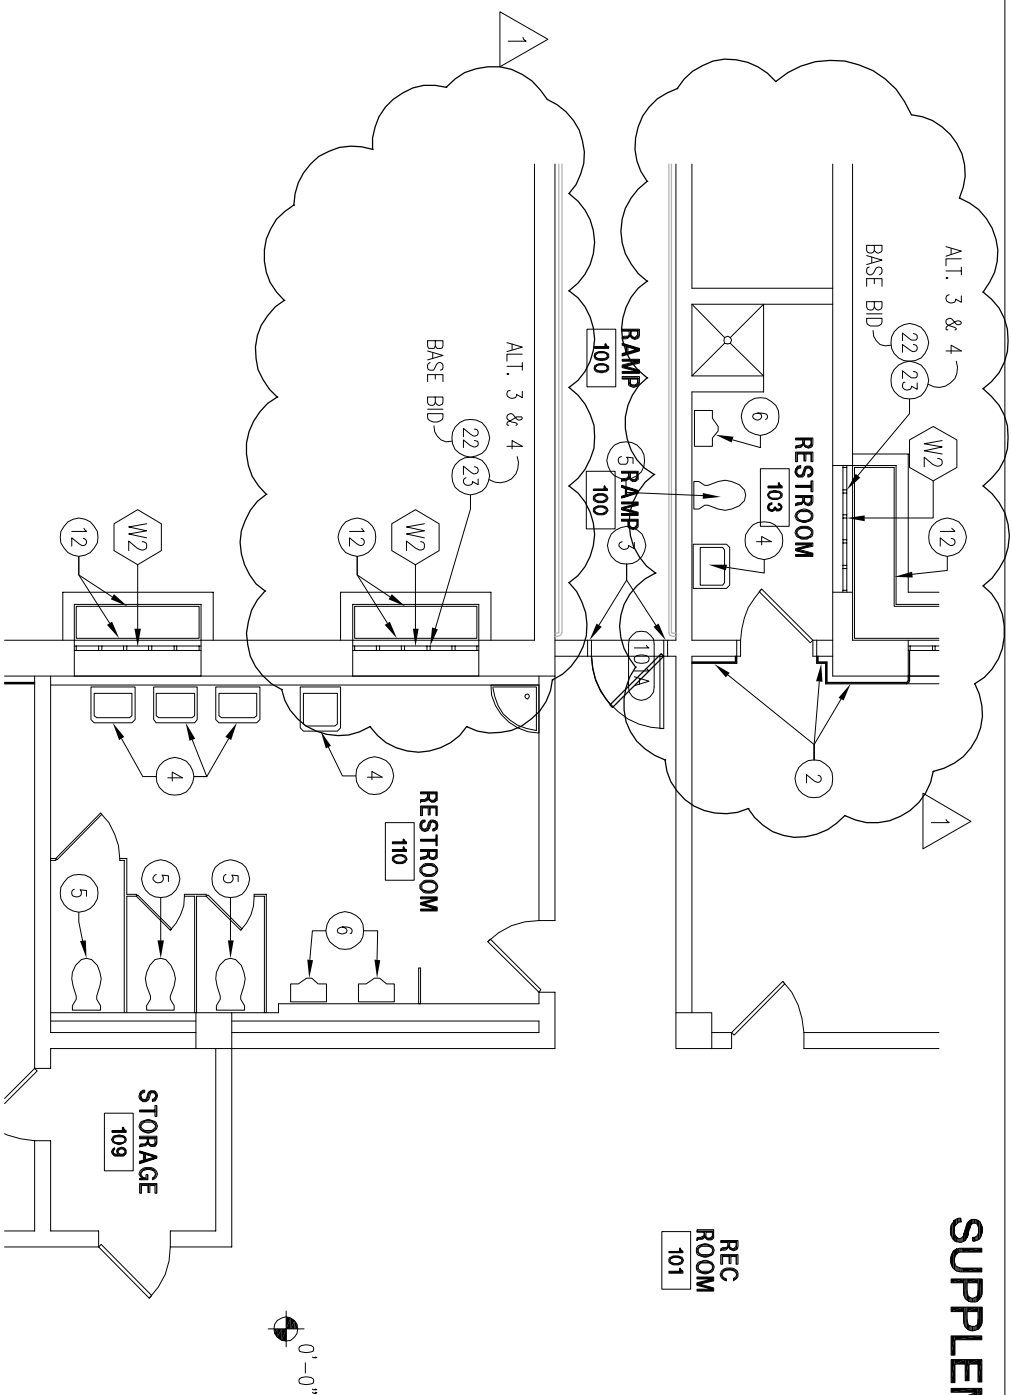

NEW LOWER LEVEL FLOOR PLAN

1
A-101

SCALE: 1/8" = 1'-0"

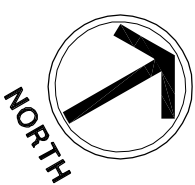

ARCHITECTURE • INTERIOR DESIGN

8831 Keystone Crossing • Indianapolis, IN 46240 • Main 317.848.7800 • Fax 317.574.0957 • csoinc.net