GENERAL SHEET NOTES

A. FOR WALL ASSEMBLIES SEE SHEET A6.0

B. ROOM FINISH SCHEDULE IN SPECIFICATION SECTION 09 06 00

C. DOOR SCHEDULE ON A8.0

D. FRAME TYPES ON A8.0

E. WHERE PARTITIONS ARE AT CORNERS OF COLUMN FURRING, LOCATE WALL STUDS SO THAT GYPSUM BOARD IS FLUSH WITH GYPSUM BOARD AT COLUMN

F. PROVIDE BACKING IN WALLS FOR WALL MOUNTED ITEMS WHEN INDICATED

G. FIELD ADJUST WALL ASSEMBLY THICKNESS AS NECESSARY TO MATCH THAT OF ADJACENT WALLS

H. PATCH AND REPAIR WALL, BASE, & CEILING AS NECESSARY TO ACCOMMODATE NEW CONSTRUCTION. NEW FINISHES TO MATCH ADJACENT SURFACES

I. PIPING ROUGH-IN STUB-UPS ARE TO BE AT CENTERLINE OF WALLS.

REFLECTED CEILING PLAN LEGEND

- 2 X 2 RECESSED LED LIGHT
- WM — WALL MOUNTED LED LIGHT FIXTURE
- HF — HANGING LED LIGHT FIXTURE
- LED LIGHT–CEILING MOUNTED
- FS — FIRE SPRINKLER
- S — SMOKE DETECTOR
- 2x4 SUSPENDED CEILING GRID
- WD–2 SUSPENDED CEILING
- GYPSUM BOARD CEILING
- EXIT SIGN
- X'–X" — CEILING HEIGHT

KEYNOTES

1 PAINT CEILING STRUCTURE, PIPE AND CONDUIT P–2. REMOVE ALL UNUSED WIRE CONDUIT AND PIPE. LOOSE WIRE TO BE PLACED IN NEW CONDUIT

2 MAIN PIPING RUNS TO BE ABOVE SUSPENDED CEILING WHEN POSSIBLE

3 RELOCATE FIXTURE CURRENTLY IN SPACE TO THIS NEW LOCATION, SEE E2.2

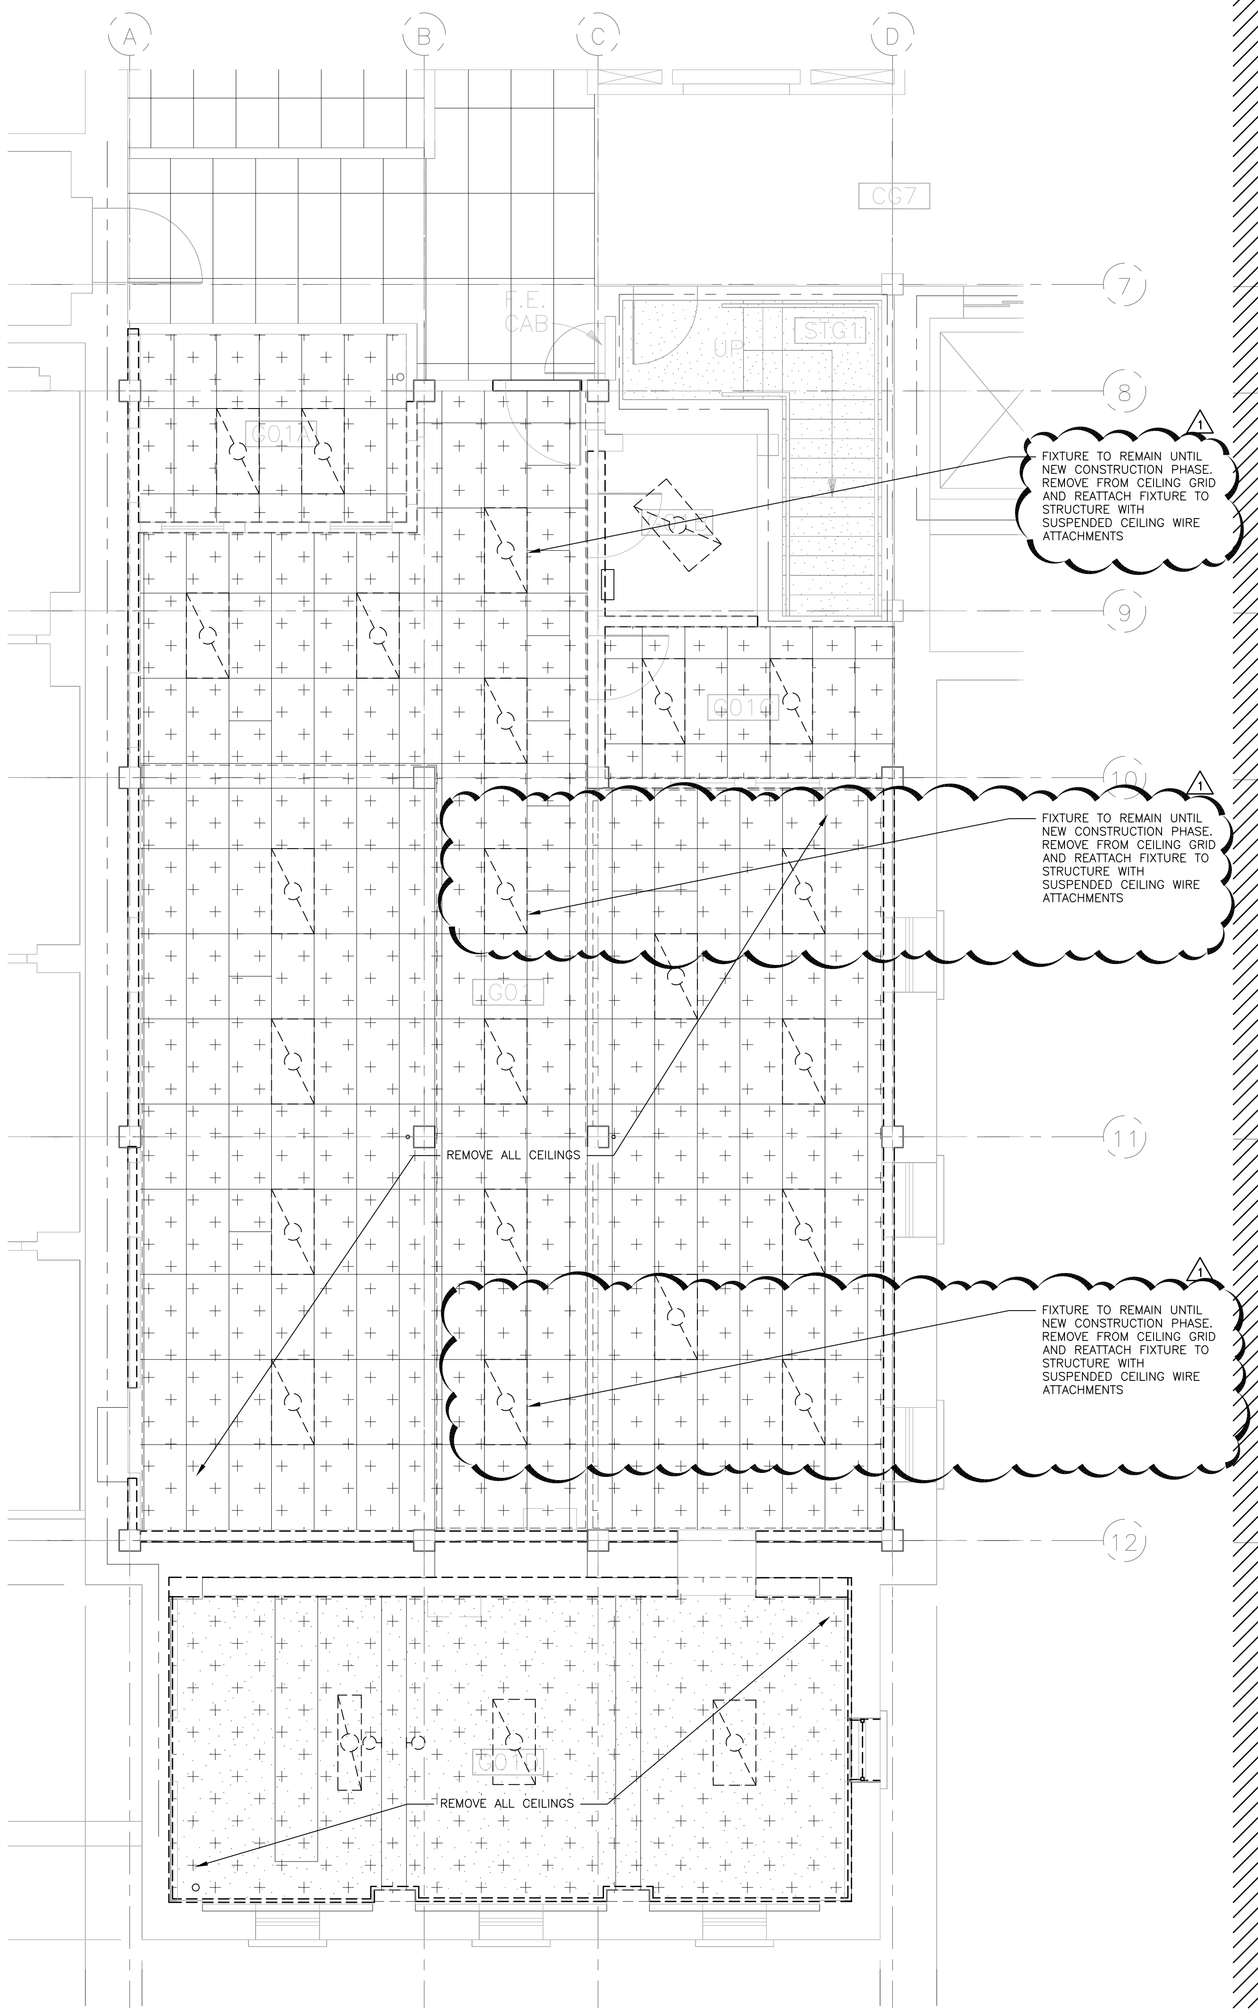

1 GROUND LEVEL REFLECTED CEILING PLAN DEMO
SCALE: 1/4" = 1'–0"

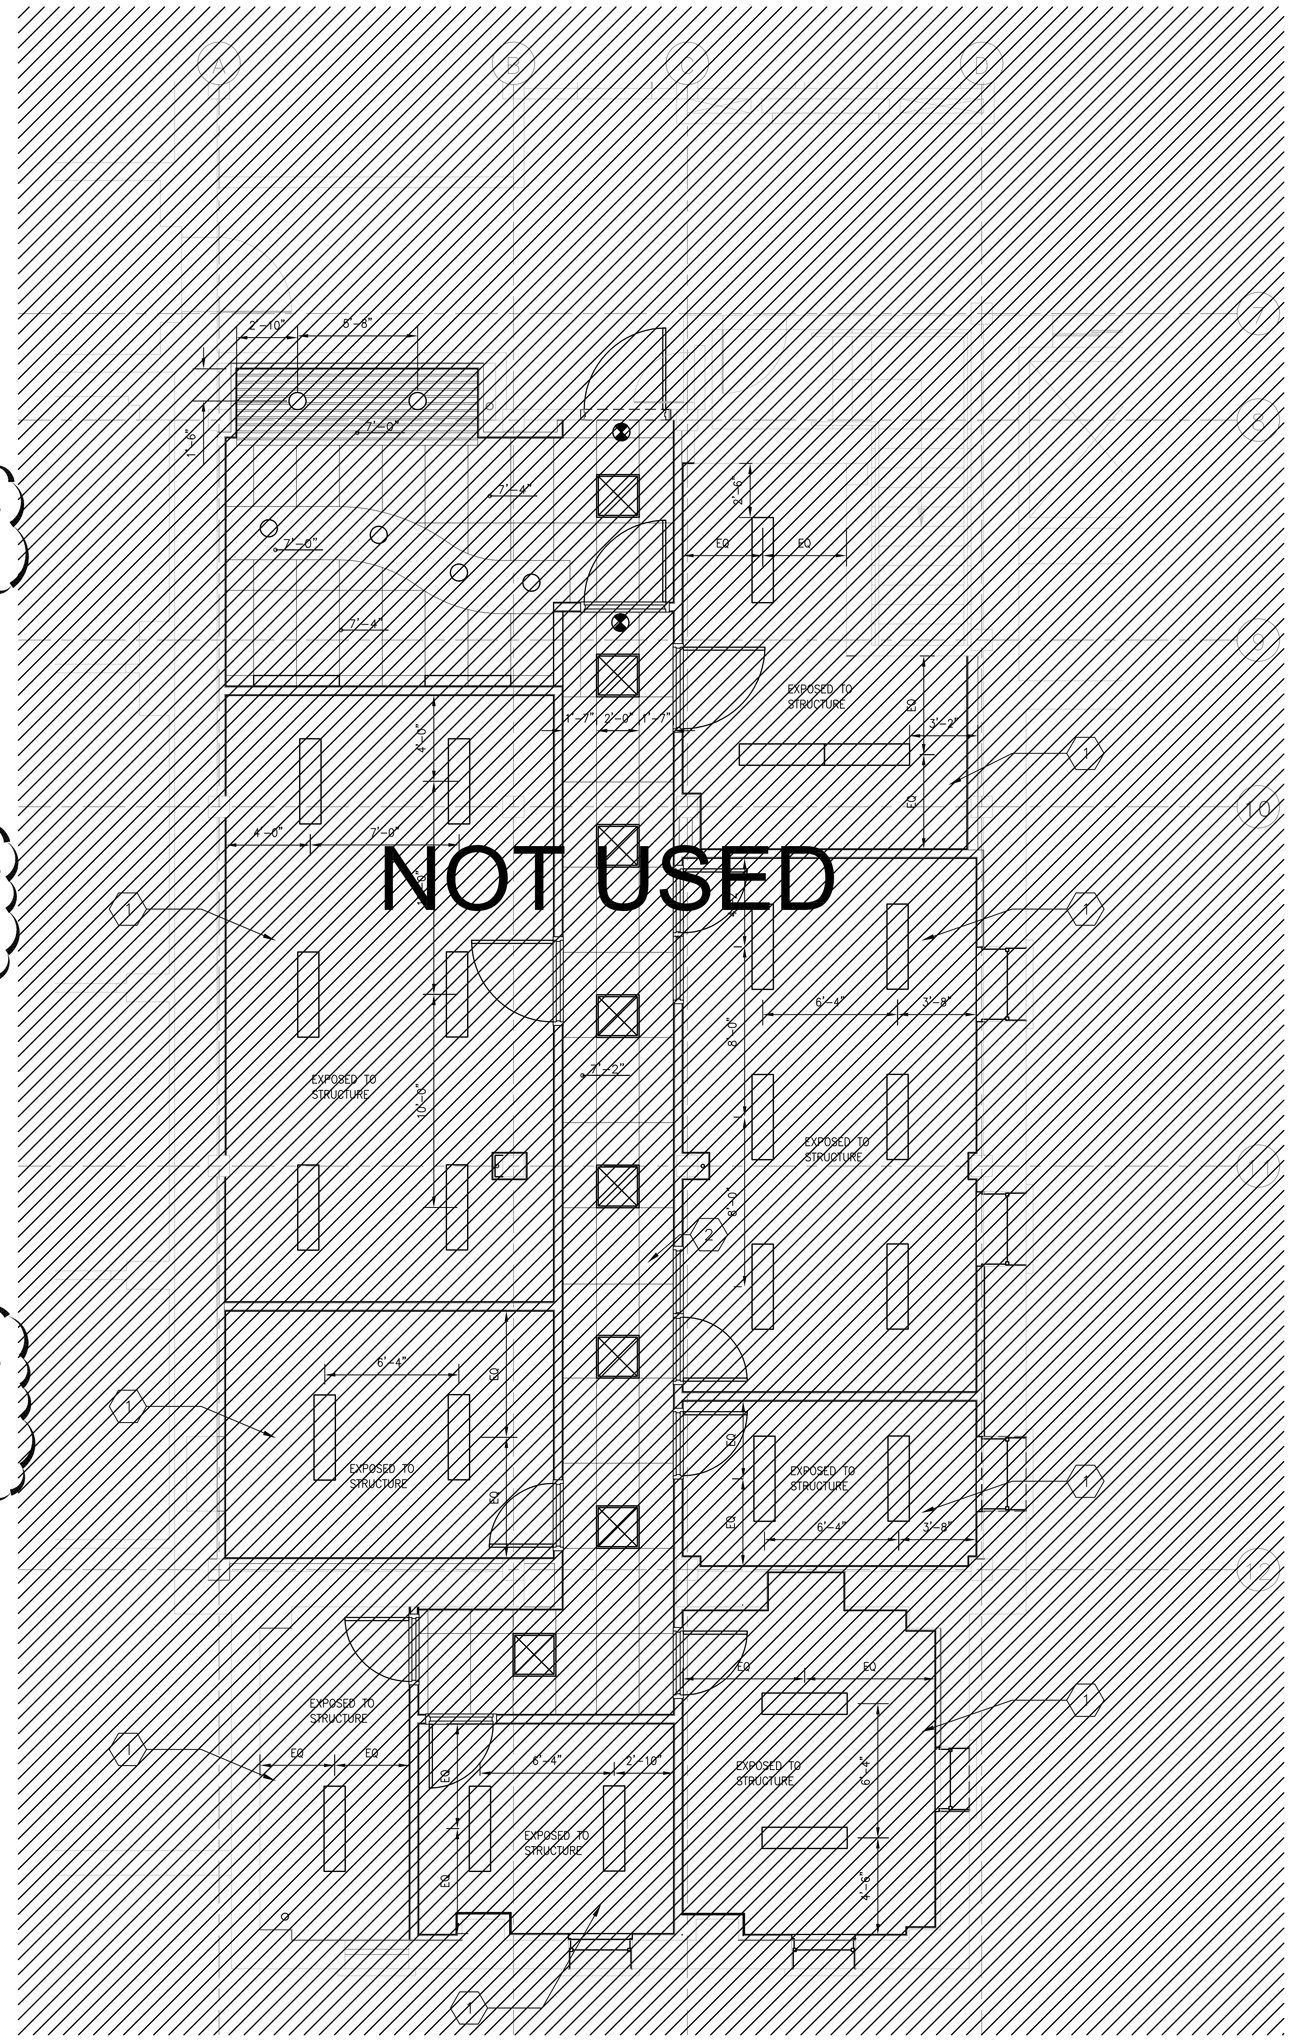

2 GROUND LEVEL REFLECTED CEILING PLAN
SCALE: 1/4" = 1'–0"

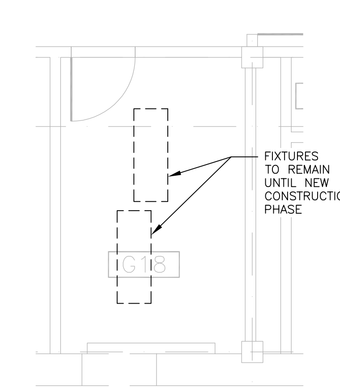

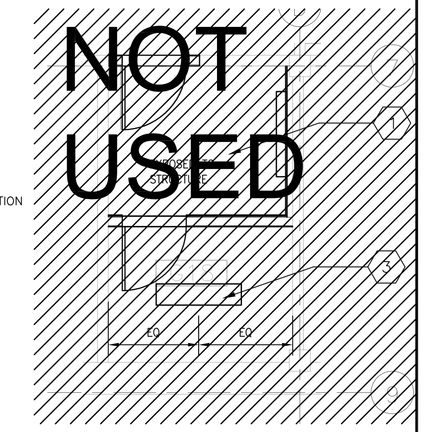

3 GROUND LEVEL REFLECTED CEILING PLAN
SCALE: 1/4" = 1'–0"

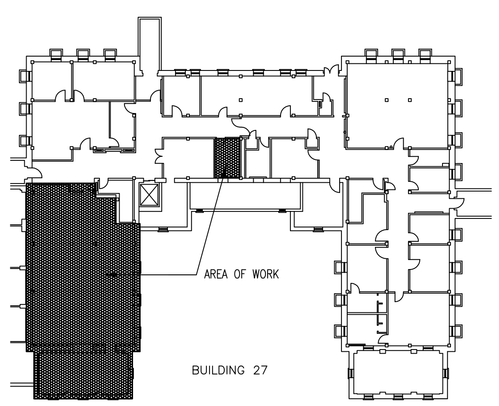

KEY PLAN

PLAN NORTH

FOR CONSTRUCTION

REVISIONS	DATE
1. ADDENDUM 1	5–31–12

LICENSED ARCHITECT — AR-1885 — STATE OF IDAHO — STEVEN C. TURNER

Architects and Planners, Chartered
408 E. Parkcenter Blvd, Suite 205 Boise, Idaho 83706

CAD FILE NAME: 531–11109_A90.DWG

XREF FILE NAME: XVABORD.DWG, 27AORC.DWG, X27AO.DWG, X27AO EXIST.DWG

DRAWING TITLE: GROUND LEVEL REFLECTED CEILING PLAN	PROJECT TITLE: VAMC RENOVATE BASEMENT 27 FOR PROSTHETICS			DATE: 03/16/12
APPROVED: CHIEF OF FACILITY MANAGEMENT SERVICE	BUILDING NUMBER: 27	CHECKED: SCT	DRAWN: NRP	PROJECT NO.: 531–11–109
APPROVED: MEDICAL CENTER DIRECTOR	LOCATION: VAMC BOISE, IDAHO			DRAWING NO.: A9.0
				DWG 7 OF 19

DEPARTMENT OF VETERANS AFFAIRS

10/31/2011 11:30:24 AM
5101154201\Drawings\A90\531-11109_A90.dwg, Layout1, 12/5/2012 11:15:46 AM, nrp