


GENERAL NOTES

1. WALL RATINGS ON ARCHITECTURAL PLANS ARE FOR REFERENCE ONLY AND SHOWN ONLY AT AREAS OF NEW CONSTRUCTION. SEE CODE COMPLIANCE/LIFE SAFETY DRAWINGS FOR LIFE SAFETY INFORMATION. ALL RATED WALL ASSEMBLIES FORM A CONTINUOUS FIRE OR SMOKE BARRIER THAT EXTENDS FROM THE FLOOR TO THE DECK AND CONTINUES TO THE EXTERIOR WALL. PROVIDE FIRE SEAL AT ALL TRANSITIONS TO MEET THE WALL RATINGS.
2. ALL DOORS ARE 6" TO FACE OF FRAME FROM ADJACENT WALL U.N.O.
3. REFER TO EQUIPMENT DRAWINGS AND SCHEDULE FOR COORDINATION WITH VA-PROVIDED EQUIPMENT AND FURNISHINGS. REFER TO OH SERIES DRAWINGS FOR EQUIPMENT INFORMATION.
4. SLOPE FLOORS 1/8" PER FOOT TO FLOOR DRAINS. MAINTAIN MINIMUM FLOOR CONSTRUCTION/THICKNESS PER STRUCTURAL AND FIRE RATED ASSEMBLIES.
5. PROVIDE F.R.T. WOOD OR METAL SHEET BLOCKING IN WALLS TO RECEIVE TOILET ACCESSORIES, MILLWORK, WALL-MOUNTED FIXTURES AND FURNITURE, WALL PROTECTION, EQUIPMENT, ETC. COORDINATE WITH VA-FURNISHED AND INSTALLED ITEMS.
6. THE WORDS "ALIGN" AND "EQUAL" AS USED IN THESE DOCUMENTS SUPERSEDE DIMENSIONS.
7. ALL EXPOSED EDGES OF PRECAST PANELS TO BE FINISHED TO MATCH FRONT FACE.
8. THE SILLS OF WINDOW OPENINGS IN PRECAST PANEL SHALL BE SLOPED FOR POSITIVE DRAINAGE.
9. REFER TO ENLARGED FLOOR PLANS FOR PARTITION TYPES. ALL PARTITIONS ARE TYPE R2 U.N.O.
10. REFER TO ENLARGED FLOOR PLANS FOR MORE COMPREHENSIVE NOTING.
11. CEILING SHALL HAVE TO BE REPAIRED/REPLACED IF DAMAGED DURING NEW UTILITY INSTALLATIONS WITHIN EXISTING FACILITY.
12. PERFORM WORK IN ACCORDANCE WITH APPLICABLE FEDERAL, STATE, LOCAL AND GENERAL BUILDING CODES AND REGULATIONS. CONTRACTOR TO OBTAIN AND PAY FOR ALL REQUIRED BUILDING PERMITS FOR THE WORK.
13. ACCESS TO SITE, DELIVERY ROUTE, LAY DOWN ARE FOR MATERIALS, LOGS AND OTHER SERVICES, AND SPACE UNDER CONSTRUCTION SHALL BE COORDINATED WITH THE RESIDENT ENGINEER AND THE OWNER'S REPRESENTATIVE BEFORE STARTING CONSTRUCTION.
14. ALL WORK THAT IS NOISY OR CAUSES VIBRATION WHICH COULD BE DISRUPTIVE TO THE CONTINUED OPERATION OF THE MEDICAL CENTER SHALL BE COORDINATED WITH THE RESIDENT ENGINEER AND OWNER'S REPRESENTATIVE BEFORE CONSTRUCTION.
15. ISOLATE CONSTRUCTION AREAS TO AVOID DISRUPTION TO ADJACENT AREAS AND TO CONTAIN DUST. PROVIDE TEMPORARY PARTITIONS AND TAKE PRECAUTIONARY MEASURES TO PREVENT MIGRATION OF DUST DISTRIBUTED TO MECHANICAL SYSTEMS TO OTHER AREAS OF THE MEDICAL CENTER.
16. PROVIDE PROFESSIONAL JANITORIAL CLEANING FOR FINAL CLEANING PRIOR TO SUBSTANTIAL COMPLETION.
17. EXISTING CONSTRUCTION TO REMAIN AND EXISTING AREAS AFFECTED BY NEW CONSTRUCTION SHALL BE REPAIRED AND REFINISHED TO MATCH CONTIGUOUS CONDITIONS BASED ON ARCHITECT AND OWNER APPROVAL.
18. WHERE REQUIREMENTS CALL FOR MATCHING EXISTING CONSTRUCTION, FINISHES, PRODUCTS, ETC., THE ARCHITECT'S DECISION WILL BE FINAL ON WHETHER THE MATCH IS ACCEPTABLE. IF THE MATCH IS NOT ACCEPTABLE, PROVIDE SAMPLES OF SUITABLE ALTERNATIVES FOR THE ARCHITECT'S SELECTION.
19. PROVIDE CONCRETE EQUIPMENT-HOUSE KEEPING PADS AT MECHANICAL EQUIPMENT. REFER TO MECH. DWGS FOR LOCATIONS AND STRUCT. DWGS FOR TYPICAL DETAIL. COORDINATE FINAL LOCATION AND SIZE WITH APPROVED EQUIPMENT AND COORDINATION SHOP DRAWINGS.
20. PROVIDE CLEAN UP, TRASH DISPOSAL AND DUMPSTERS. REVIEW TRASH REMOVAL ROUTE AND SCHEDULE WITH RESIDENT ENGINEER AND OWNER'S REPRESENTATIVE BEFORE STARTING CONSTRUCTION.
21. REMOVE AND REINSTALL CEILING ASSEMBLY TO ACCOMMODATE MEP AND SERVICES ROUTE. REFER TO TECHNOLOGY Y SERIES DRAWINGS FOR TELE/DATA ROUTING AND CEILING REMOVAL SCOPE IN THE MAIN HOSPITAL. REFER TO P-TUBE DRAWINGS FOR P-TUBE ROUTING AND CEILING REMOVAL SCOPE.
22. GENERAL CONTRACTOR TO COORDINATE COUNTERTOP GROMMET LOCATIONS WITH CONTRACTING OFFICER REPRESENTATIVE.

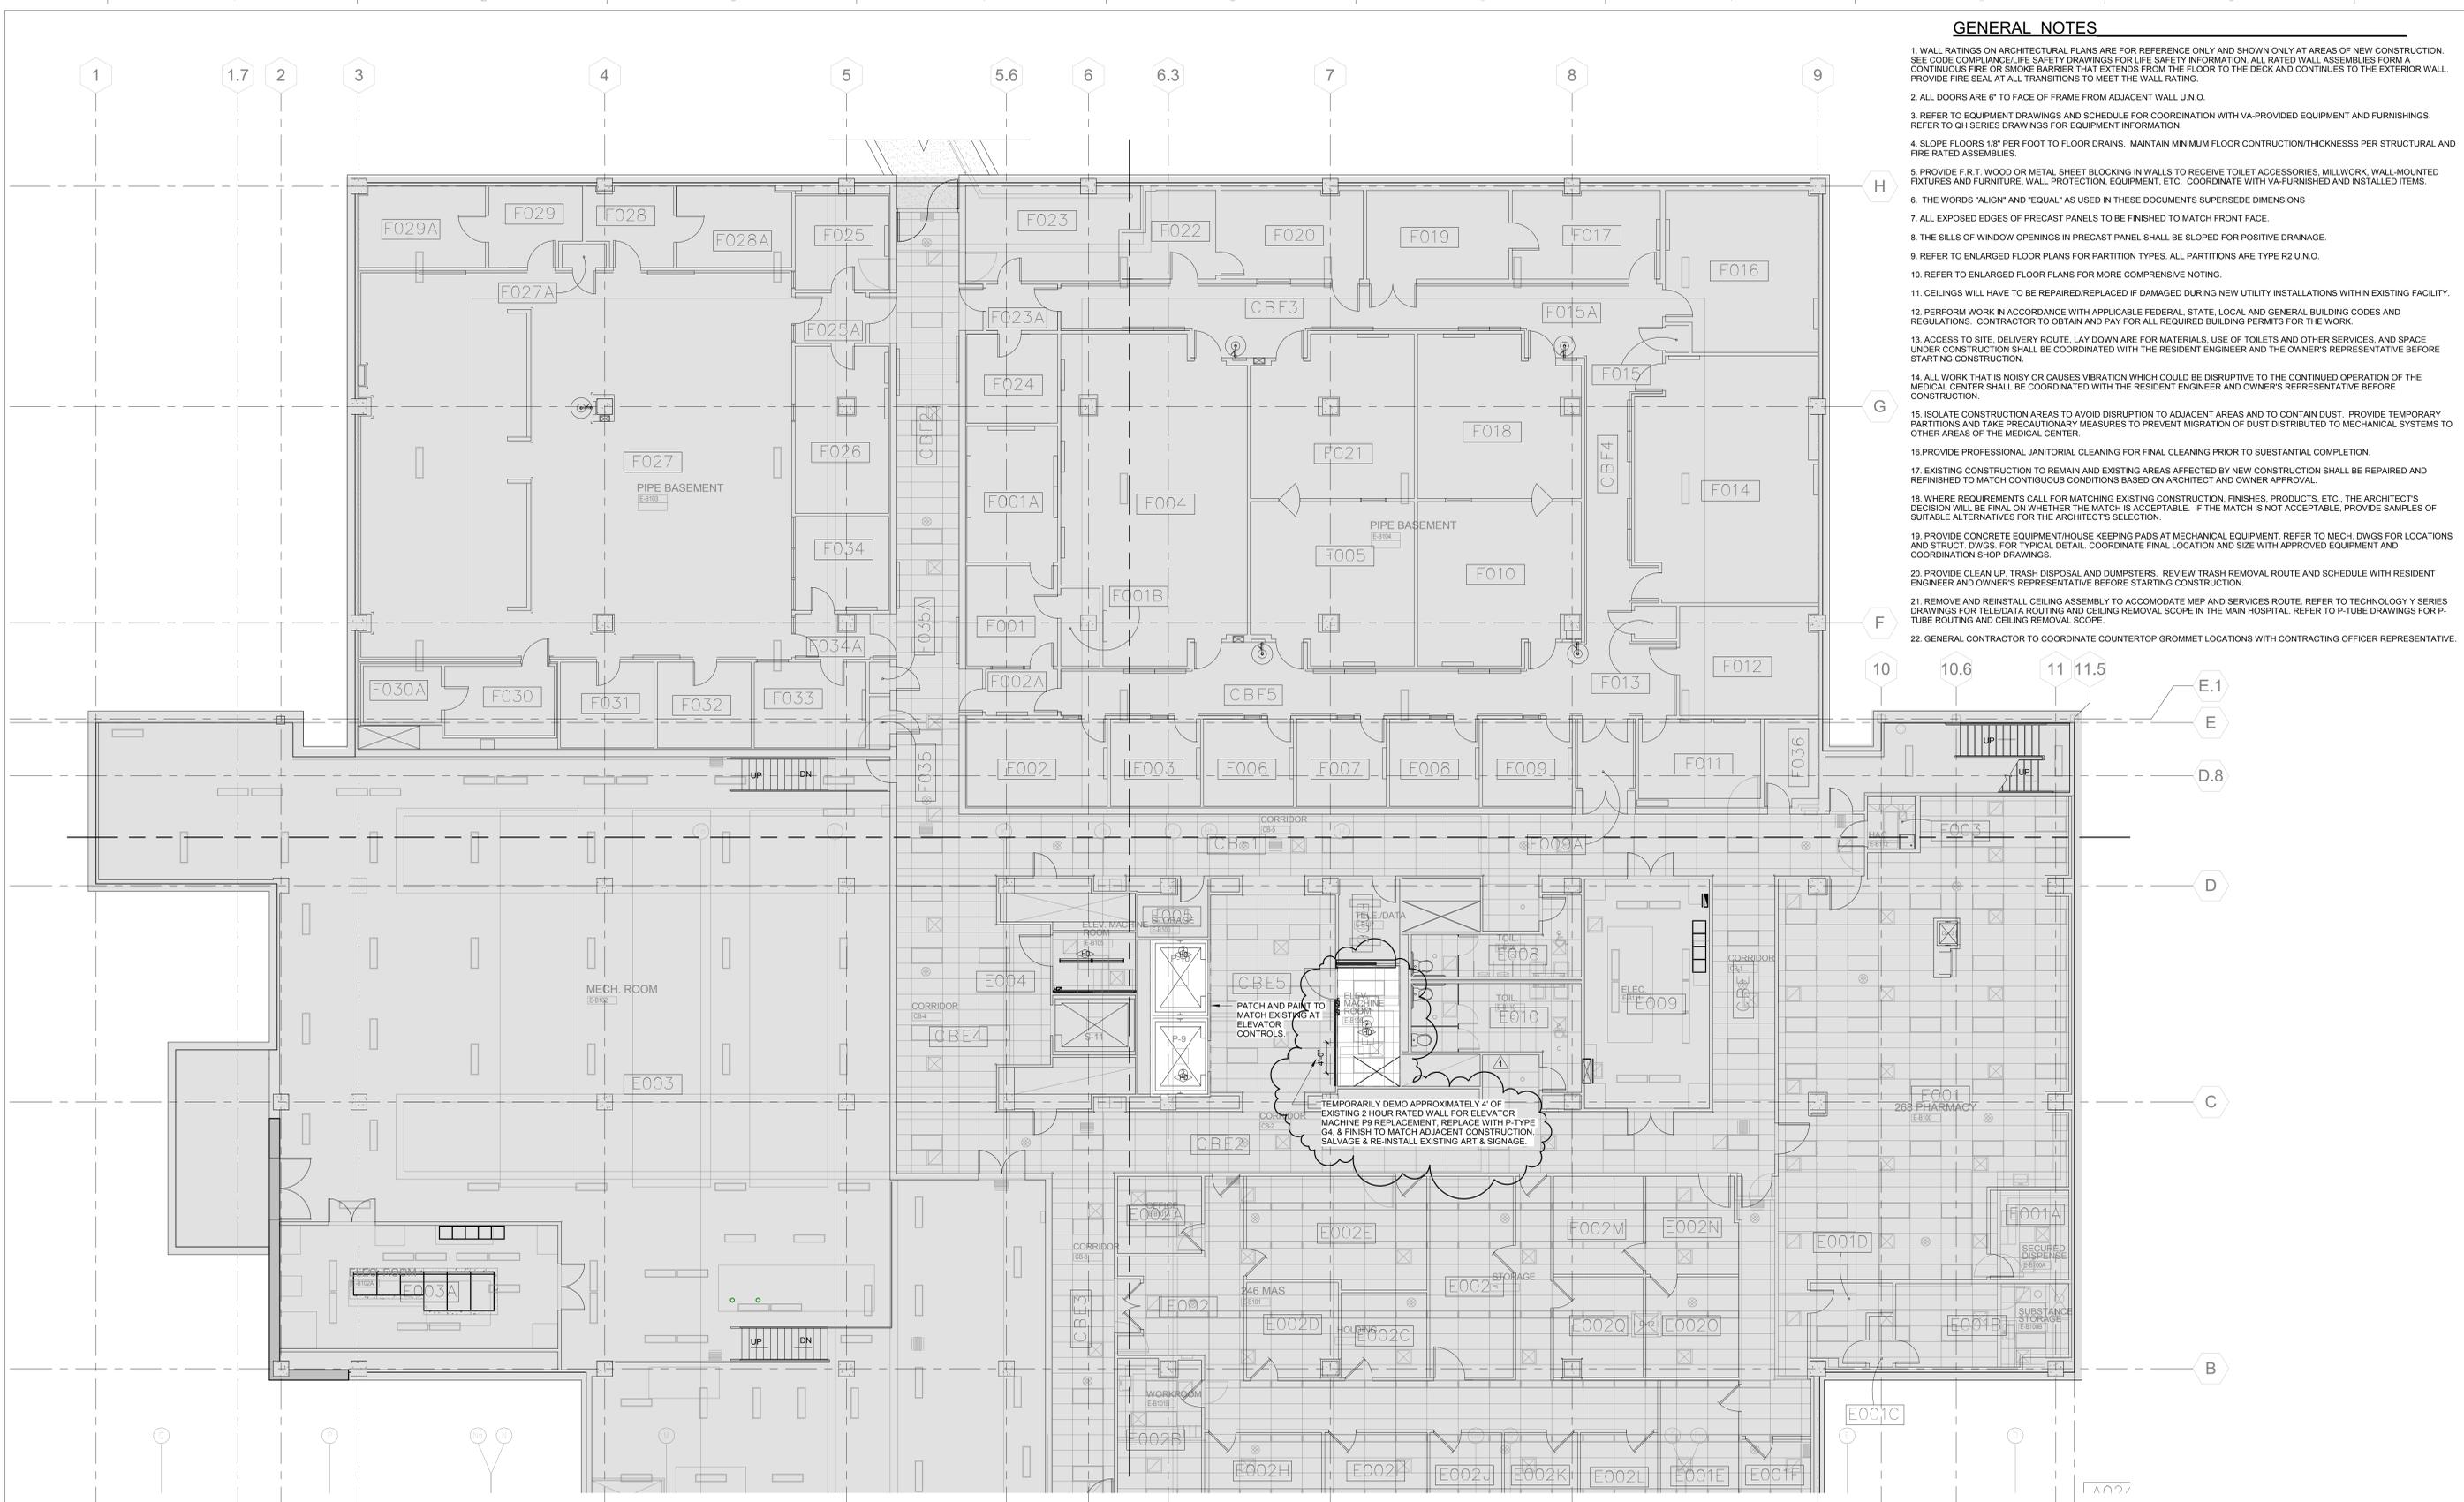

4F BASEMENT FLOOR PLAN
1/8" = 1'-0" REF 2 / AS-411.1

1	Addendum 02	06/08/17
Revisions:	Date	

CONSULTANTS:

AcoustiControl
Acoustical Engineer
2464 Taylor Road
Suite 214
Wildwood, MO 63040
314.436.9770

The Schachinger Group
Elevator
4255 Stoney Creek Drive
Fort Collins, CO 80525
973.606.2263



ARCHITECT/ENGINEERS:

CANNONDESIGN

1100 Clark Avenue
St. Louis, Missouri 63102
T: 314.241.6250
F: 314.241.2570

© CannonDesign 2017
All rights reserved. No part of this document may be reproduced or utilized in any form, without prior written authorization by the Cannon Corporation.

Drawing Title
BASEMENT FLOOR PLAN

Approved: Project Director

Project Title Harry S. Truman Memorial Veterans' Hospital Expand Ambulatory Care Addition			Project Number 589-333 CANNON DESIGN PROJECT NO. 3850.06		
Location Columbia, Missouri			Drawing Number AS-100.2		
Date JANUARY 13, 2017	Checked Checker	Drawn Author	Dwg. of		

Office of
Construction
and Facilities
Management

Department of
Veterans Affairs