

 AHJ ENGINEERS, PC STRUCTURAL CONSULTANTS	AHJ NO.	11050.00	DATE: 06-05-2012	SHEET NO.
	PROJECT: VA RES. MENTAL HEALTH		BY: C.H. / G.V.	
	VA-260-11-RP-0663			
	ADDENDUM #1			

P:\111050-ZGA-VA Mental Health\02-Structural\531CS102_S3.4.dwg, 8.5x11 (2), 6/5/2012 2:47:04 PM

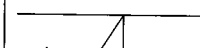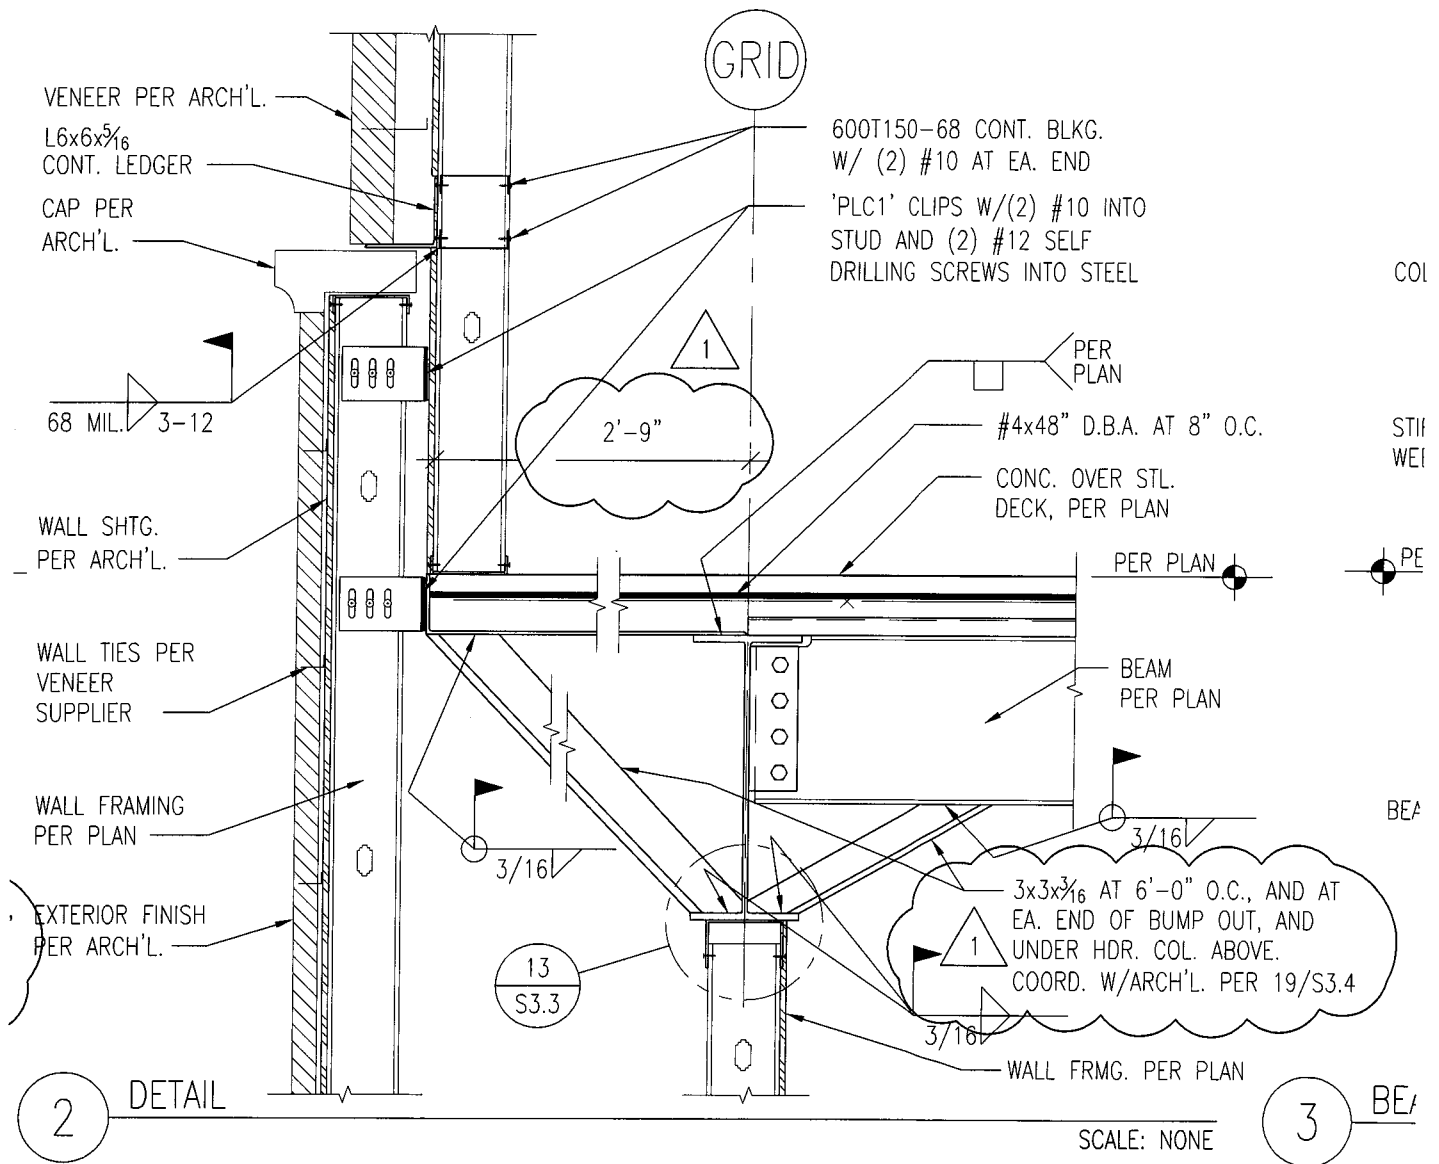



AHJ ENGINEERS, PC
STRUCTURAL CONSULTANTS

AHJ NO. 11050.00
PROJECT: VA RES. MENTAL HEALTH
VA-260-11-RP-0663
ADDENDUM #1

DATE: 06-05-2012
BY: C.H. / G.V.

SHEET NO.

2
3
S3.4

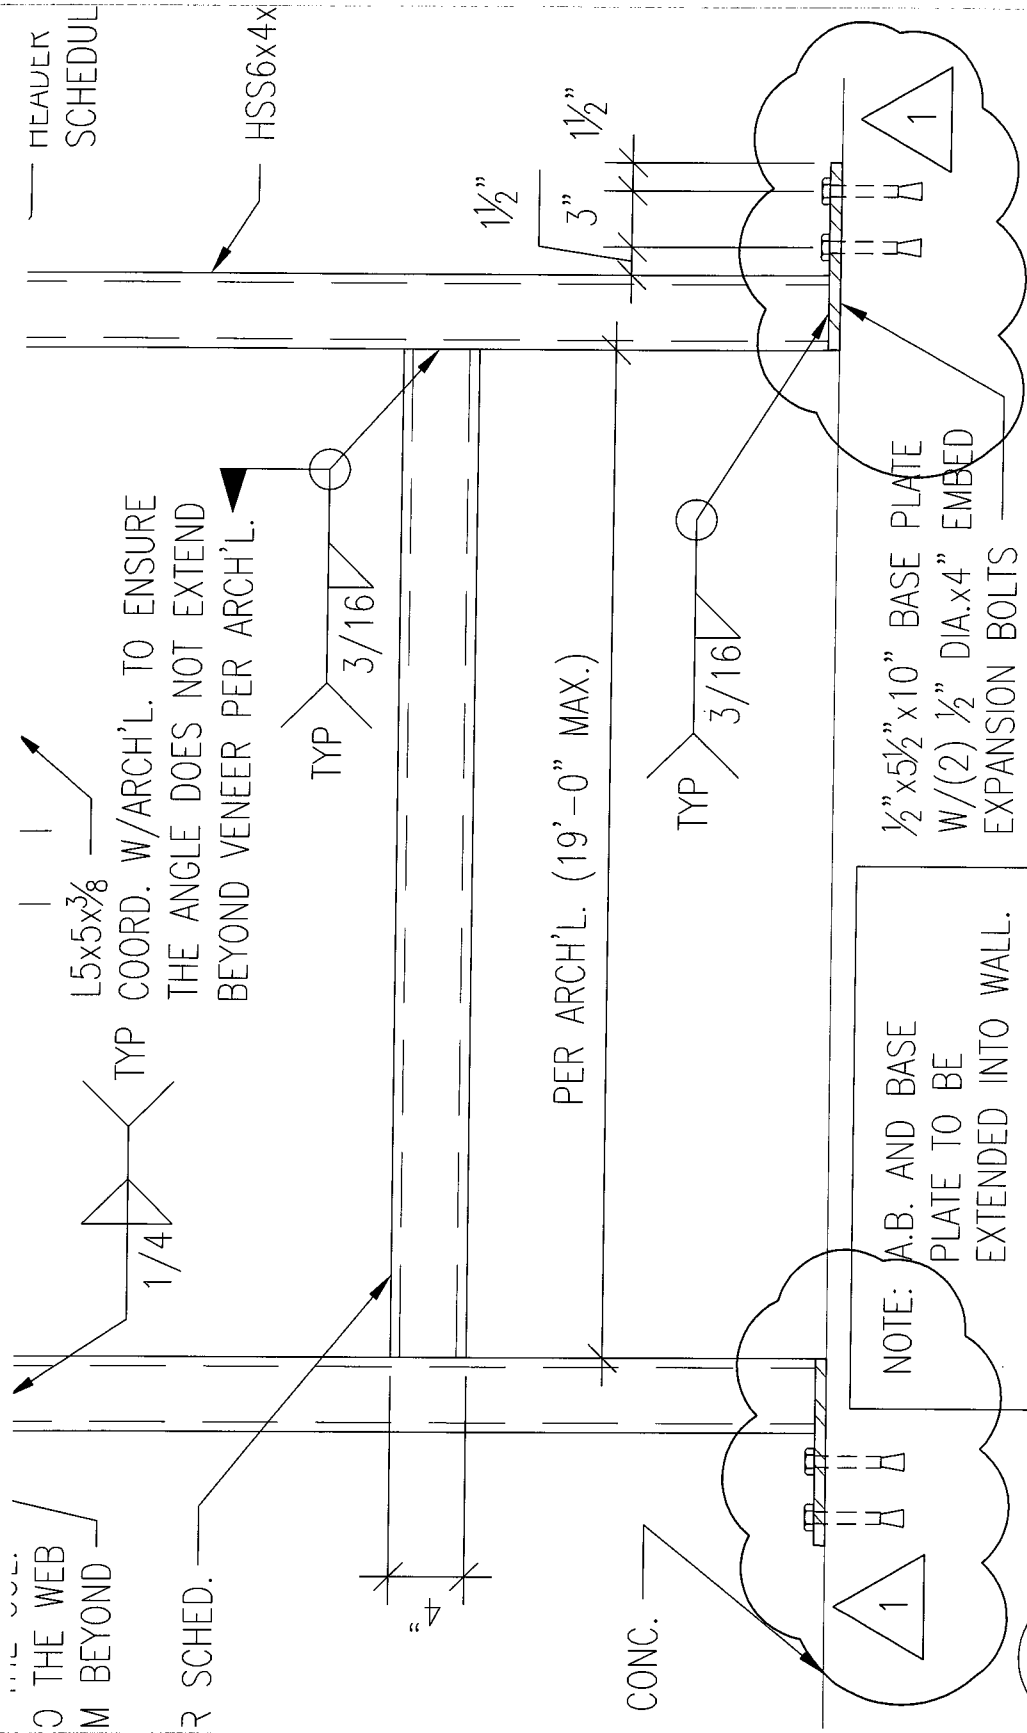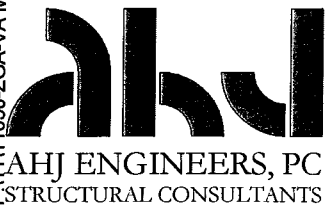

20

SCALE: NONE


AHJ NO. 11050.00
 PROJECT: VA RES. MENTAL HEALTH
 VA-260-11-RP-0663
 ADDENDUM #1

DATE: 06-05-2012
 BY: C.H. / G.V.

SHEET NO.

3 / 3 S3.4

P:\11\11050-ZGA-VA Mental Health\02-Structural\531CS102_S3.5.dwg, 8.5x11, 6/4/2012 12:20:06 PM

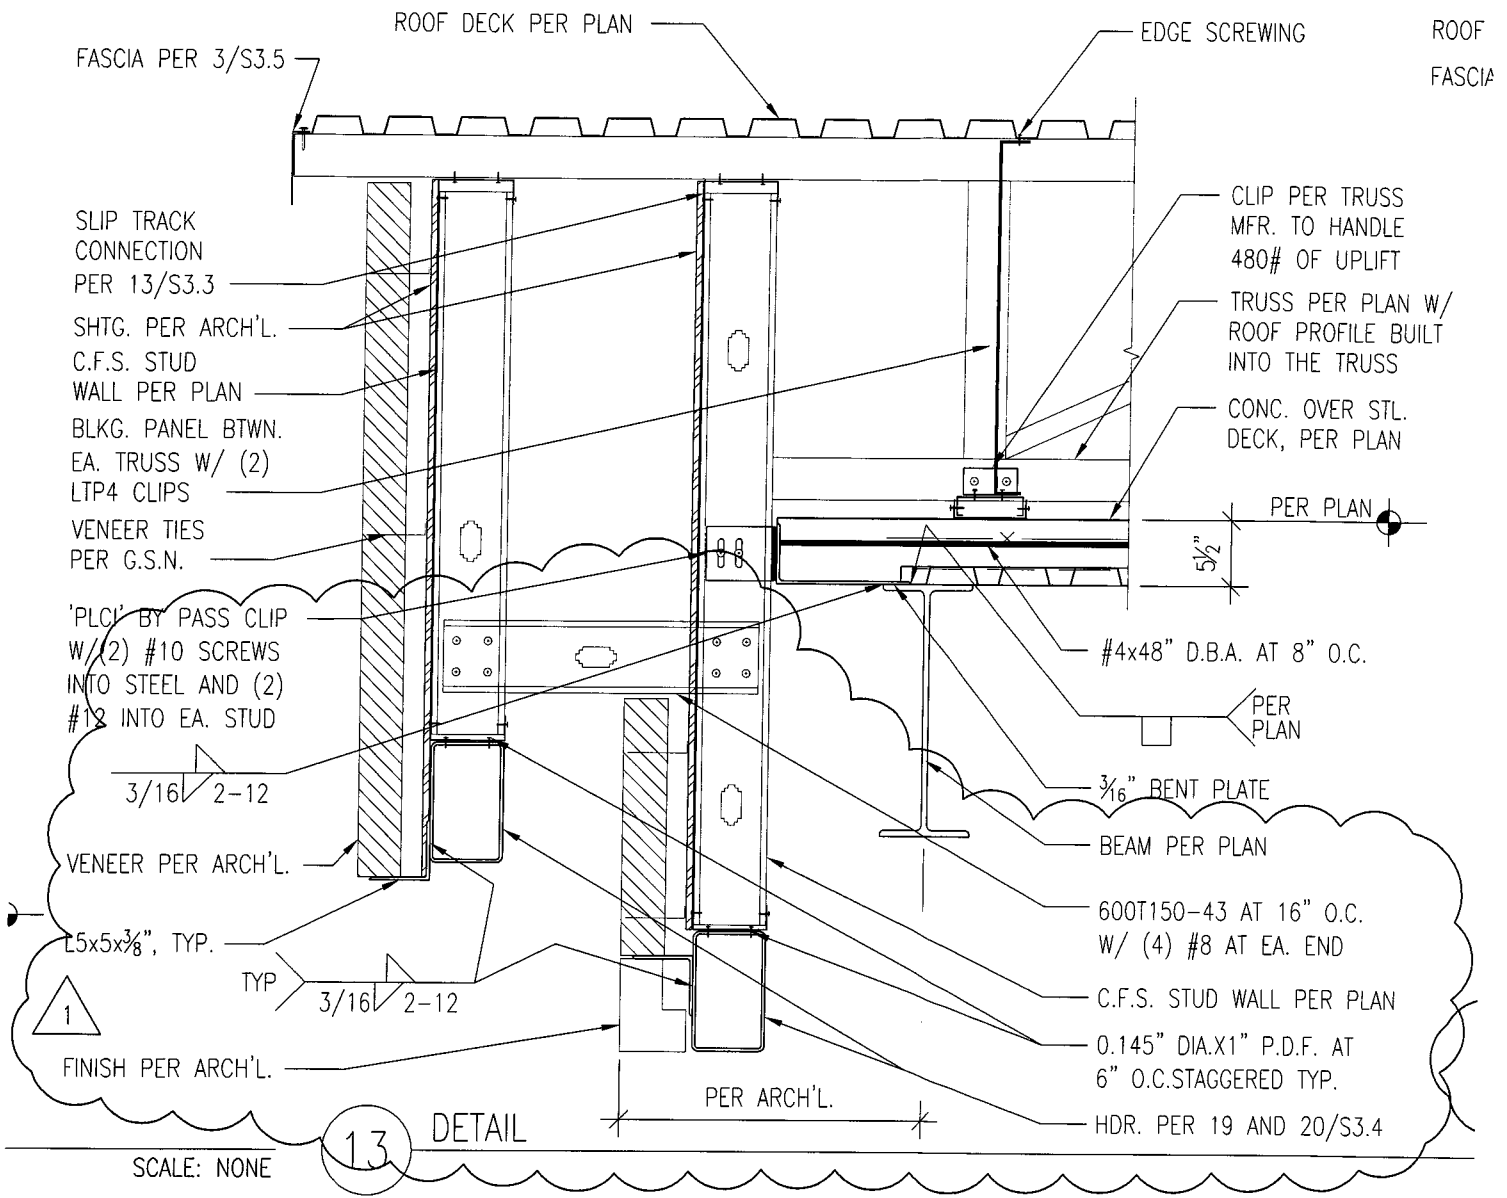

13 DETAIL

SCALE: NONE



AHJ ENGINEERS, PC
STRUCTURAL CONSULTANTS



AHJ NO. 11050.00
PROJECT: VA RES. MENTAL HEALTH
VA-260-11-RP-0663
ADDENDUM #1

DATE: 06-05-2012
BY: C.H. / G.V.

SHEET NO.

1
2
S3.5

P:\1111050-ZGA-VA Mental Health\02-Structural\531CS1102_S3.5.dwg, 8.5x11 (2), 6/4/2012 12:19:52 PM

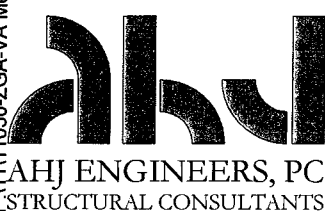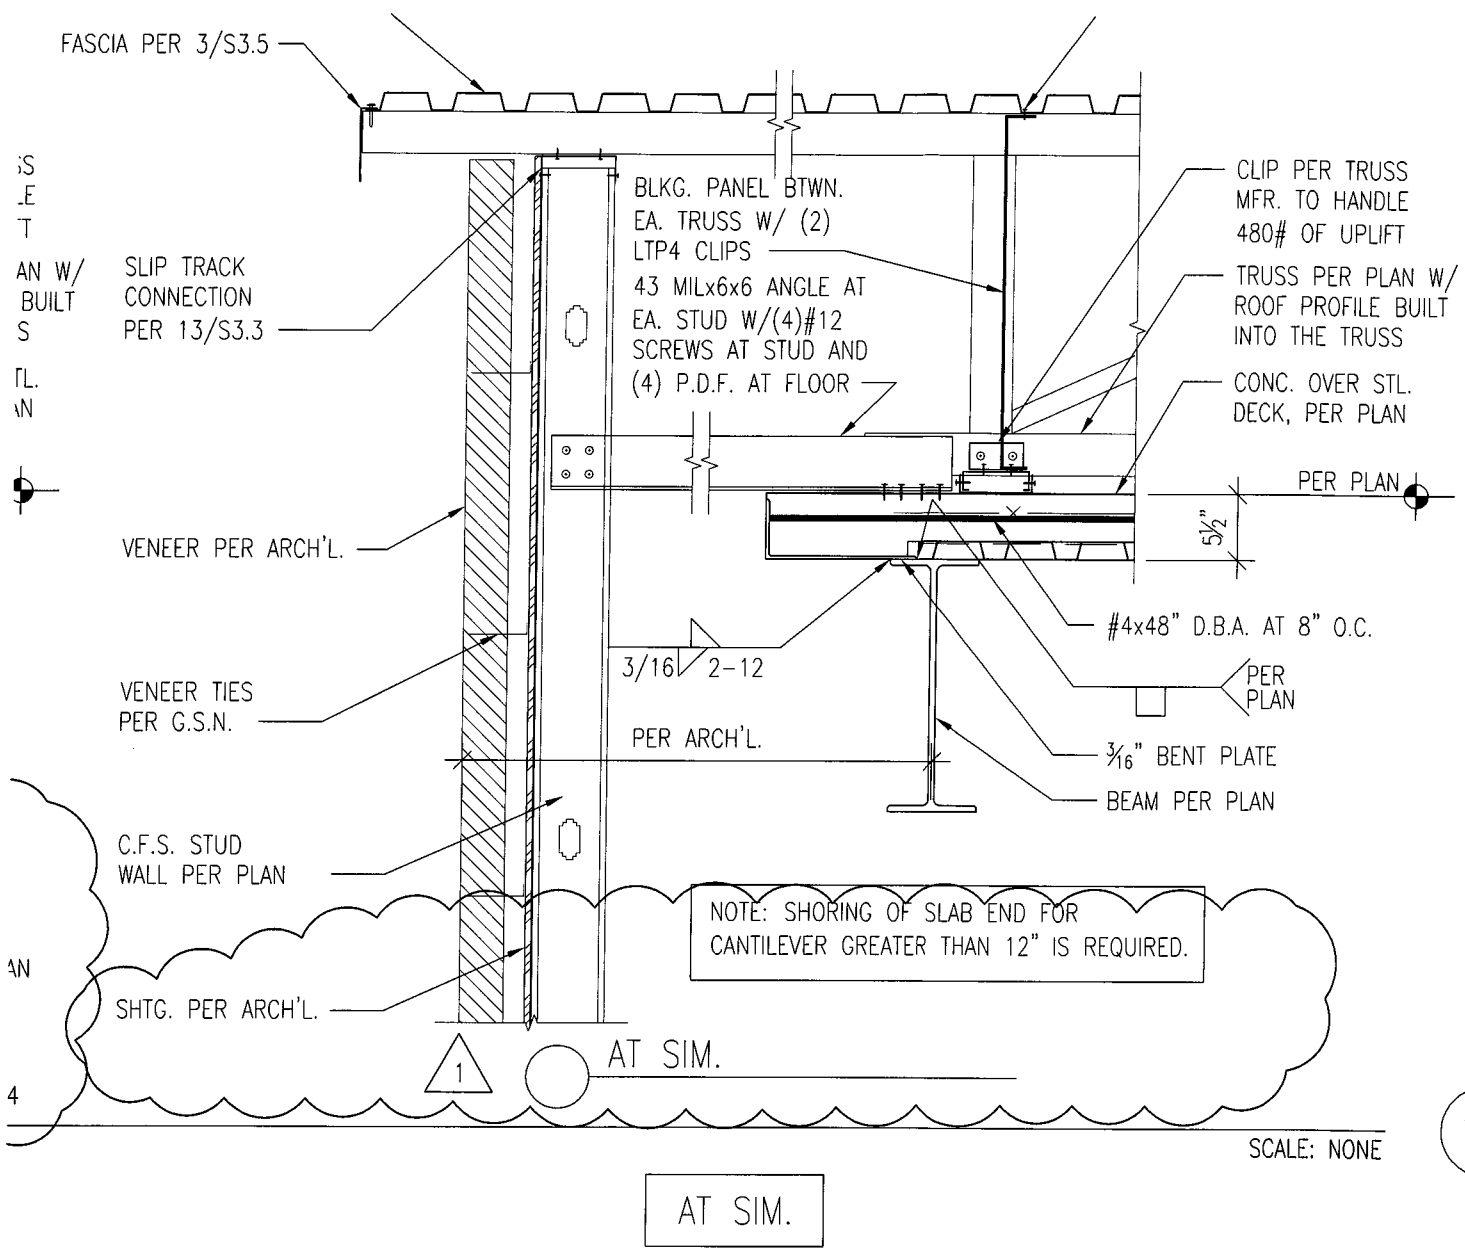

AHJ NO. 11050.00

PROJECT: VA RES. MENTAL HEALTH

VA-260-11-RP-0663

ADDENDUM #1

DATE: 06-05-2012

BY: C.H. / G.V.

SHEET NO.

2 / 2

S3.5