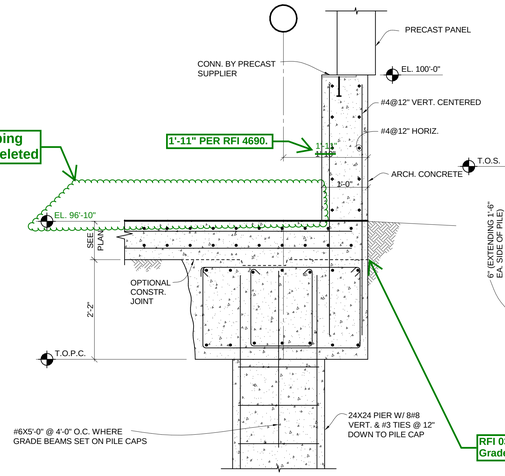

RFI 03252: Topping slab has been deleted

RFI 03252: Topping slab has been deleted

RFI 03056: Top of Grade Beam is 95'-9"

1 SECTION
3/4" = 1'-0"

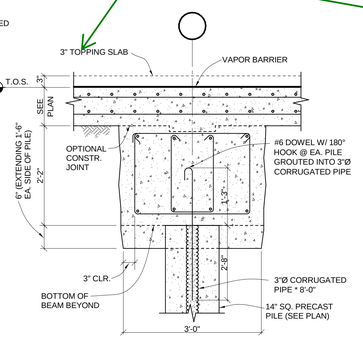

2 SECTION
3/4" = 1'-0"

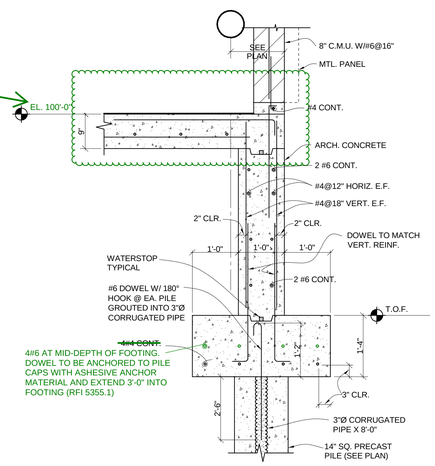

3 SECTION
3/4" = 1'-0"

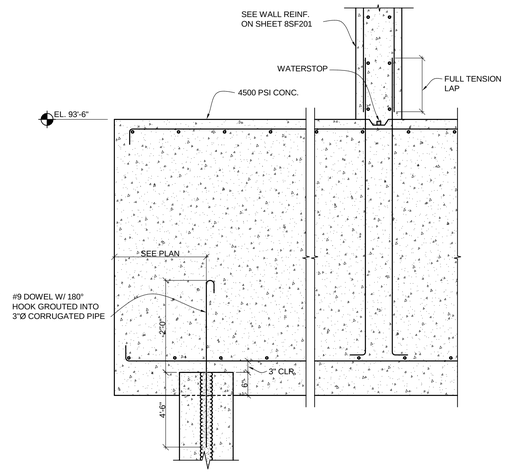

4 SECTION
3/4" = 1'-0"

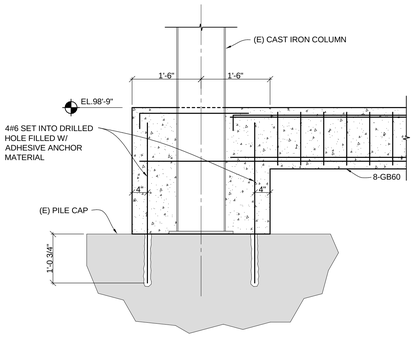

5 SECTION
3/4" = 1'-0"

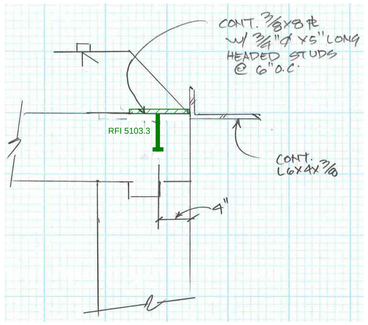

16 SECTION RFI 5103.1
1/2" = 1'-0"

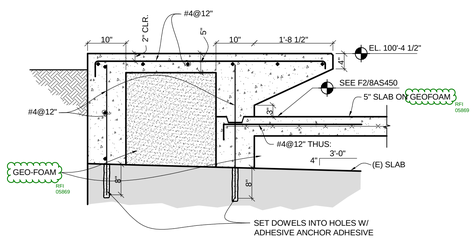

7 SECTION
3/4" = 1'-0"

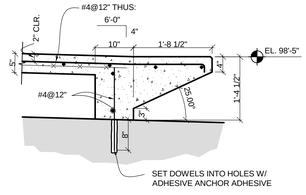

8 SECTION
3/4" = 1'-0"

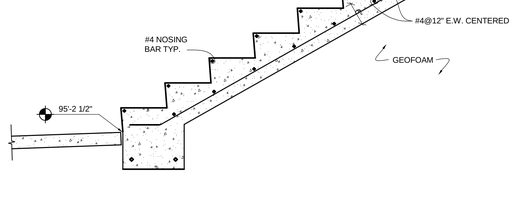

9 SECTION
3/4" = 1'-0"

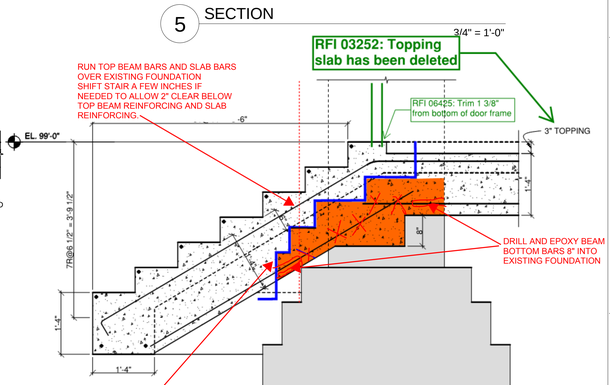

10 SECTION REVISED DETAIL PER RFI 08696
3/4" = 1'-0"

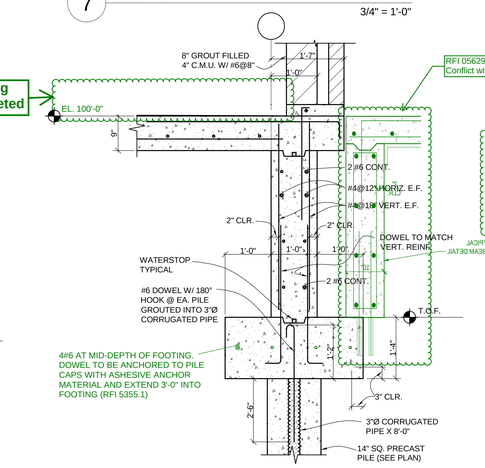

11 SECTION
3/4" = 1'-0"

12 SECTION
3/4" = 1'-0"

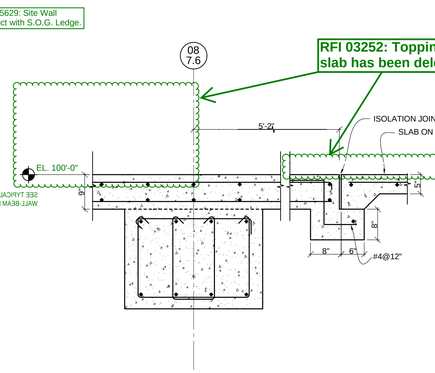

13 SECTION
3/4" = 1'-0"

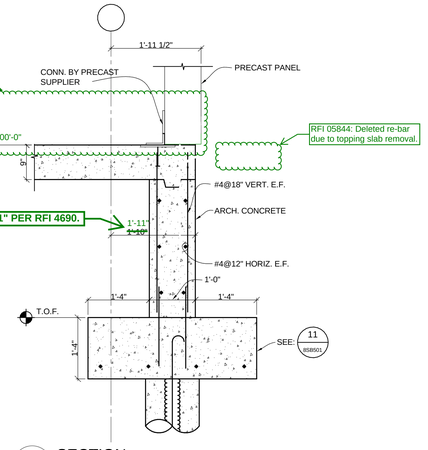

14 SECTION
3/4" = 1'-0"

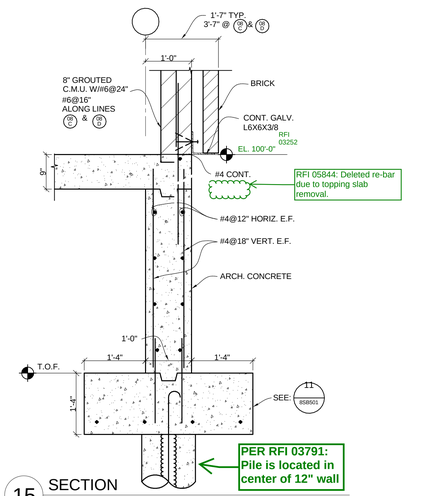

15 SECTION
3/4" = 1'-0"

CONSTRUCTION DOCUMENTS 1
FULLY SPRINKLERED

REVISIONS:	DATE

CONSULTANTS:

DESMAN ASSOCIATES / PARKING
CODE CONSULTANTS, INC. / CODE CONSULTANT
THE SEXTANT GROUP / AV & ACOUSTICAL
HAMMER DESIGN ASSOCIATES / FOOD SERVICE
PYBURN & ODOM / ABATEMENT
TATA & HOWARD / TANK CONSULTANT
I.S.C. GROUP, INC. / IRRIGATION
DAN EUSER WATER ARCHITECTURE, INC. / WATER FEATURE

STATE OF LOUISIANA — THOMAS M. DOYLE — LICENSED PROFESSIONAL ENGINEER IN STRUCTURAL ENGINEERING

ARCHITECT/ENGINEERS:

studioNOVA
SCHRENK & PETERSON CONSULTING ENGINEERS / CIVIL
KORDA/NEMETH ENGINEERING / STRUCTURAL
BR+A CONSULTING ENGINEERS / MECH, ELECT, PLUMBING, LOW VOLTAGE
ARCHITECTURAL ENGINEERING / PLUMBING
SCALES ASSOCIATES / FIRE PROTECTION
COMMUNICATIONS DESIGN GROUP / LOW VOLTAGE

DRAWING TITLE: TYPICAL STRUCTURAL DETAILS

APPROVED: PROJECT DIRECTOR: Todd Landis

PROJECT TITLE: SLVHCS REPLACEMENT MEDICAL CENTER PROJECT

LOCATION: NEW ORLEANS, LOUISIANA

DATE: July 16, 2012 | CHECKED: TMD | DRAWN: RJC

PROJECT NUMBER: 629-HS2-401 | BUILDING NUMBER: 8

DOCUMENT SET PACKAGE: WP_09B

DRAWING NUMBER: 8SB501

OFFICE OF CONSTRUCTION AND FACILITIES MAINTENANCE

Department of Veterans Affairs