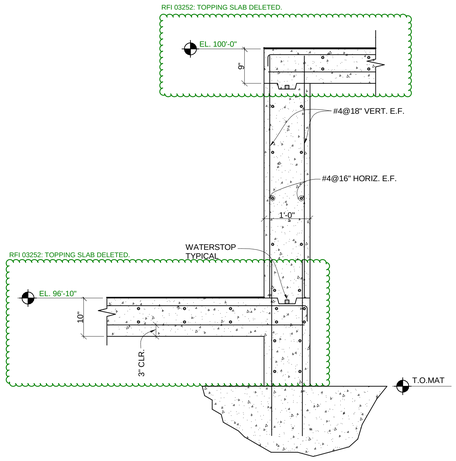

1 SECTION

3/4" = 1'-0"

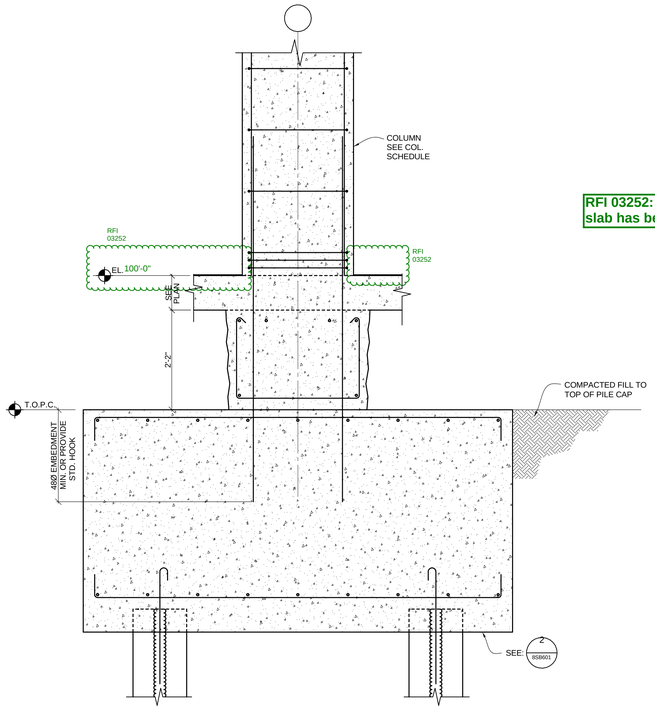

2 SECTION

3/4" = 1'-0"

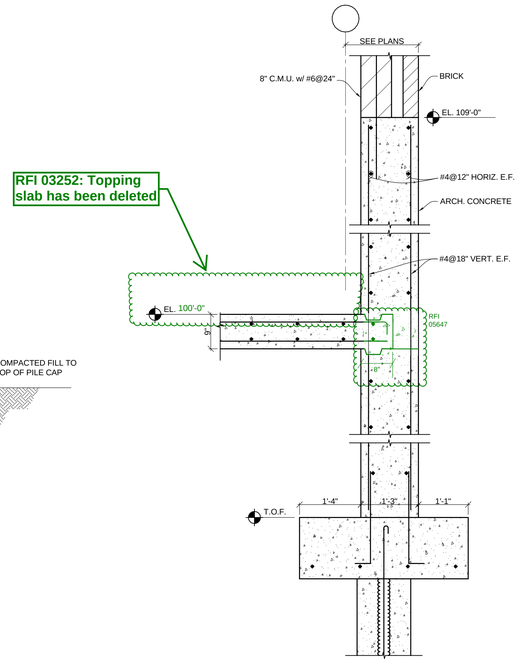

3 SECTION

3/4" = 1'-0"

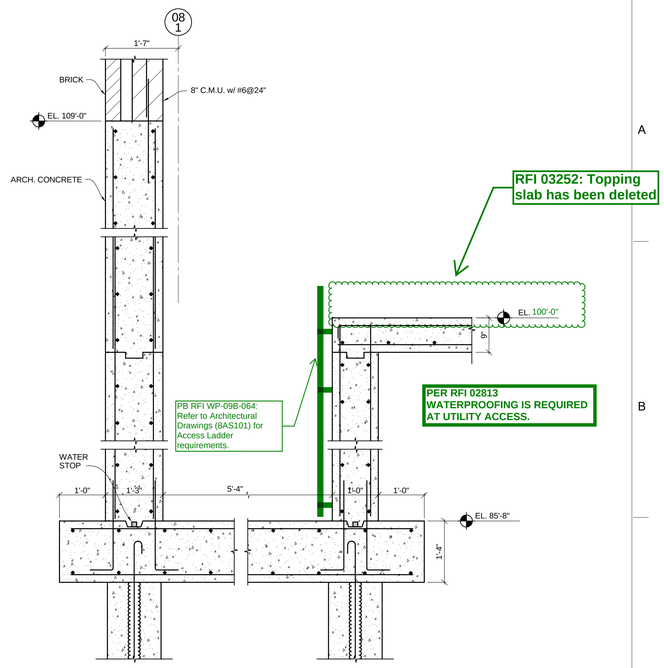

4 SECTION

3/4" = 1'-0"

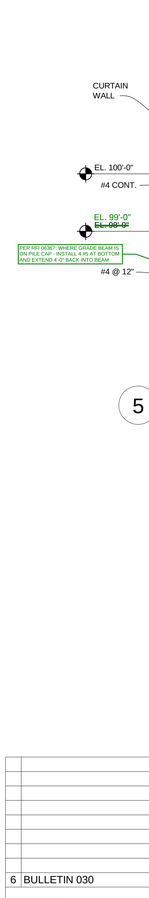

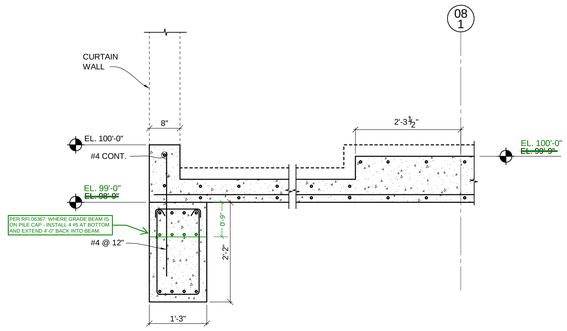

5 SECTION

3/4" = 1'-0"

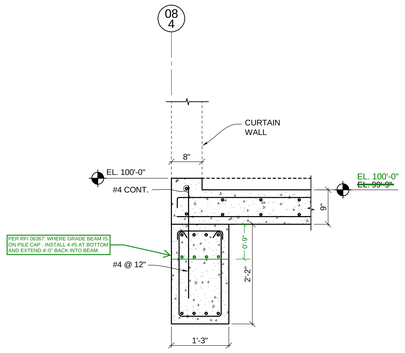

6 SECTION

3/4" = 1'-0"

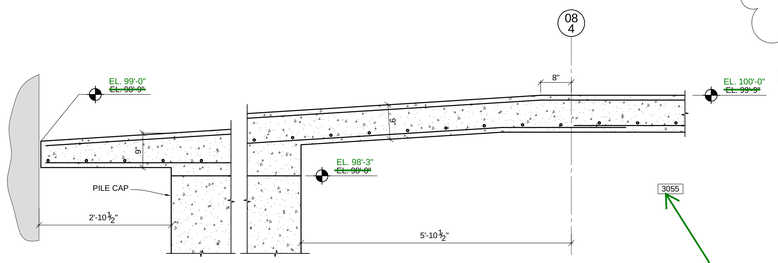

7 SECTION

3/4" = 1'-0"

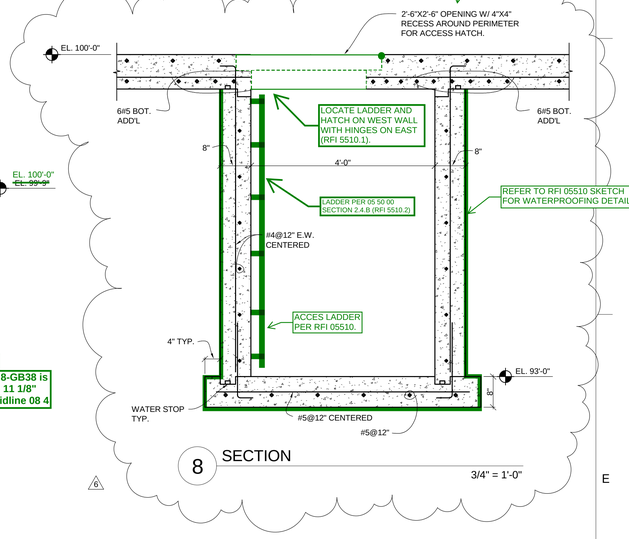

8 SECTION

3/4" = 1'-0"

CONSTRUCTION DOCUMENTS 1
FULLY SPRINKLERED

6	BULLETIN 030	07/15/14
REVISIONS:		DATE

CONSULTANTS:

DESMAN ASSOCIATES / PARKING
CODE CONSULTANTS, INC. / CODE CONSULTANT
THE SEXTANT GROUP / AV & ACOUSTICAL
HAMMER DESIGN ASSOCIATES / FOOD SERVICE
PYBURN & ODOM / ABATEMENT
TATA & HOWARD / TANK CONSULTANT
I.S.C. GROUP, INC. / IRRIGATION
DAN EUSER WATER ARCHITECTURE, INC. / WATER FEATURE

STATE OF LOUISIANA — THOMAS M. DOYLE — LICENSED PROFESSIONAL ENGINEER IN STRUCTURAL/CIVIL ENGINEERING

ARCHITECT/ENGINEERS:

studioNOVA
SCHRENK & PETERSON CONSULTING ENGINEERS / CIVIL
KORDA/NEMETH ENGINEERING / STRUCTURAL
BR+A CONSULTING ENGINEERS / MECH, ELECT, PLUMBING, LOW VOLTAGE
ARCHITECTURAL ENGINEERING / PLUMBING
SCALES ASSOCIATES / FIRE PROTECTION
COMMUNICATIONS DESIGN GROUP / LOW VOLTAGE

DRAWING TITLE: TYPICAL STRUCTURAL DETAILS
APPROVED: PROJECT DIRECTOR
PROJECT TITLE: SLVHCS REPLACEMENT MEDICAL CENTER PROJECT
LOCATION: NEW ORLEANS, LOUISIANA
DATE: July 16, 2012 | CHECKED: TMD | DRAWN: RJC
PROJECT NUMBER: 629-HS2-401 | BUILDING NUMBER: 8
DOCUMENT SET PACKAGE: WP_09B
DRAWING NUMBER: 8SB502

OFFICE OF CONSTRUCTION AND FACILITIES MAINTENANCE
Department of Veterans Affairs