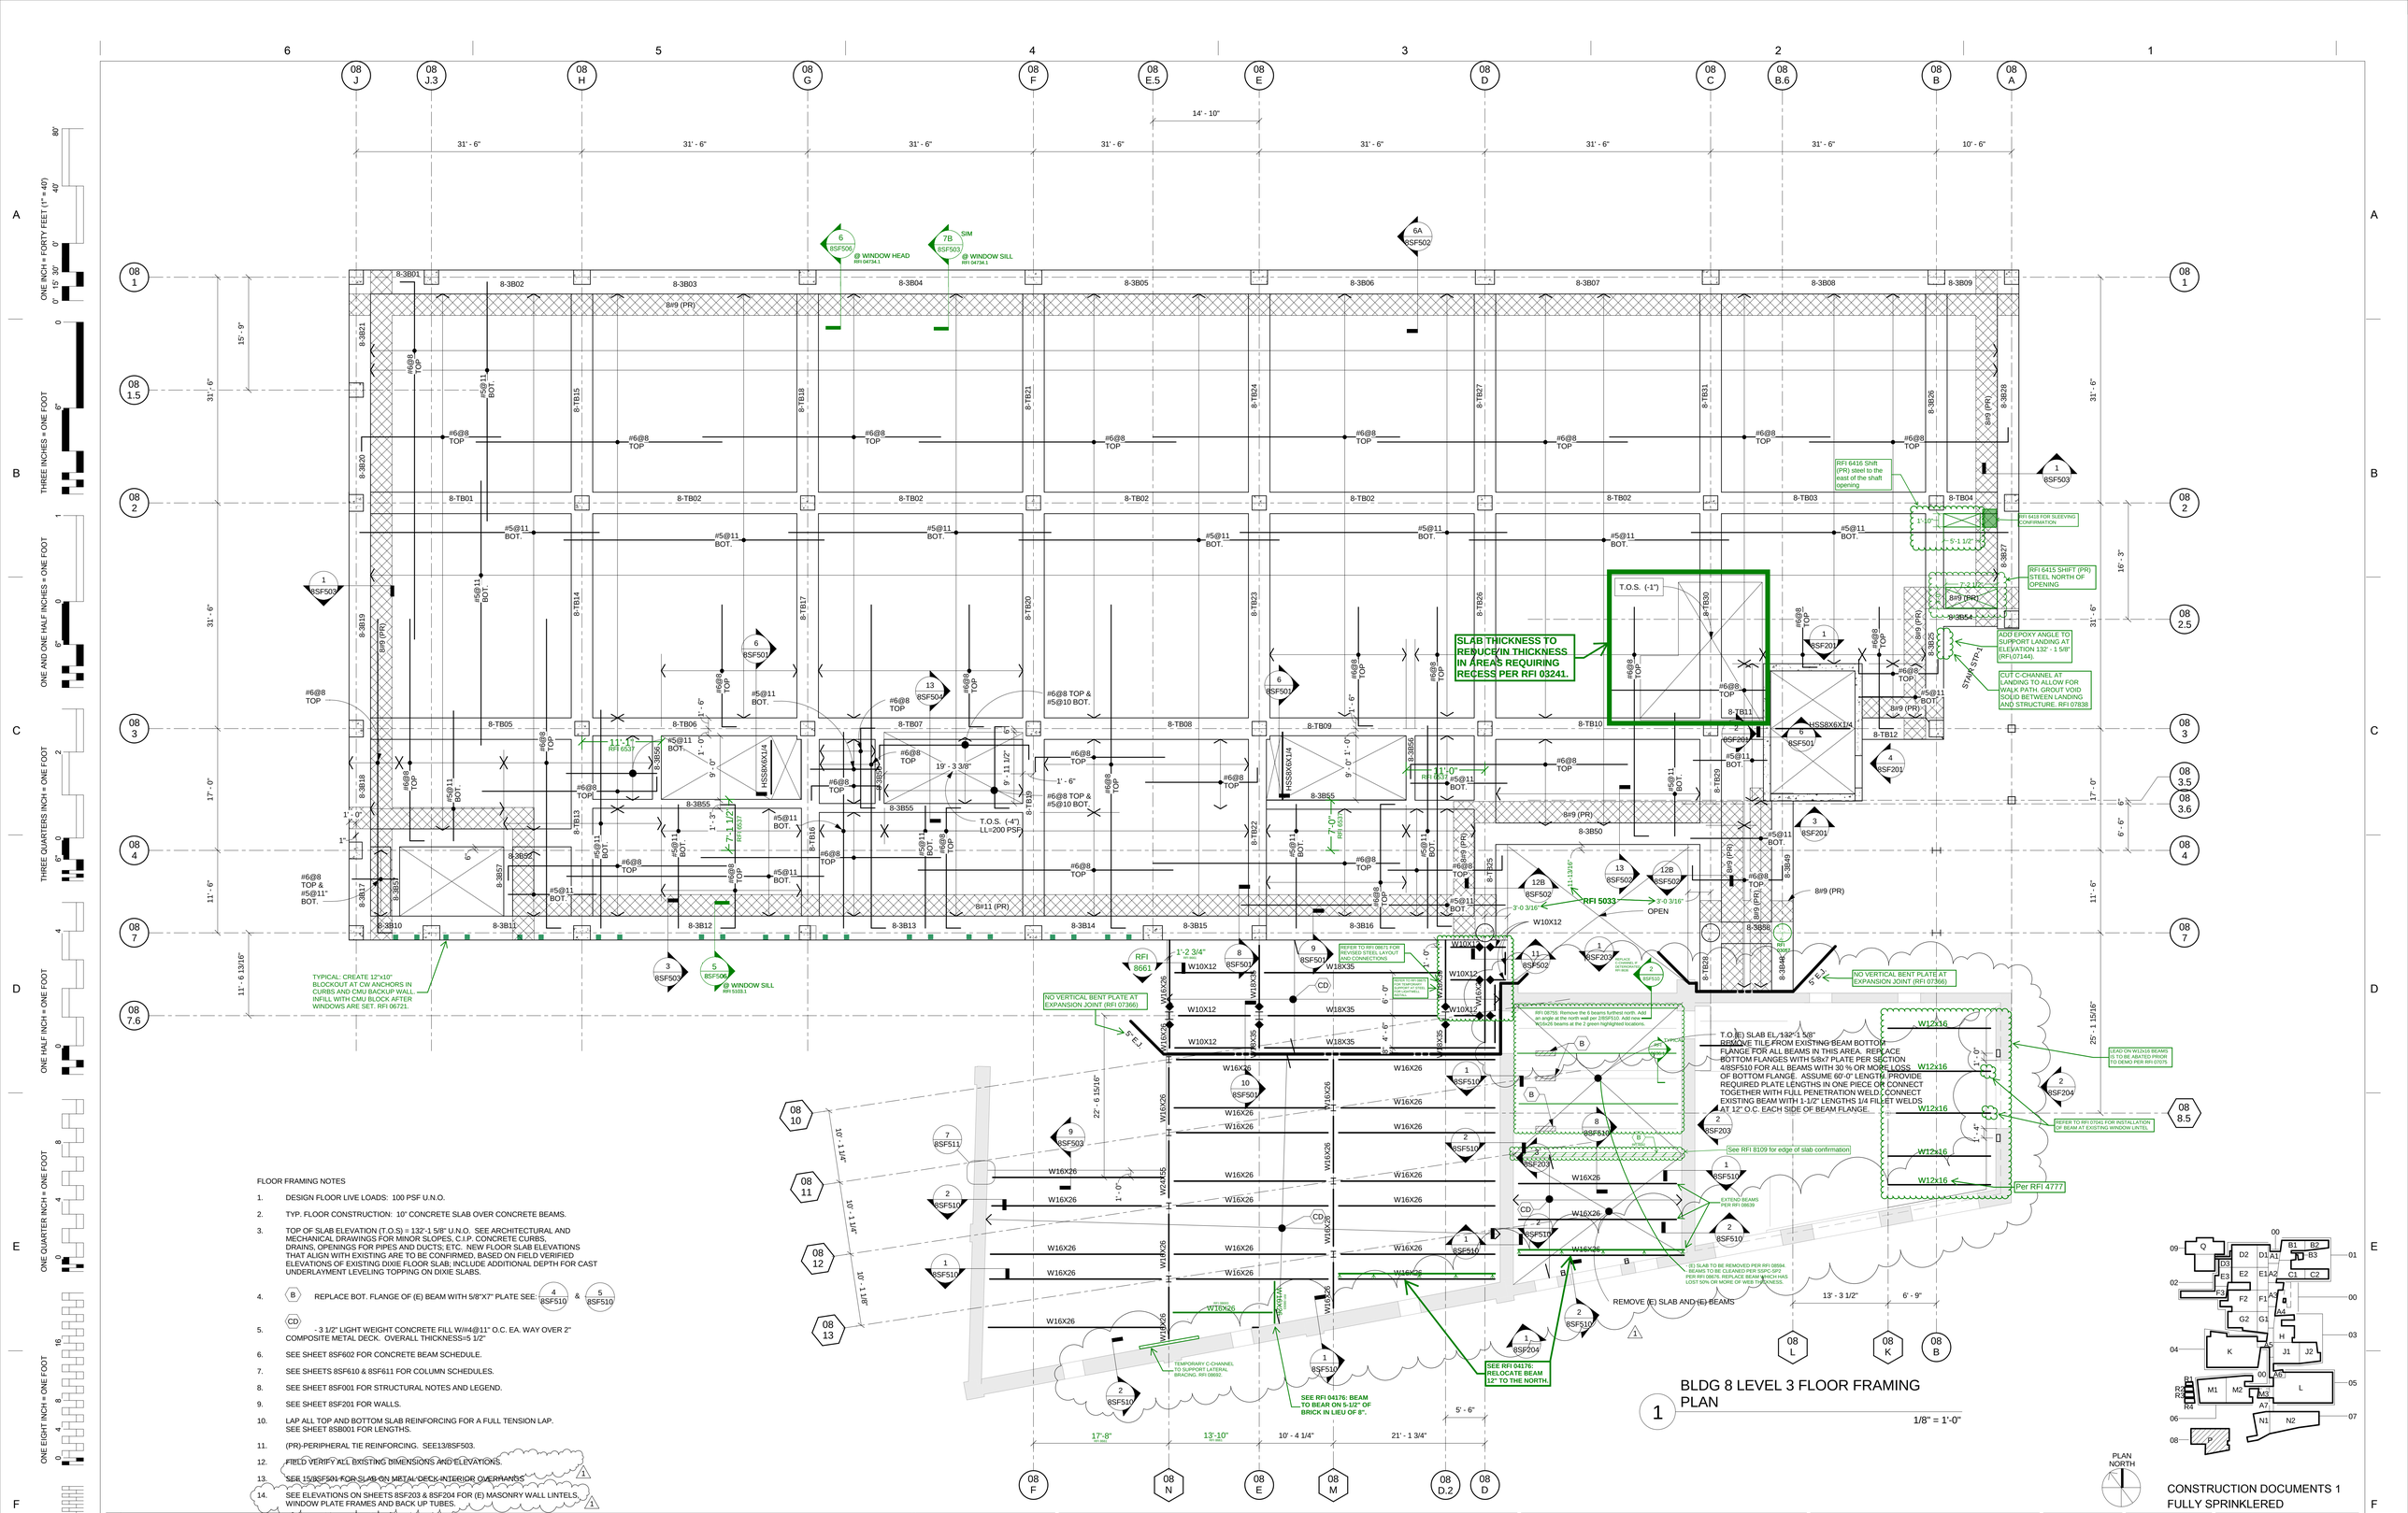
ONE INCH = FORTY FEET (1" = 40')
THREE INCHES = ONE FOOT
ONE AND ONE HALF INCHES = ONE FOOT
THREE QUARTERS INCH = ONE FOOT
ONE HALF INCH = ONE FOOT
ONE QUARTER INCH = ONE FOOT
ONE EIGHT INCH = ONE FOOT
ONE SIXTEENTH INCH = ONE FOOT
6
5
4
3
2
1
08 J
08 J.3
08 H
08 G
08 F
08 E.5
08 E
08 D
08 C
08 B.6
08 B
08 A
14' - 10"
31' - 6"
31' - 6"
31' - 6"
31' - 6"
31' - 6"
31' - 6"
31' - 6"
31' - 6"
10' - 6"
6SF506 @ WINDOW HEAD RFI 04734.1
7B 6SF503 SIM @ WINDOW SILL RFI 04734.1
6A 6SF502
08 1
08 1.5
08 2
08 3
08 4
08 7
08 7.6
08 10
08 11
08 12
08 13
08 2.5
08 3.5
08 3.6
08 8.5
08 L
08 K
08 B
08 M
08 N
08 D.2
15' - 9"
17' - 0"
11' - 6"
11' - 6 13/16"
16' - 3"
6' - 6"
25' - 1 15/16"
22' - 6 15/16"
10' - 1 1/4"
10' - 1 1/4"
10' - 1 1/8"
8-3B01
8-3B02
8-3B03
8-3B04
8-3B05
8-3B06
8-3B07
8-3B08
8-3B09
8-3B21
8-3B20
8-3B19
8-3B18
8-3B17
8-3B10
8-3B11
8-3B12
8-3B13
8-3B14
8-3B15
8-3B16
8-3B26
8-3B28
8-3B27
8-3B54
8-3B25
8-3B49
8-3B58
8-3B50
8-3B55
8-3B56
8-3B57
8-3B59
8-TB01
8-TB02
8-TB03
8-TB04
8-TB05
8-TB06
8-TB07
8-TB08
8-TB09
8-TB10
8-TB11
8-TB12
8-TB13
8-TB14
8-TB15
8-TB16
8-TB17
8-TB18
8-TB19
8-TB20
8-TB21
8-TB22
8-TB23
8-TB24
8-TB25
8-TB26
8-TB27
8-TB28
8-TB29
8-TB30
8-TB31
8#9 (PR)
8#11 (PR)
#6@8 TOP
#5@11 BOT.
#6@8 TOP & #5@10 BOT.
#6@8 TOP & #5@11" BOT.
1" - 0"
1' - 6"
1' - 3"
1' - 0"
6"
9' - 0"
9' - 11 1/2"
19' - 3 3/8"
7' - 1 1/2"
11' - 1"
7' - 0"
T.O.S. (-4") LL=200 PSF
T.O.S. (-1")
HSS8X6X1/4
HSS8X6X1/4
W10X12
W18X35
W16X26
W16X26
W16X26