

ONE INCH = FORTY FEET (1" = 40')

THREE INCHES = ONE FOOT

ONE AND ONE HALF INCHES = ONE FOOT


THREE QUARTERS INCH = ONE FOOT

ONE HALF INCH = ONE FOOT

ONE QUARTER INCH = ONE FOOT

ONE EIGHT INCH = ONE FOOT

ONE SIXTEENTH INCH = ONE FOOT

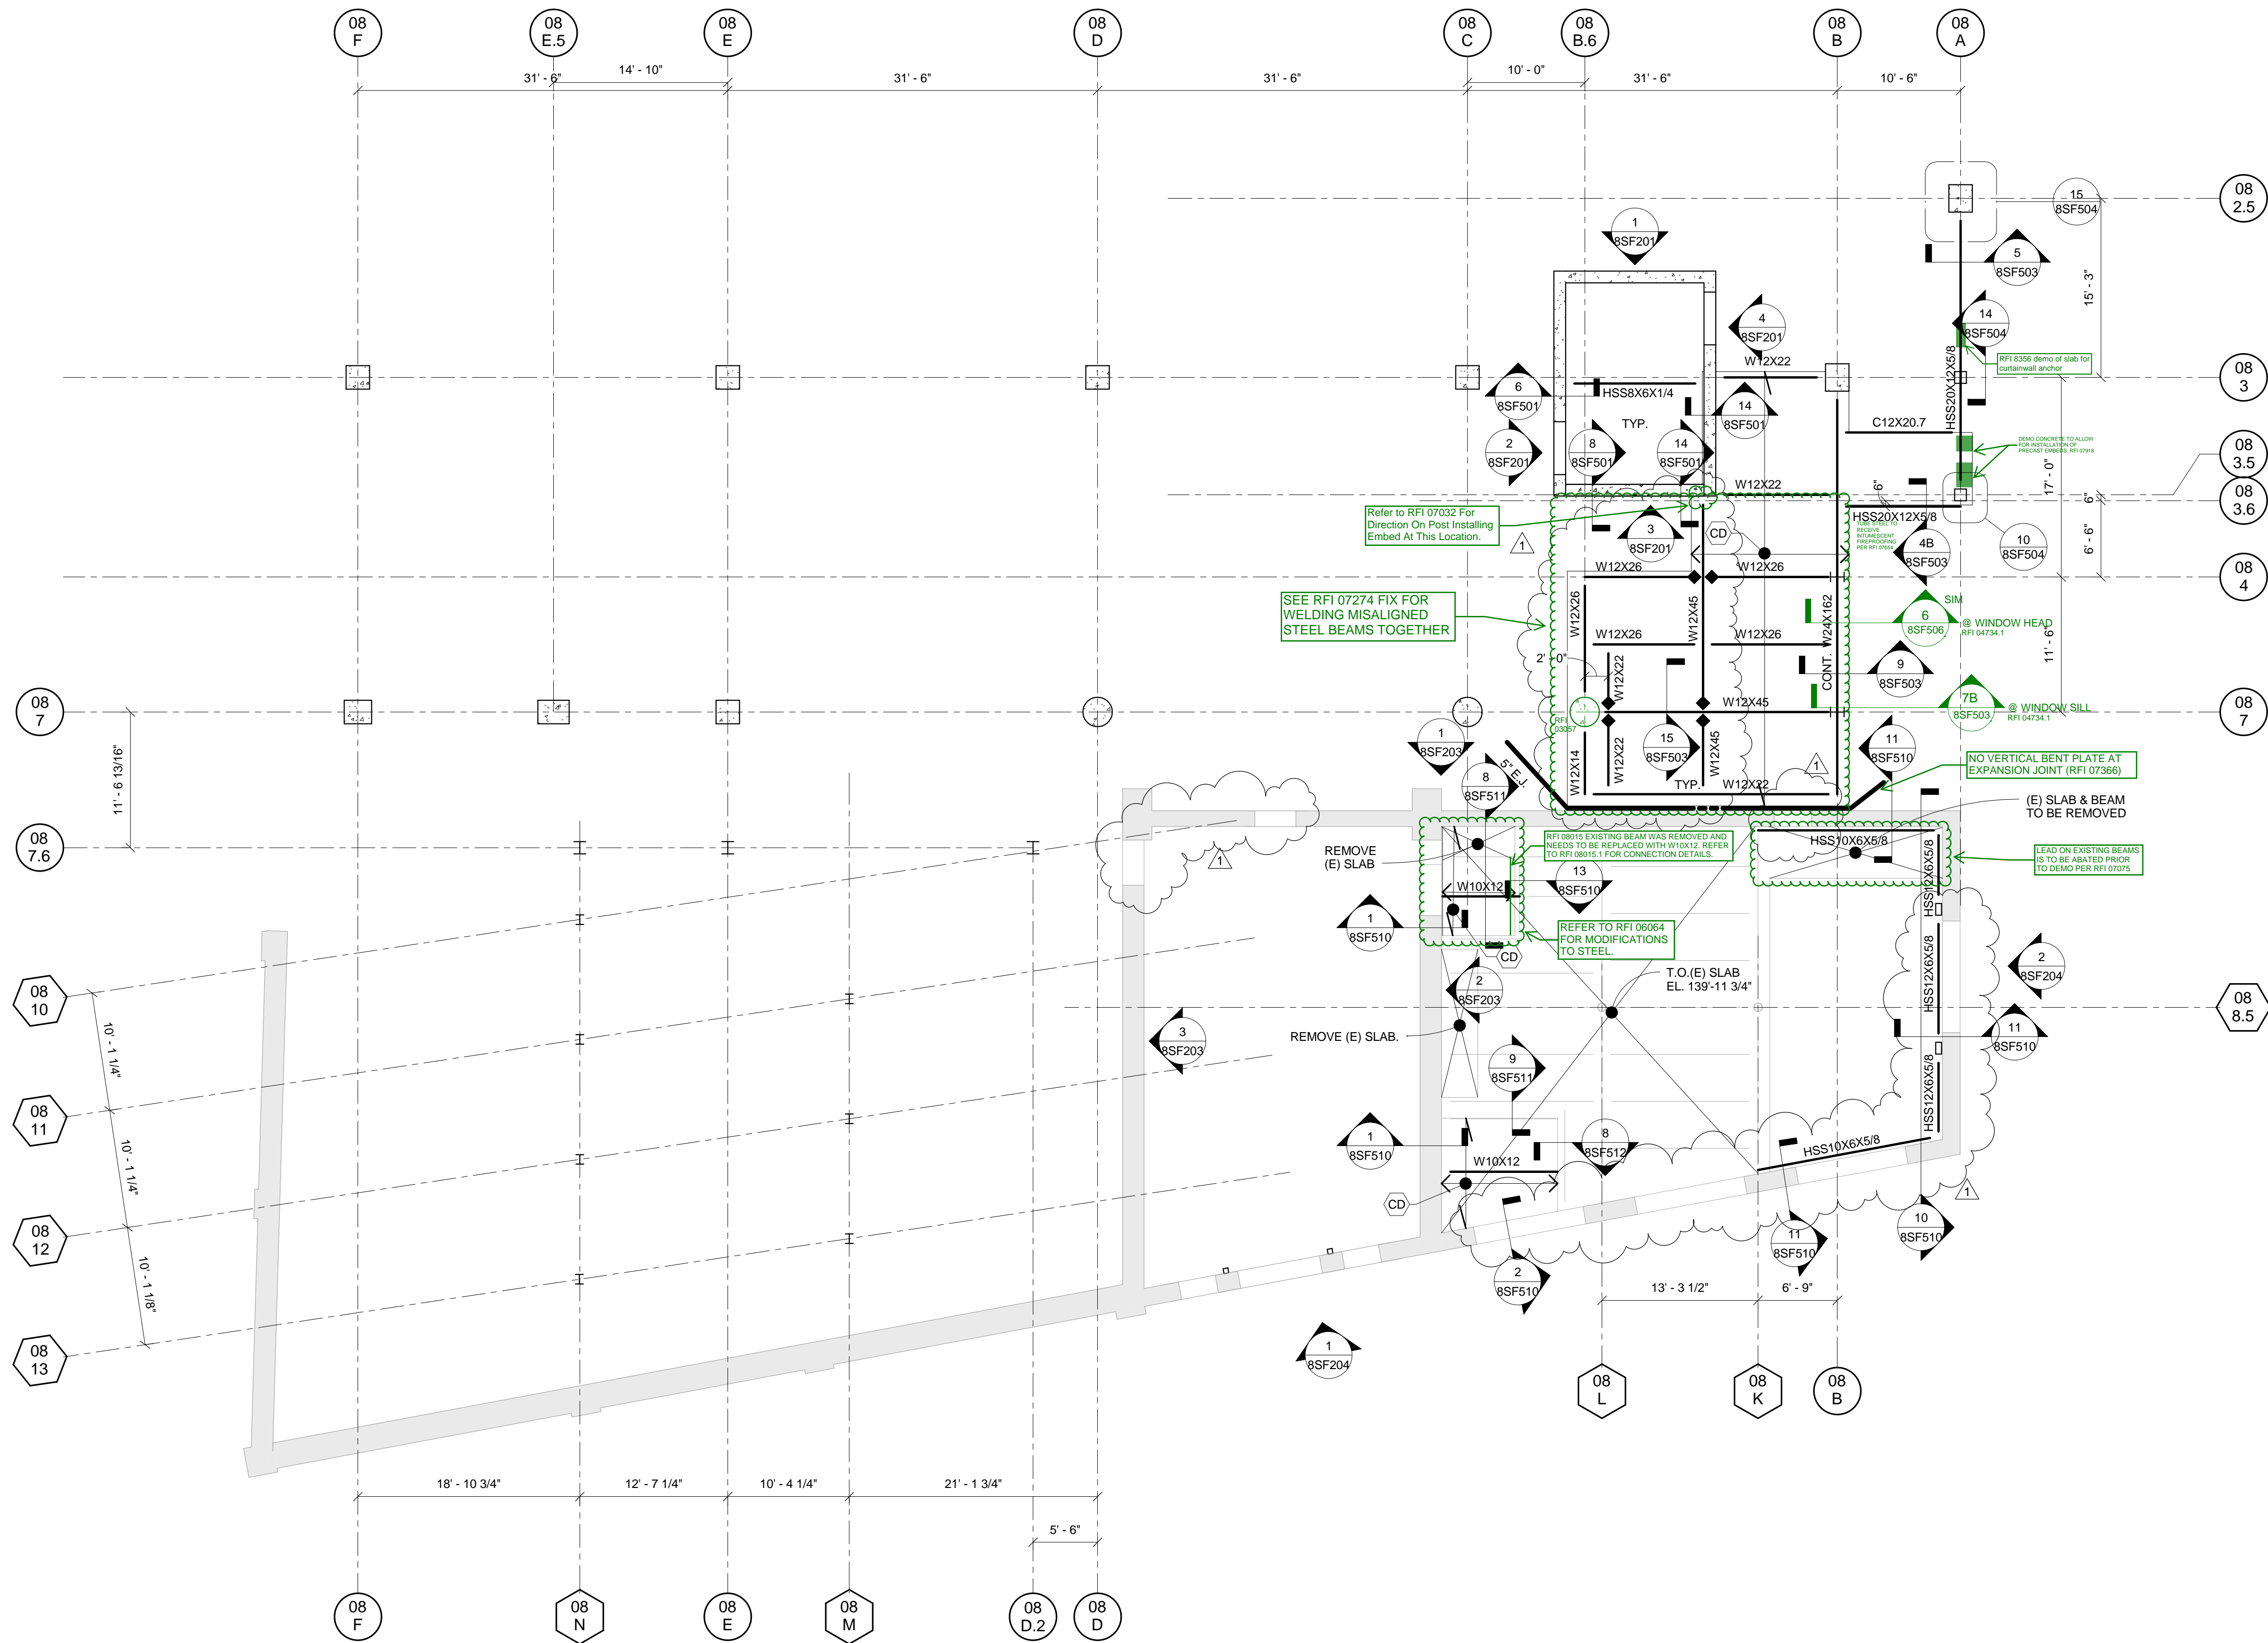

DIXIE Level 3.5 FLOOR FRAMING PLAN


1

1/8" = 1'-0"

- FLOOR FRAMING NOTES
- DESIGN FLOOR LIVE LOADS: 100 PSF U.N.O.
 - TOP OF SLAB ELEVATION (T.O.S) = 139'-11 3/4" U.N.O. SEE ARCHITECTURAL AND MECHANICAL DRAWINGS FOR MINOR SLOPES, C.I.P. CONCRETE CURBS, DRAINS, OPENINGS FOR PIPES AND DUCTS, ETC. NEW FLOOR SLAB ELEVATIONS THAT ALIGN WITH EXISTING ARE TO BE CONFIRMED, BASED ON FIELD VERIFIED ELEVATIONS OF EXISTING DIXIE FLOOR SLAB. INCLUDE ADDITIONAL DEPTH FOR CAST UNDERLAYMENT LEVELING TOPPING ON DIXIE SLABS.
 - (CD) - 3 1/2" LIGHT WEIGHT CONCRETE FILL W/ #4 @ 11" O.C. EA. WAY OVER 2" COMPOSITE METAL DECK. OVERALL THICKNESS=5 1/2"
 - SEE SHEETS 8SF610 & 8SF611 FOR COLUMN SCHEDULES.
 - SEE SHEET 8SB001 FOR STRUCTURAL NOTES AND LEGEND.
 - SEE SHEET 8SF201 FOR WALLS.
 - (PR)-PERIPHERAL TIE REINFORCING. SEE 8BSF504.
 - FIELD VERIFY ALL EXISTING DIMENSIONS AND ELEVATIONS.
 - SEE 15/8SF501 FOR SLAB ON METAL DECK FOR OVERHANGS.
 - SEE ELEVATIONS ON SHEETS 8SF203 & 8SF204 FOR (E) MASONRY WALL, LINTELS, WINDOW PLATE FRAMES AND BACK UP TUBES.

		CONSULTANTS: DESMAN ASSOCIATES / PARKING CODE CONSULTANTS, INC. / CODE CONSULTANT THE SEXTANT GROUP / AV & ACOUSTICAL HAMMER DESIGN ASSOCIATES / FOOD SERVICE PYBURN & ODOM / ABATEMENT TATA & HOWARD / TANK CONSULTANT I.S.C. GROUP, INC. / IRRIGATION DAN EUSER WATER ARCHITECTURE, INC. / WATER FEATURE
1 ADDENDUM #1	09/21/12	
REVISIONS:	DATE	

PLAN NORTH

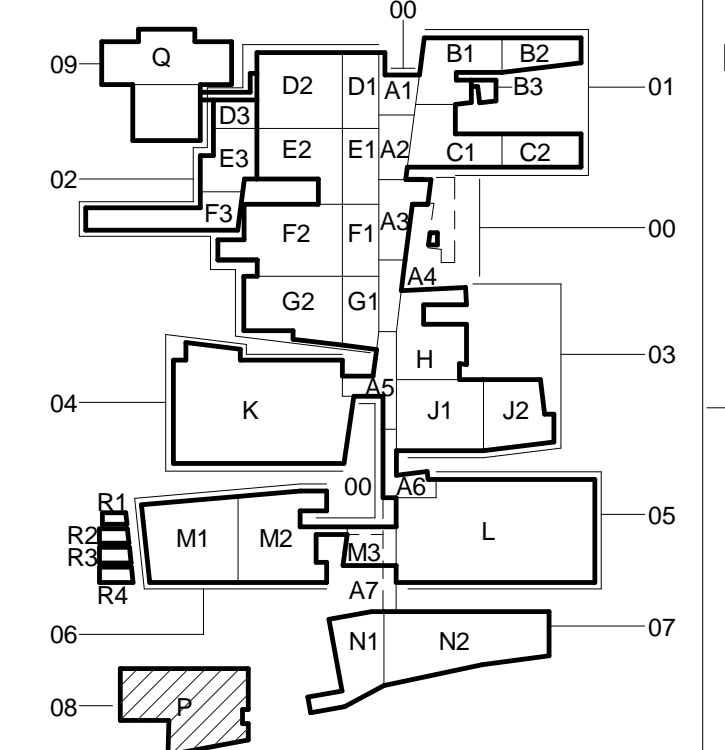

CONSTRUCTION DOCUMENTS 1
FULLY SPRINKLERED