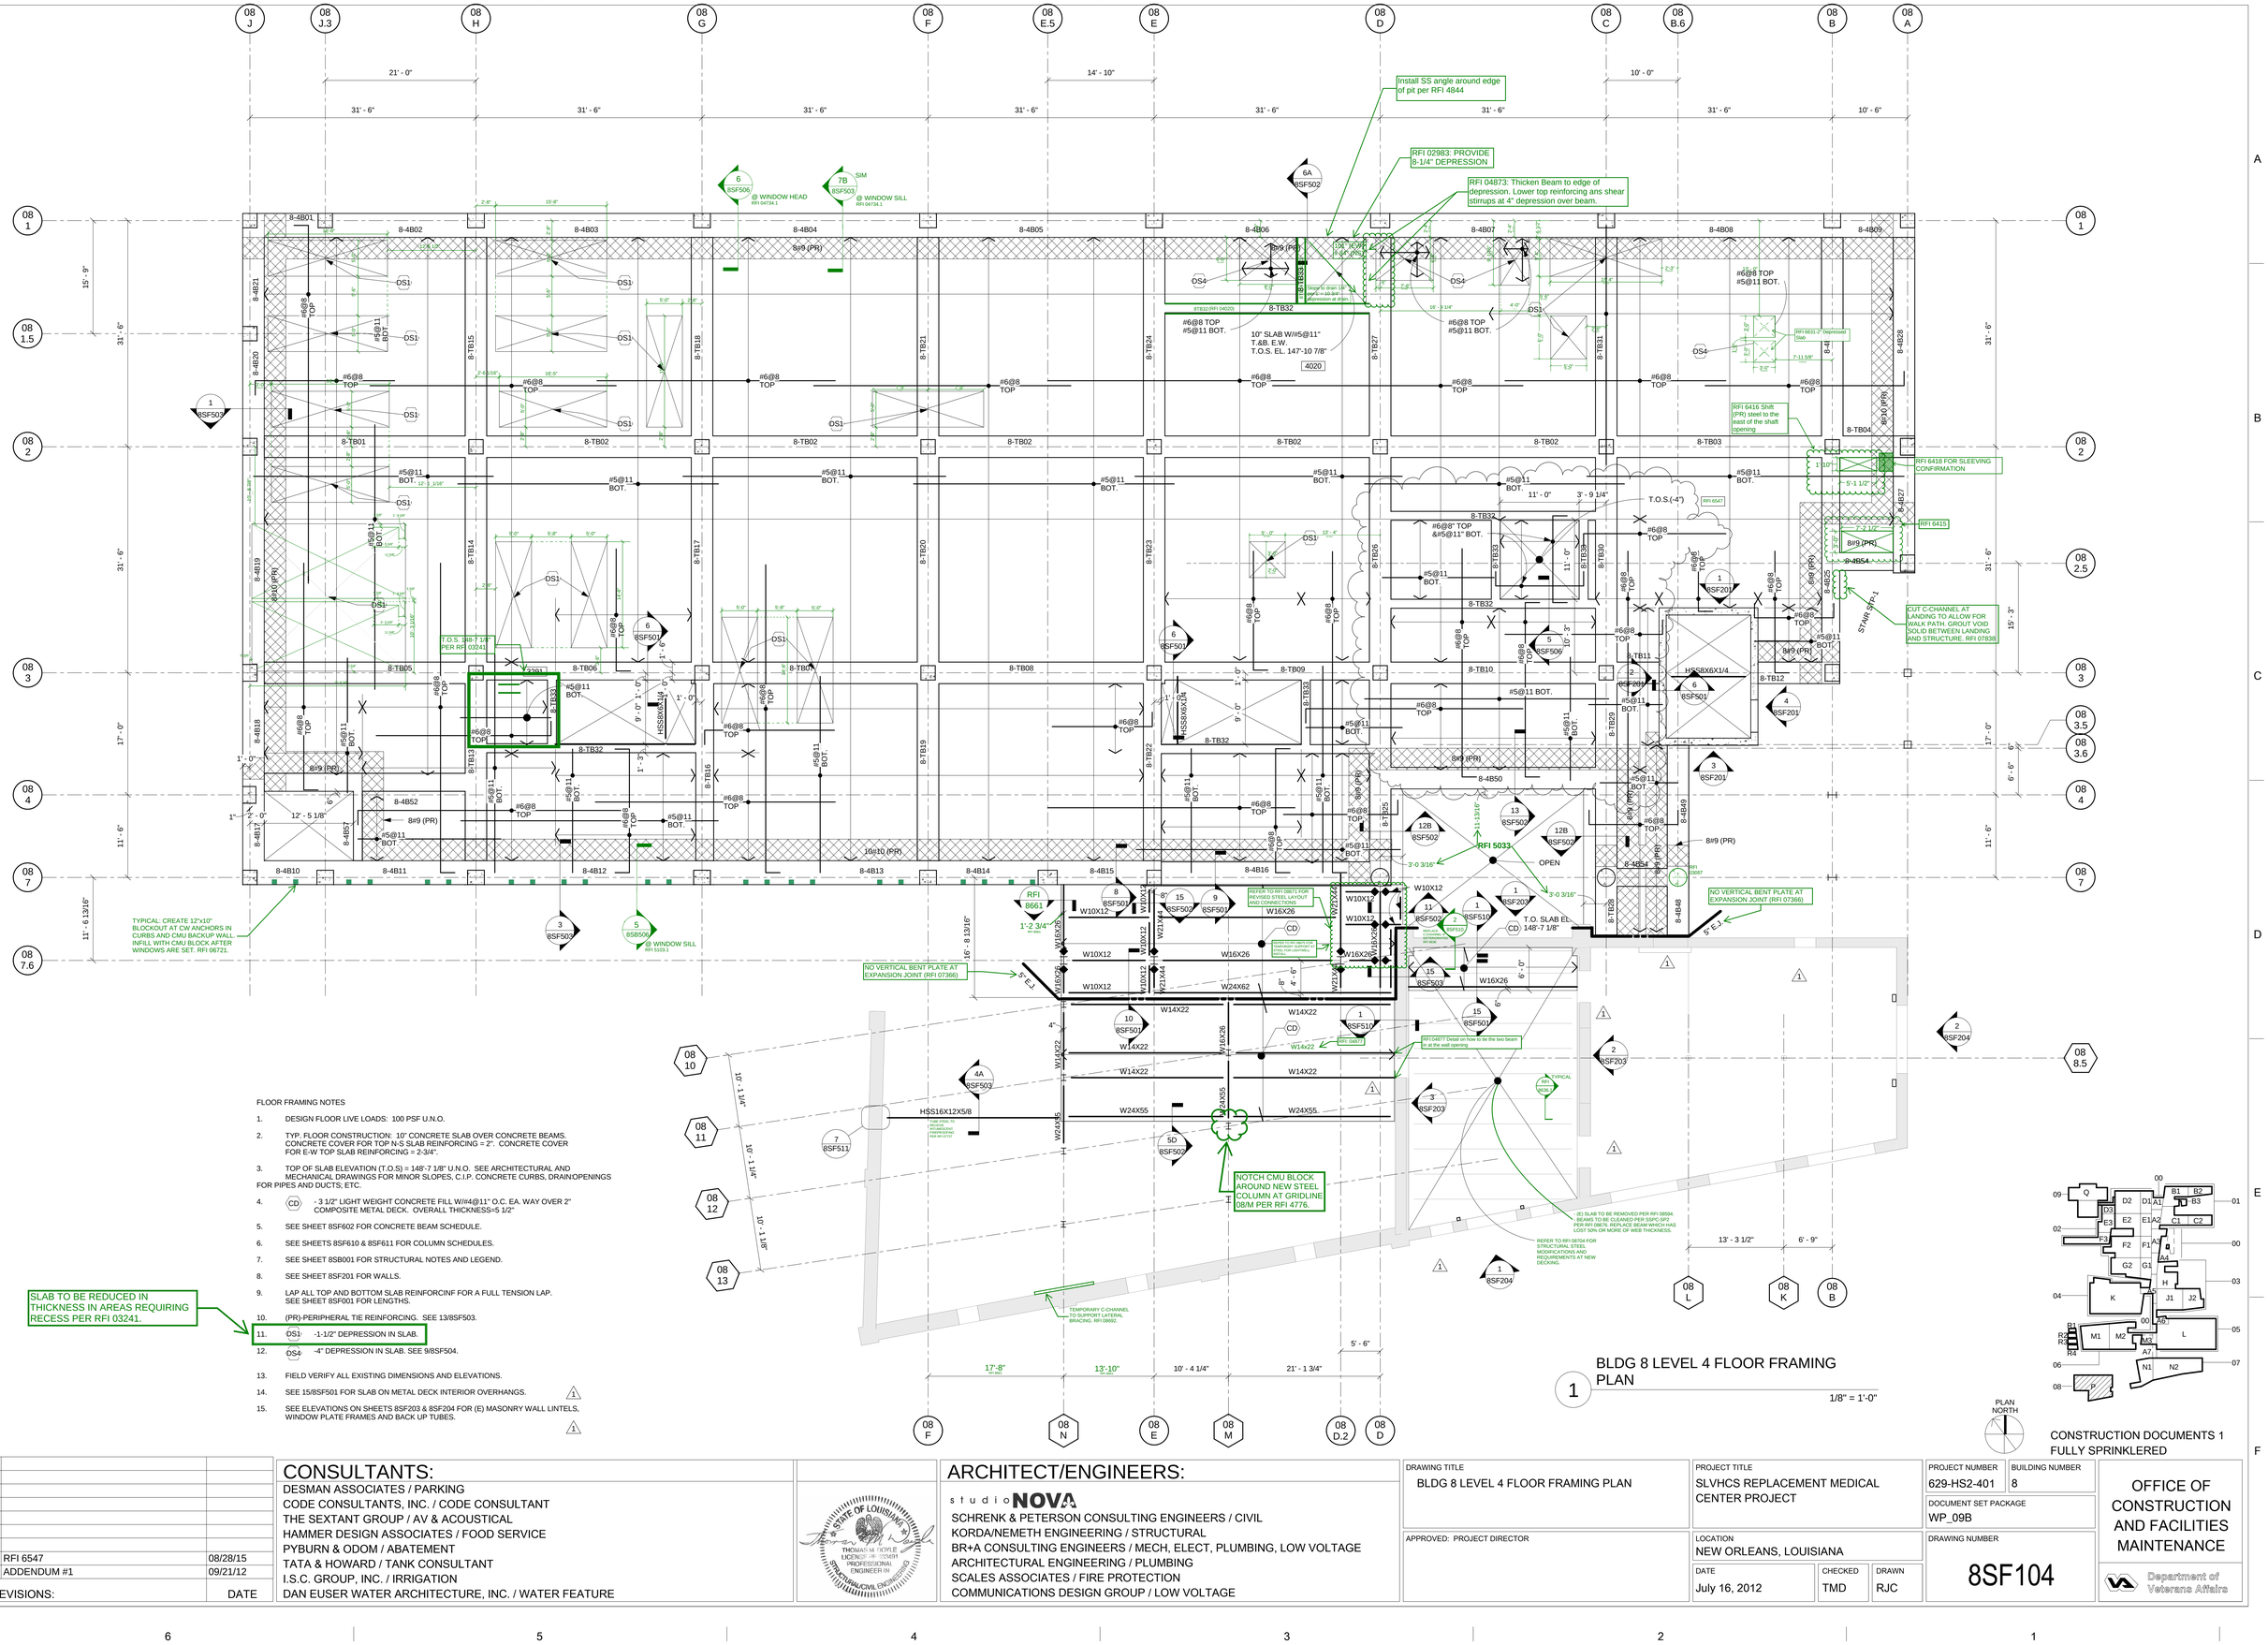

FLOOR FRAMING NOTES

1. DESIGN FLOOR LIVE LOADS: 100 PSF U.N.O.
2. TYP. FLOOR CONSTRUCTION: 10" CONCRETE SLAB OVER CONCRETE BEAMS. CONCRETE COVER FOR TOP N-S SLAB REINFORCING = 2". CONCRETE COVER FOR E-W TOP SLAB REINFORCING = 2-3/4".
3. TOP OF SLAB ELEVATION (T.O.S) = 148'-7 1/8" U.N.O. SEE ARCHITECTURAL AND MECHANICAL DRAWINGS FOR MINOR SLOPES, C.I.P. CONCRETE CURBS, DRAIN/OPENINGS FOR PIPES AND DUCTS; ETC.
4. (CD) - 3 1/2" LIGHT WEIGHT CONCRETE FILL W//#4@11" O.C. EA. WAY OVER 2" COMPOSITE METAL DECK. OVERALL THICKNESS=5 1/2"
5. SEE SHEET 8SF602 FOR CONCRETE BEAM SCHEDULE.
6. SEE SHEETS 8SF610 & 8SF611 FOR COLUMN SCHEDULES.
7. SEE SHEET 8SB001 FOR STRUCTURAL NOTES AND LEGEND.
8. SEE SHEET 8SF201 FOR WALLS.
9. LAP ALL TOP AND BOTTOM SLAB REINFORCINF FOR A FULL TENSION LAP. SEE SHEET 8SF001 FOR LENGTHS.
10. (PR)-PERIPHERAL TIE REINFORCING. SEE 13/8SF503.
11. OS1 -1-1/2" DEPRESSION IN SLAB.
12. OS4 -4" DEPRESSION IN SLAB. SEE 9/8SF504.
13. FIELD VERIFY ALL EXISTING DIMENSIONS AND ELEVATIONS.
14. SEE 15/8SF501 FOR SLAB ON METAL DECK INTERIOR OVERHANGS. 1
15. SEE ELEVATIONS ON SHEETS 8SF203 & 8SF204 FOR (E) MASONRY WALL LINTELS, WINDOW PLATE FRAMES AND BACK UP TUBES. 1

BLDG 8 LEVEL 4 FLOOR FRAMING PLAN

1 — 1/8" = 1'-0"

PLAN NORTH

CONSTRUCTION DOCUMENTS 1
FULLY SPRINKLERED

7	RFI 6547	08/28/15
1	ADDENDUM #1	09/21/12
REVISIONS:		DATE

CONSULTANTS:
DESMAN ASSOCIATES / PARKING
CODE CONSULTANTS, INC. / CODE CONSULTANT
THE SEXTANT GROUP / AV & ACOUSTICAL
HAMMER DESIGN ASSOCIATES / FOOD SERVICE
PYBURN & ODOM / ABATEMENT
TATA & HOWARD / TANK CONSULTANT
I.S.C. GROUP, INC. / IRRIGATION
DAN EUSER WATER ARCHITECTURE, INC. / WATER FEATURE

STATE OF LOUISIANA — THOMAS M. DOYLE — LICENSE NO. 29703 — PROFESSIONAL ENGINEER IN — STRUCTURAL ENGINEERING

ARCHITECT/ENGINEERS:
studio NOVA
SCHRENK & PETERSON CONSULTING ENGINEERS / CIVIL
KORDA/NEMETH ENGINEERING / STRUCTURAL
BR+A CONSULTING ENGINEERS / MECH, ELECT, PLUMBING, LOW VOLTAGE
ARCHITECTURAL ENGINEERING / PLUMBING
SCALES ASSOCIATES / FIRE PROTECTION
COMMUNICATIONS DESIGN GROUP / LOW VOLTAGE

DRAWING TITLE	BLDG 8 LEVEL 4 FLOOR FRAMING PLAN
APPROVED: PROJECT DIRECTOR	
PROJECT TITLE	SLVHCS REPLACEMENT MEDICAL CENTER PROJECT
LOCATION	NEW ORLEANS, LOUISIANA
DATE	July 16, 2012
CHECKED	TMD
DRAWN	RJC
PROJECT NUMBER	629-HS2-401
BUILDING NUMBER	8
DOCUMENT SET PACKAGE	WP_09B
DRAWING NUMBER	8SF104

OFFICE OF CONSTRUCTION AND FACILITIES MAINTENANCE
Department of Veterans Affairs