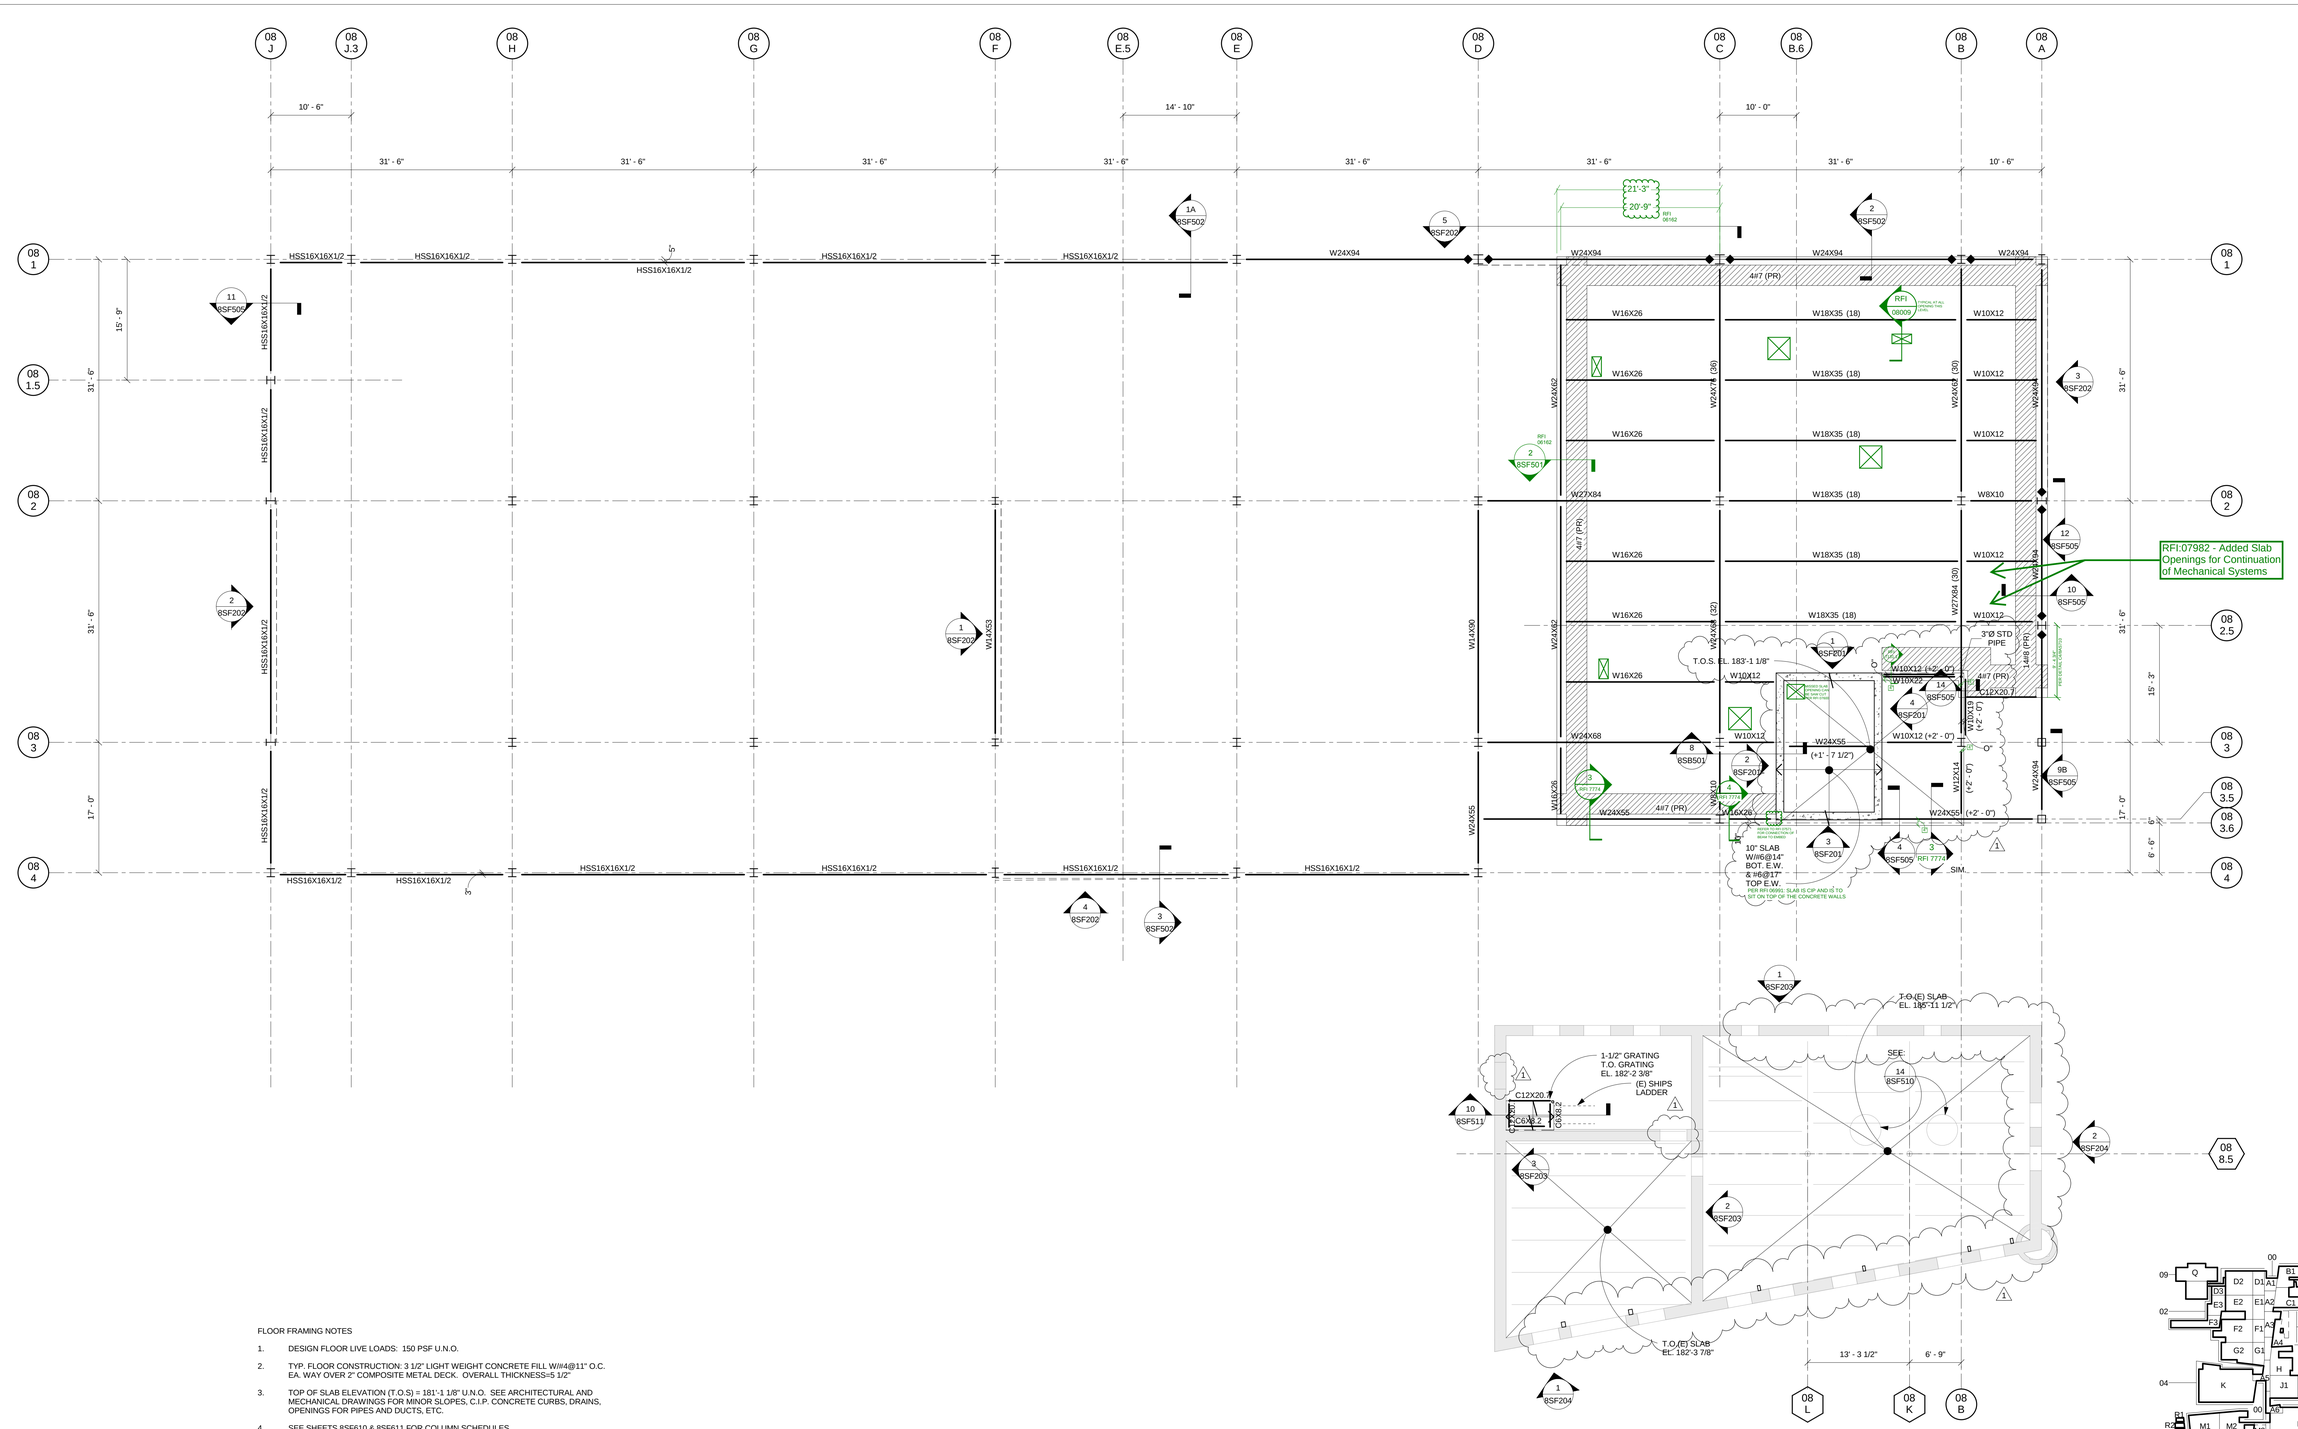

FLOOR FRAMING NOTES

1. DESIGN FLOOR LIVE LOADS: 150 PSF U.N.O.
2. TYP. FLOOR CONSTRUCTION: 3 1/2" LIGHT WEIGHT CONCRETE FILL W//#4@11" O.C. EA. WAY OVER 2" COMPOSITE METAL DECK. OVERALL THICKNESS=5 1/2"
3. TOP OF SLAB ELEVATION (T.O.S) = 181'-1 1/8" U.N.O. SEE ARCHITECTURAL AND MECHANICAL DRAWINGS FOR MINOR SLOPES, C.I.P. CONCRETE CURBS, DRAINS, OPENINGS FOR PIPES AND DUCTS, ETC.
4. SEE SHEETS 8SF610 & 8SF611 FOR COLUMN SCHEDULES.
5. SEE SHEET 8SB001 FOR STRUCTURAL NOTES AND LEGEND.
6. SEE SHEET 8SF201 FOR WALLS.
7. (PR)-PERIPHERAL TIE REINFORCING. SEE5/8SF504.
8. FIELD VERIFY ALL EXISTING DIMENSIONS AND ELEVATIONS.
9. SEE 15/8SF501 FOR SLAB ON METAL DECK INTERIOR OVERHANGS.
10. SEE ELEVATIONS ON SHEETS 8SF203 & 8SF204 FOR (E) MASONRY WALL LINTELS, WINDOW PLATE FRAMES AND BACK UP TUBES.

1 MEZZANINE FRAMING PLAN

1/8" = 1'-0"

PLAN NORTH

CONSTRUCTION DOCUMENTS 1
FULLY SPRINKLERED

1	ADDENDUM #1	09/21/12
REVISIONS:		DATE

CONSULTANTS:

DESMAN ASSOCIATES / PARKING
CODE CONSULTANTS, INC. / CODE CONSULTANT
THE SEXTANT GROUP / AV & ACOUSTICAL
HAMMER DESIGN ASSOCIATES / FOOD SERVICE
PYBURN & ODOM / ABATEMENT
TATA & HOWARD / TANK CONSULTANT
I.S.C. GROUP, INC. / IRRIGATION
DAN EUSER WATER ARCHITECTURE, INC. / WATER FEATURE

STATE OF LOUISIANA — THOMAS M. COYLE — LICENSE NO. 33691 — PROFESSIONAL ENGINEER IN STRUCTURAL/CIVIL ENGINEERING

ARCHITECT/ENGINEERS:

studio NOVA
SCHRENK & PETERSON CONSULTING ENGINEERS / CIVIL
KORDA/NEMETH ENGINEERING / STRUCTURAL
BR+A CONSULTING ENGINEERS / MECH, ELECT, PLUMBING, LOW VOLTAGE
ARCHITECTURAL ENGINEERING / PLUMBING
SCALES ASSOCIATES / FIRE PROTECTION
COMMUNICATIONS DESIGN GROUP / LOW VOLTAGE

DRAWING TITLE	BLDG 8 MEZZANINE FRAMING PLAN
APPROVED: PROJECT DIRECTOR	Todd Sanders
PROJECT TITLE	SLVHCS REPLACEMENT MEDICAL CENTER PROJECT
LOCATION	NEW ORLEANS, LOUISIANA
DATE	July 16, 2012
CHECKED	TMD
DRAWN	RJC
PROJECT NUMBER	629-HS2-401
BUILDING NUMBER	8
DOCUMENT SET PACKAGE	WP_09B
DRAWING NUMBER	8SF105.5

OFFICE OF CONSTRUCTION AND FACILITIES MAINTENANCE

Department of Veterans Affairs