

ONE INCH = FORTY FEET (1" = 40')

THREE INCHES = ONE FOOT

ONE AND ONE HALF INCHES = ONE FOOT


THREE QUARTERS INCH = ONE FOOT

ONE HALF INCH = ONE FOOT


ONE QUARTER INCH = ONE FOOT

ONE EIGHT INCH = ONE FOOT


ONE SIXTEENTH INCH = ONE FOOT

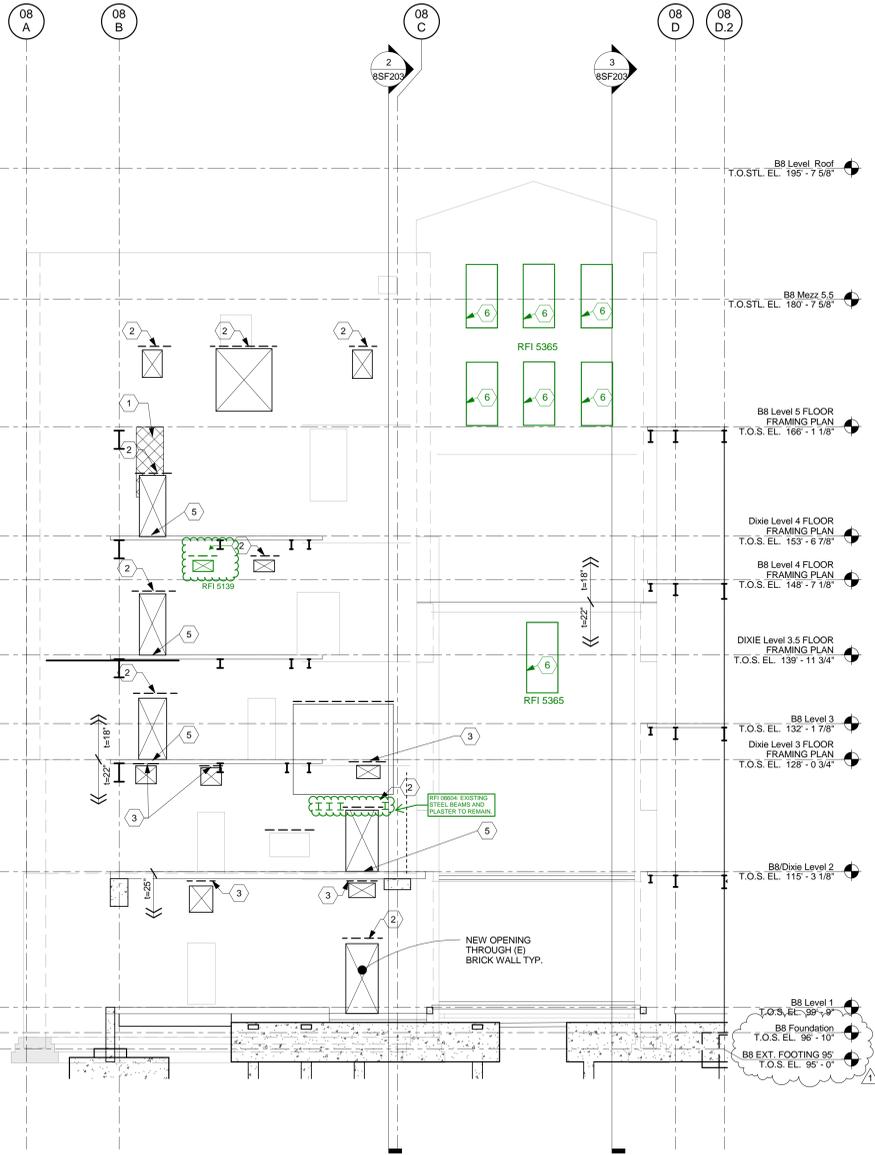

1 NORTH ELEVATION
1/8" = 1'-0"

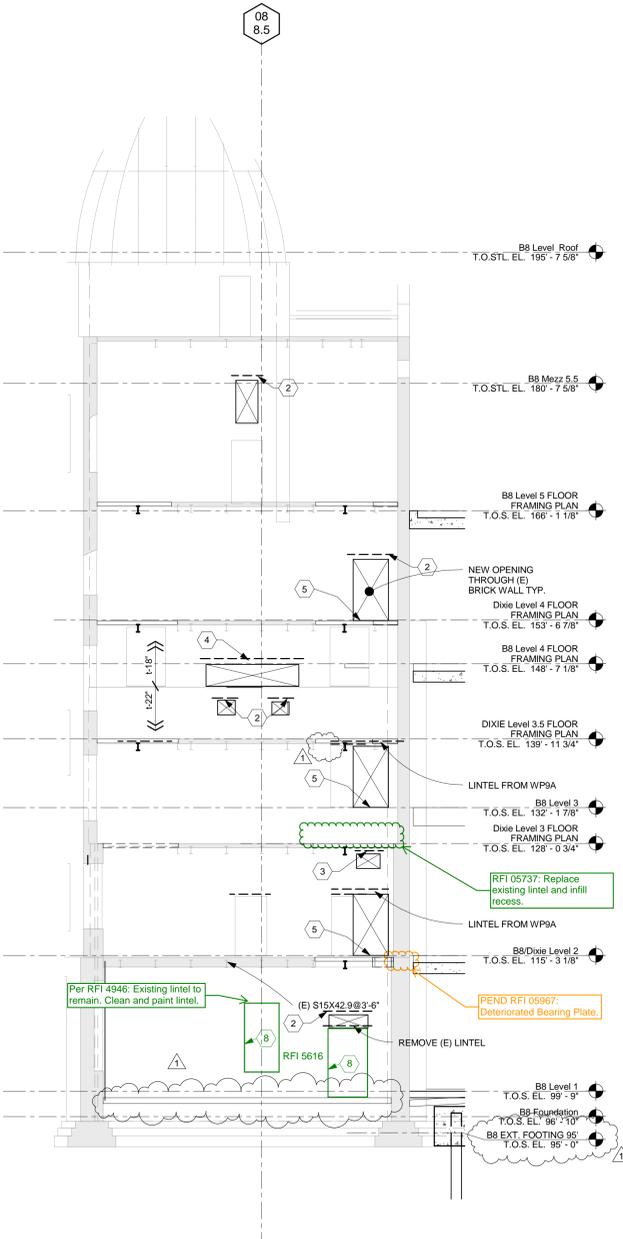

2 EAST CARRIAGEWAY ELEVATION
1/8" = 1'-0"

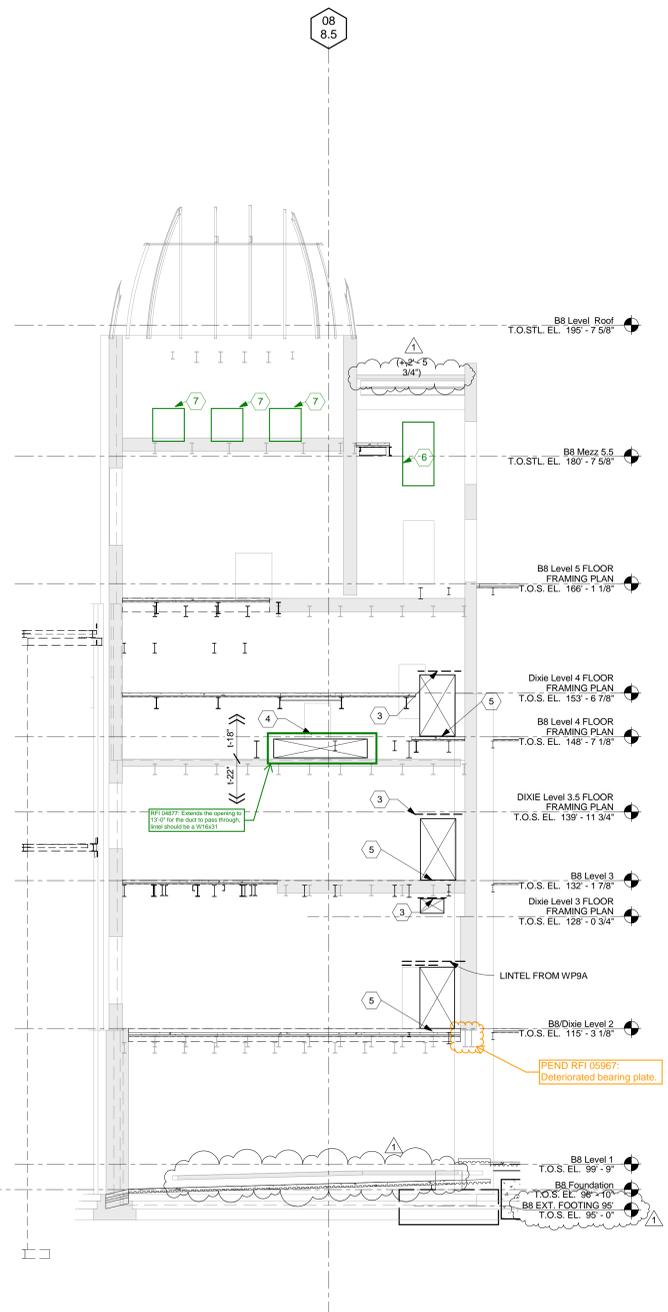

3 WEST CARRIAGEWAY ELEVATION
1/8" = 1'-0"

- CODED NOTES**
- 1 FILL IN (E) OPENING WITH BRICK FOR FULL THICKNESS OF WALL.
 - 2 W8x18 W/ 5/16 BOT. PLATE & 6" BRG. SEE 15/8SF510.
 - 3 W10x22 W/ 5/16 BOT. PLATE & 14" BRG. SEE 16/8SF510.
 - 4 W8x24 W/ 5/16 BOT. PLATE & 12" BRG. ON 3/4x12x12 BRG. PLATE SEE: 15/8SF510
 - 5 SEE 14/8SF512 FOR FLOOR DETAIL AT NEW OPENINGS IN (E) BRICK WALLS.
 - 6 3/8x7 1/2 PLATE FRAME W/ 3/4" ADHESIVE ANCHORS @ 12" O.C. PER 11/8SF512
 - 7 3/8x7 1/2 PLATE FRAME W/ 3/4" ADHESIVE ANCHORS @ 12" O.C. PER 10B/8SF512
 - 8 3/8x10 PLATE FRAME W/ 3/4" ADHESIVE ANCHORS @ 8" O.C. PER 10A/8SF512

CONSULTANTS:
 DESMAN ASSOCIATES / PARKING
 CODE CONSULTANTS, INC. / CODE CONSULTANT
 THE SEXTANT GROUP / AV & ACOUSTICAL
 HAMMER DESIGN ASSOCIATES / FOOD SERVICE
 PYBURN & ODOM / ABATEMENT
 TATA & HOWARD / TANK CONSULTANT
 I.S.C. GROUP, INC. / IRRIGATION
 DAN EUSER WATER ARCHITECTURE, INC. / WATER FEATURE



ARCHITECT/ENGINEERS:
 studio **NOVA**
 SCHRENK & PETERSON CONSULTING ENGINEERS / CIVIL
 KORDA/NEMETH ENGINEERING / STRUCTURAL
 BR+A CONSULTING ENGINEERS / MECH, ELECT, PLUMBING, LOW VOLTAGE
 ARCHITECTURAL ENGINEERING / PLUMBING
 SCALES ASSOCIATES / FIRE PROTECTION
 COMMUNICATIONS DESIGN GROUP / LOW VOLTAGE

DRAWING TITLE
WALL ELEVATIONS

APPROVED: PROJECT DIRECTOR
Judd Sanders

PROJECT TITLE
SLVHCS REPLACEMENT MEDICAL CENTER PROJECT

LOCATION
NEW ORLEANS, LOUISIANA

DATE
July 16, 2012

CHECKED
TMD

DRAWN
RJC

PROJECT NUMBER
629-HS2-401

BUILDING NUMBER
8

DOCUMENT SET PACKAGE
WP_09B

DRAWING NUMBER
8SF203

CONSTRUCTION DOCUMENTS 1
FULLY SPRINKLERED

OFFICE OF CONSTRUCTION AND FACILITIES MAINTENANCE

Department of Veterans Affairs