

ONE INCH = FORTY FEET (1" = 40')


ONE AND ONE HALF INCHES = ONE FOOT

ONE HALF INCH = ONE FOOT

ONE QUARTER INCH = ONE FOOT

ONE EIGHT INCH = ONE FOOT

ONE SIXTEENTH INCH = ONE FOOT

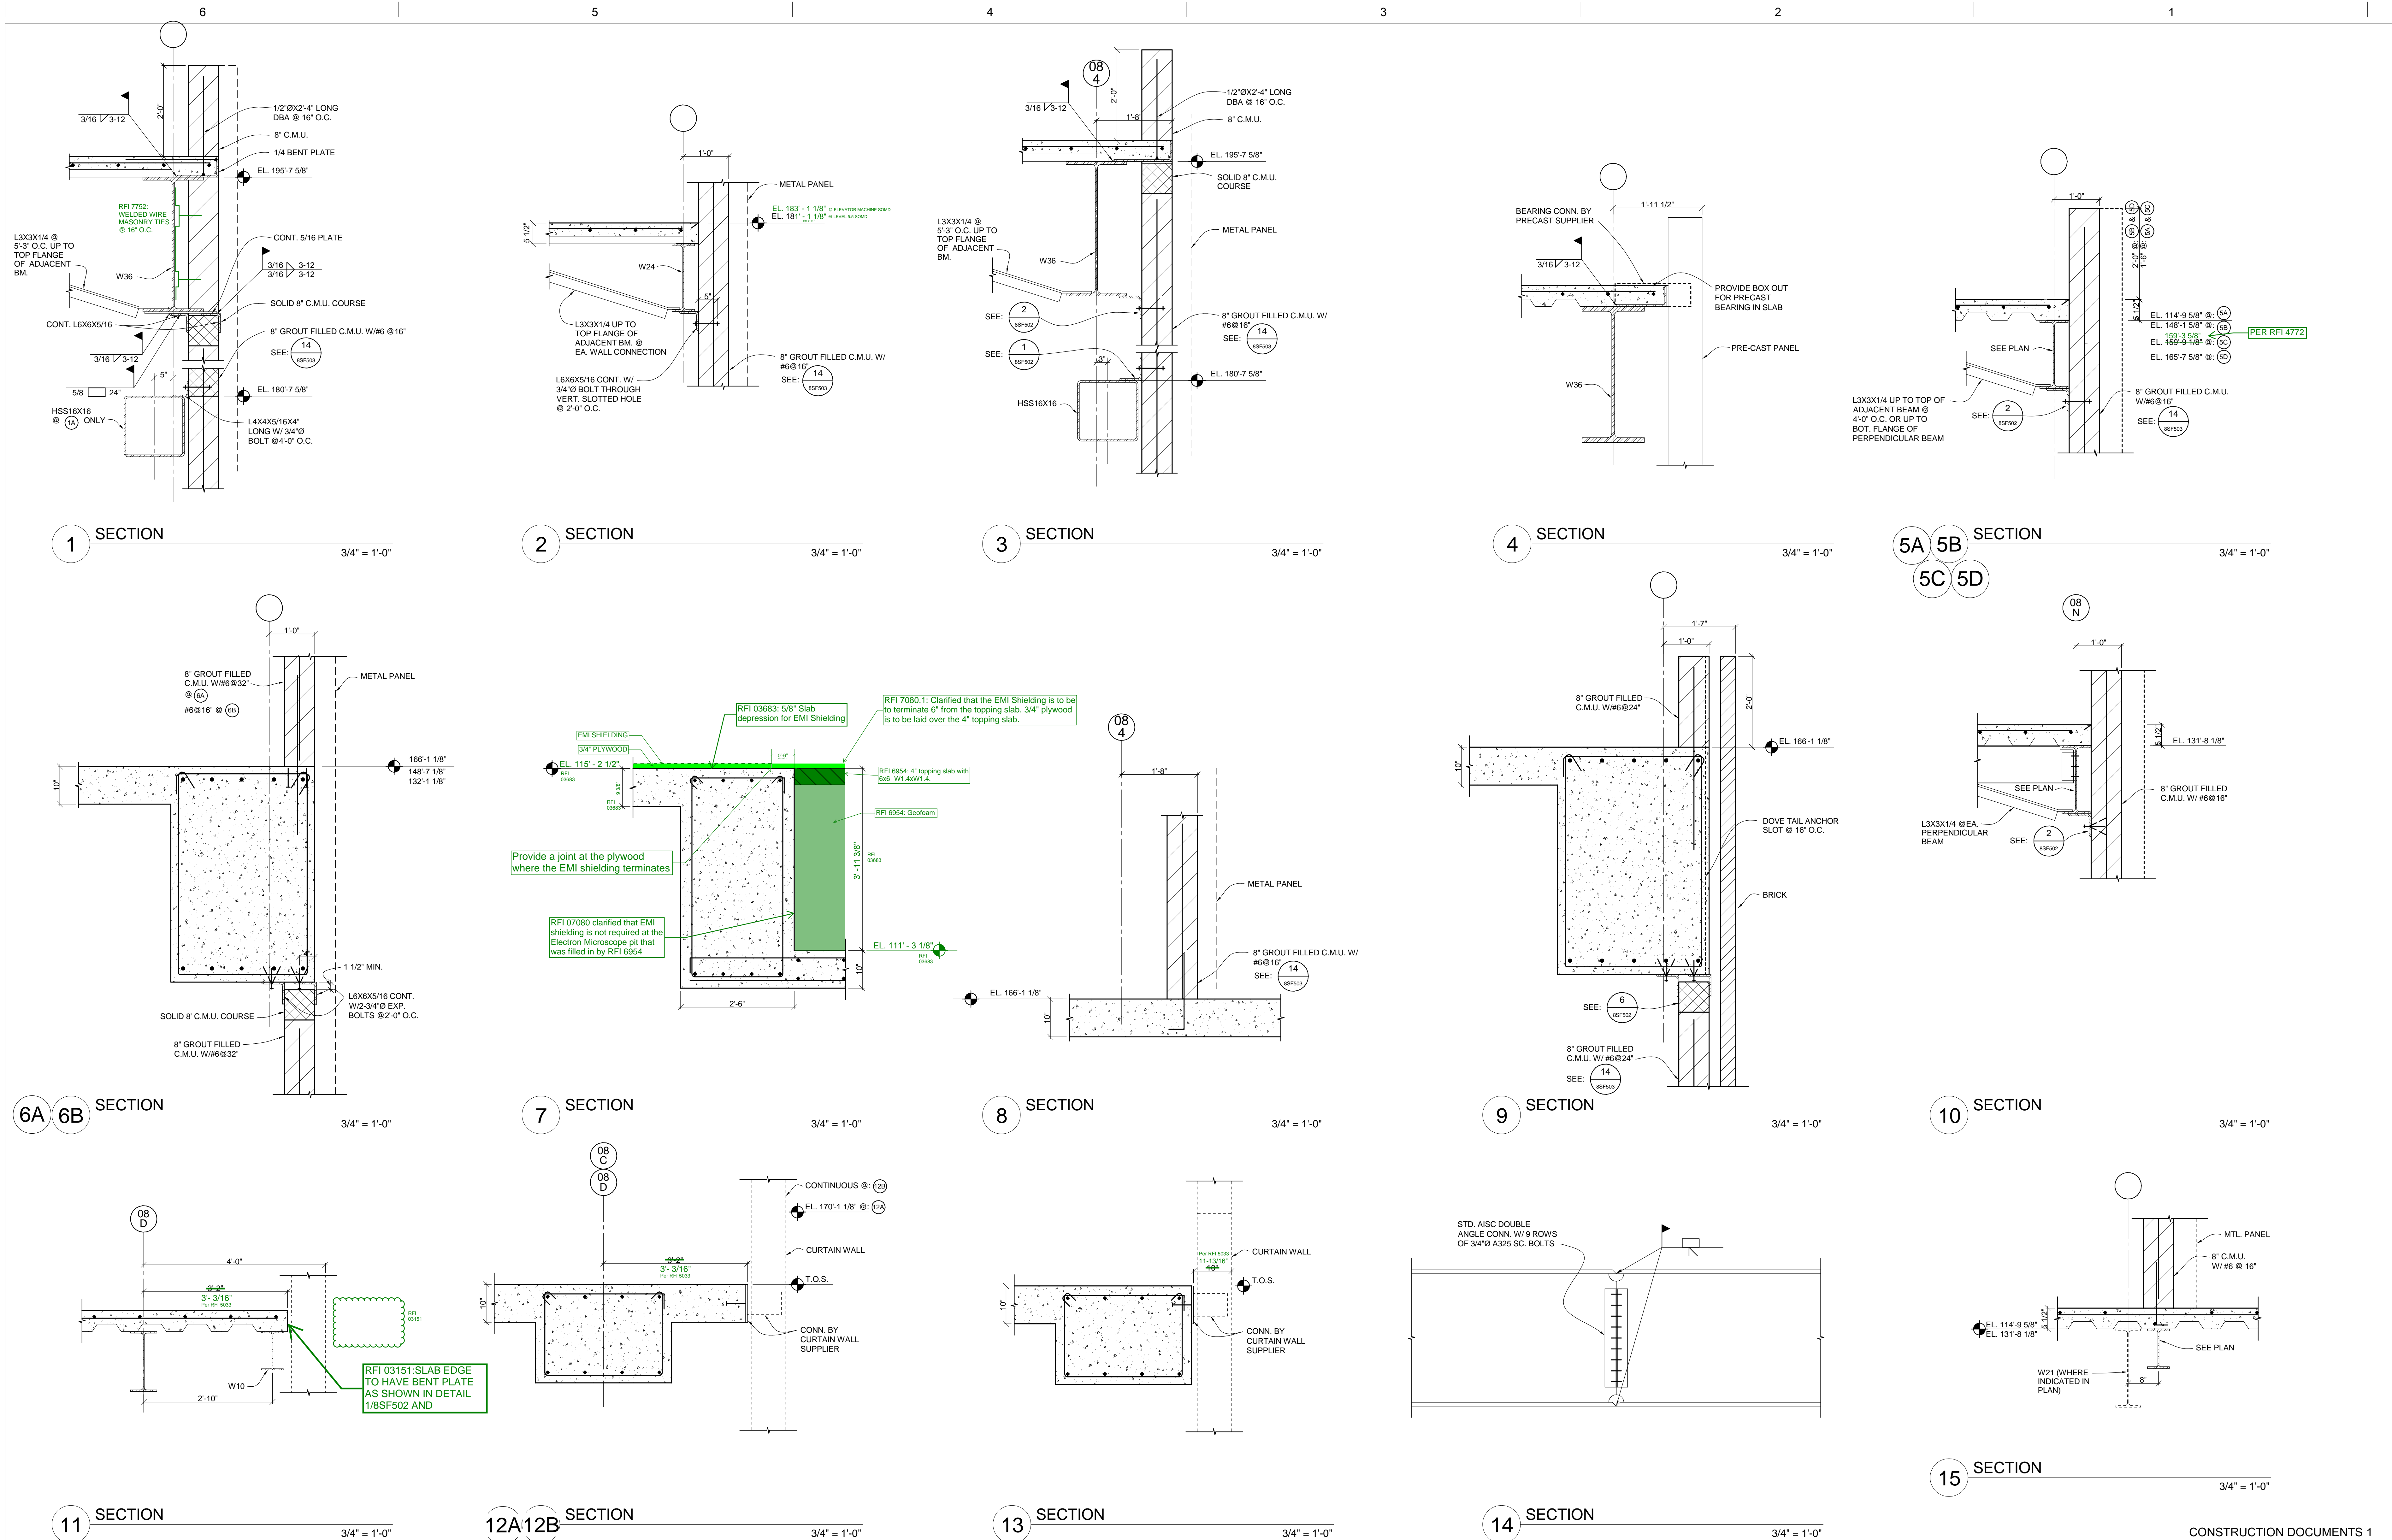

<b>CONSULTANTS:</b> DESMAN ASSOCIATES / PARKING CODE CONSULTANTS, INC. / CODE CONSULTANT THE SEXTANT GROUP / AV & ACOUSTICAL HAMMER DESIGN ASSOCIATES / FOOD SERVICE PYBURN & ODOM / ABATEMENT TATA & HOWARD / TANK CONSULTANT I.S.C. GROUP, INC. / IRRIGATION DAN EUSER WATER ARCHITECTURE, INC. / WATER FEATURE			<b>ARCHITECT/ENGINEERS:</b> studio <b>NOVA</b> SCHRENK & PETERSON CONSULTING ENGINEERS / CIVIL KORDA/NEMETH ENGINEERING / STRUCTURAL BR+A CONSULTING ENGINEERS / MECH, ELECT, PLUMBING, LOW VOLTAGE ARCHITECTURAL ENGINEERING / PLUMBING SCALES ASSOCIATES / FIRE PROTECTION COMMUNICATIONS DESIGN GROUP / LOW VOLTAGE		DRAWING TITLE STRUCTURAL DETAILS	PROJECT TITLE SLV/HCS REPLACEMENT MEDICAL CENTER PROJECT	PROJECT NUMBER 629-HS2-401	BUILDING NUMBER 8	OFFICE OF CONSTRUCTION AND FACILITIES MAINTENANCE 
REVISIONS:	DATE		APPROVED: PROJECT DIRECTOR 		LOCATION NEW ORLEANS, LOUISIANA	DATE July 16, 2012	CHECKED TMD	DRAWN RJC	
				15 SF502					