

ONE INCH = FORTY FEET (1" = 40')

THREE INCHES = ONE FOOT

ONE AND ONE HALF INCHES = ONE FOOT


THREE QUARTERS INCH = ONE FOOT

ONE HALF INCH = ONE FOOT


ONE QUARTER INCH = ONE FOOT

ONE EIGHT INCH = ONE FOOT


ONE SIXTEENTH INCH = ONE FOOT

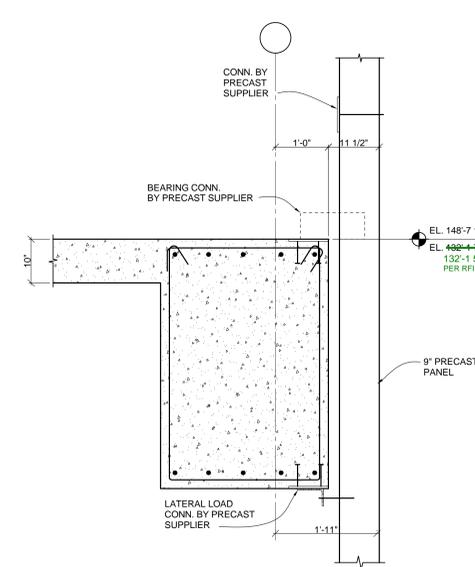


1 SECTION 3/4" = 1'-0"

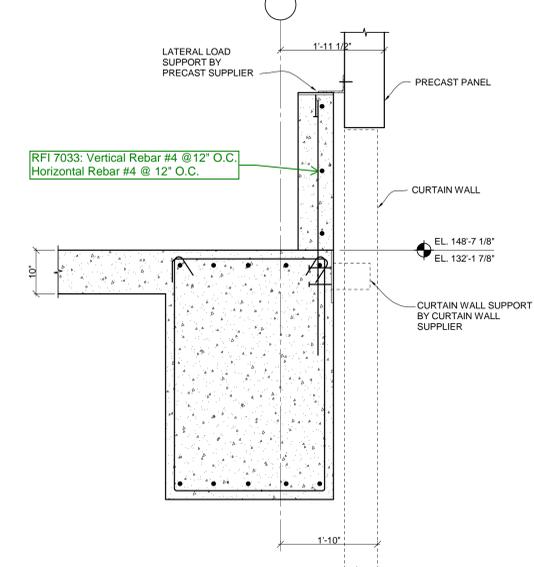


2 SECTION 3/4" = 1'-0"

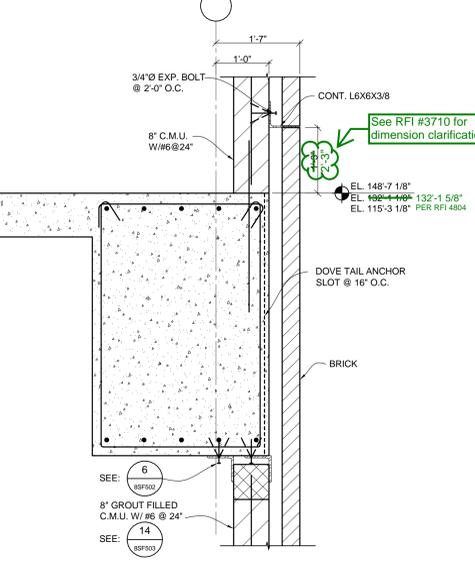


3 SECTION 3/4" = 1'-0"

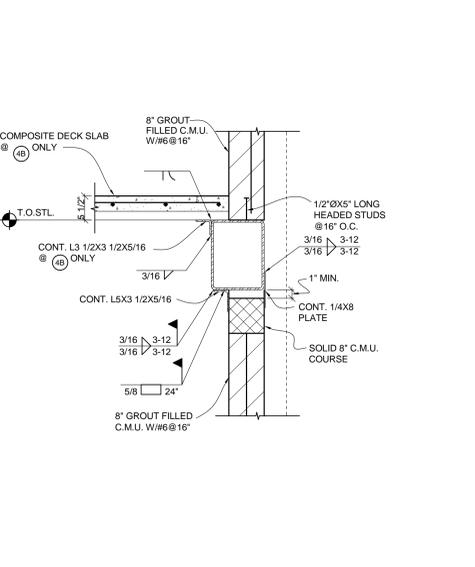


4B 4A SECTION 3/4" = 1'-0"

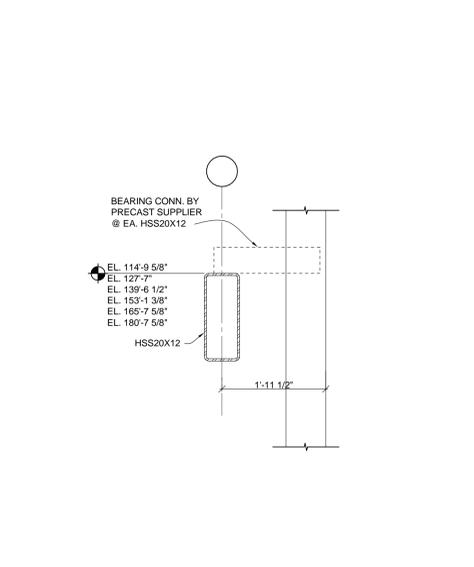


5 SECTION 3/4" = 1'-0"

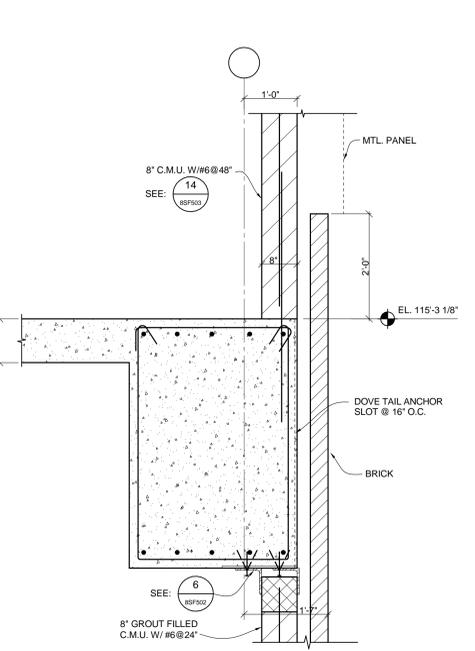


6 SECTION 3/4" = 1'-0"

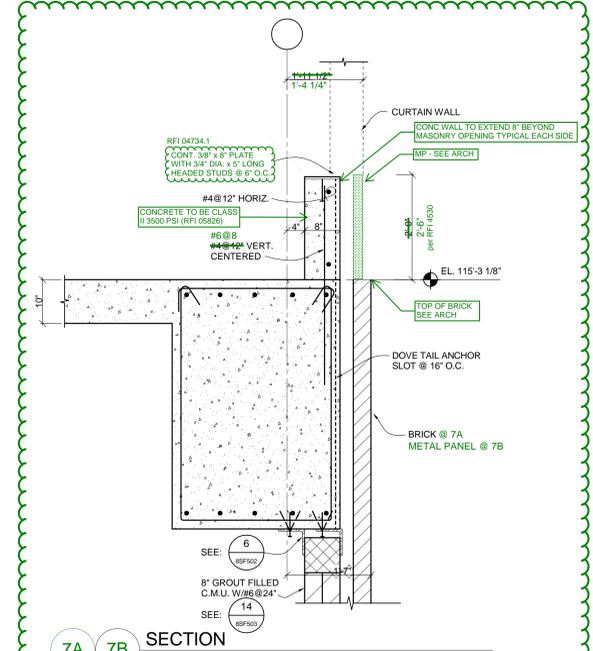


7A 7B SECTION 3/4" = 1'-0" RFI 5091

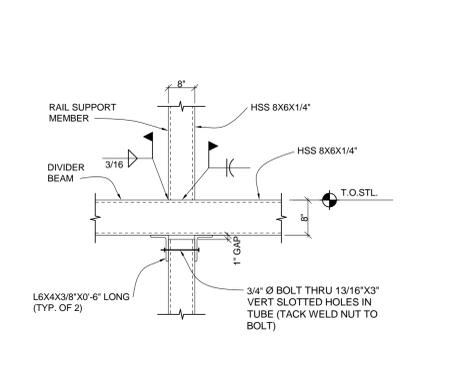


8 SECTION 3/4" = 1'-0"

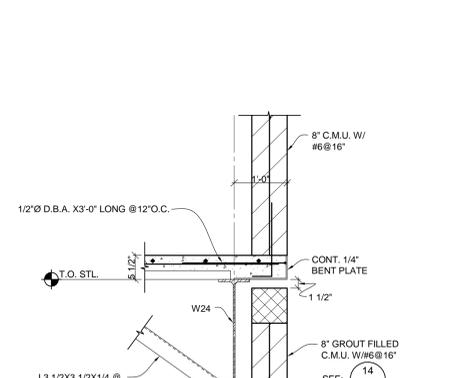


9 SECTION 3/4" = 1'-0"

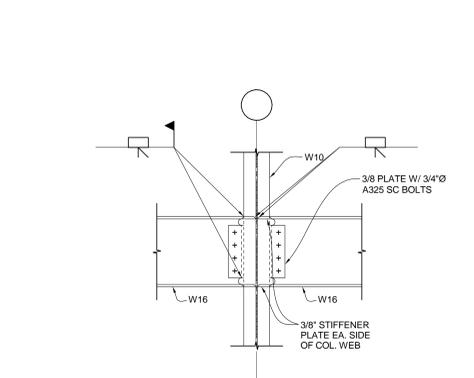


10 SECTION 3/4" = 1'-0"

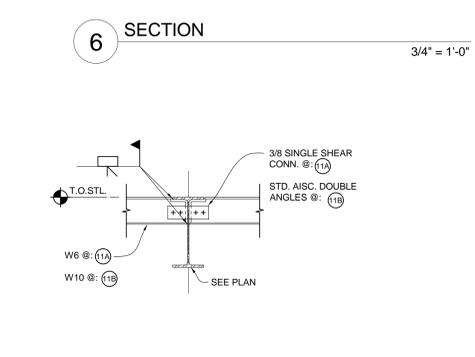


11A 11B SECTION 3/4" = 1'-0"

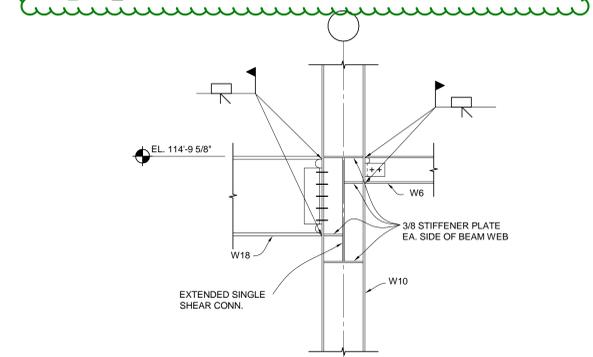


12 SECTION 3/4" = 1'-0"

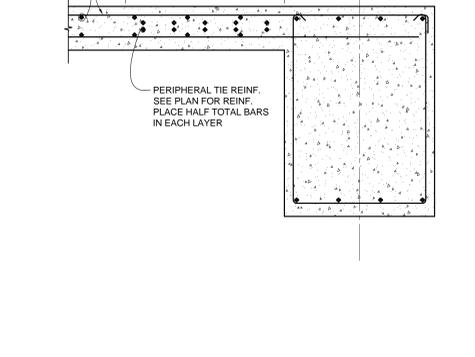

13 SECTION 3/4" = 1'-0"

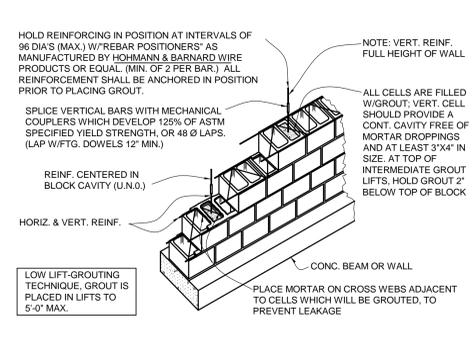

14 SECTION 3/4" = 1'-0"

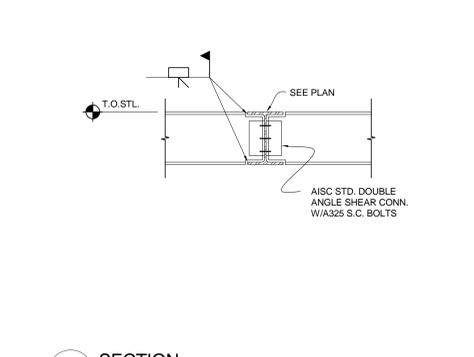


15 SECTION 3/4" = 1'-0"

REVISIONS:

| NO. | DATE | DESCRIPTION |
|-----|------|-------------|
| | | |
| | | |
| | | |
| | | |

CONSULTANTS:
 DESMAN ASSOCIATES / PARKING
 CODE CONSULTANTS, INC. / CODE CONSULTANT
 THE SEXTANT GROUP / AV & ACOUSTICAL
 HAMMER DESIGN ASSOCIATES / FOOD SERVICE
 PYBURN & ODOM / ABATEMENT
 TATA & HOWARD / TANK CONSULTANT
 I.S.C. GROUP, INC. / IRRIGATION
 DAN EUSER WATER ARCHITECTURE, INC. / WATER FEATURE

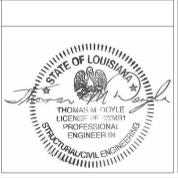

ARCHITECT/ENGINEERS:
 studio **NOVA**
 SCHRENK & PETERSON CONSULTING ENGINEERS / CIVIL
 KORDA/NEMETH ENGINEERING / STRUCTURAL
 BR+A CONSULTING ENGINEERS / MECH, ELECT, PLUMBING, LOW VOLTAGE
 ARCHITECTURAL ENGINEERING / PLUMBING
 SCALES ASSOCIATES / FIRE PROTECTION
 COMMUNICATIONS DESIGN GROUP / LOW VOLTAGE

DRAWING TITLE
STRUCTURAL DETAILS

APPROVED: PROJECT DIRECTOR
Judd Sanders

PROJECT TITLE
SLV/HCS REPLACEMENT MEDICAL CENTER PROJECT

LOCATION
 NEW ORLEANS, LOUISIANA

DATE
 July 16, 2012

CHECKED
 TMD

DRAWN
 RJC

PROJECT NUMBER
 629-HS2-401

BUILDING NUMBER
 8

DOCUMENT SET PACKAGE
 WP_09B

DRAWING NUMBER
8SF503

CONSTRUCTION DOCUMENTS 1
 FULLY SPRINKLERED

OFFICE OF CONSTRUCTION AND FACILITIES MAINTENANCE

Department of Veterans Affairs