ONE INCH = FORTY FEET (1" = 40')
80'
40'
0'
15' 30'
0'

THREE INCHES = ONE FOOT
0
6'

ONE AND ONE HALF INCHES = ONE FOOT
1
6'
0

THREE QUARTERS INCH = ONE FOOT
2
6'
0

ONE HALF INCH = ONE FOOT
4
0

ONE QUARTER INCH = ONE FOOT
8
4
0

ONE EIGHT INCH = ONE FOOT
16
8
4
0

ONE SIXTEENTH INCH = ONE FOOT
32
16
8
4
0

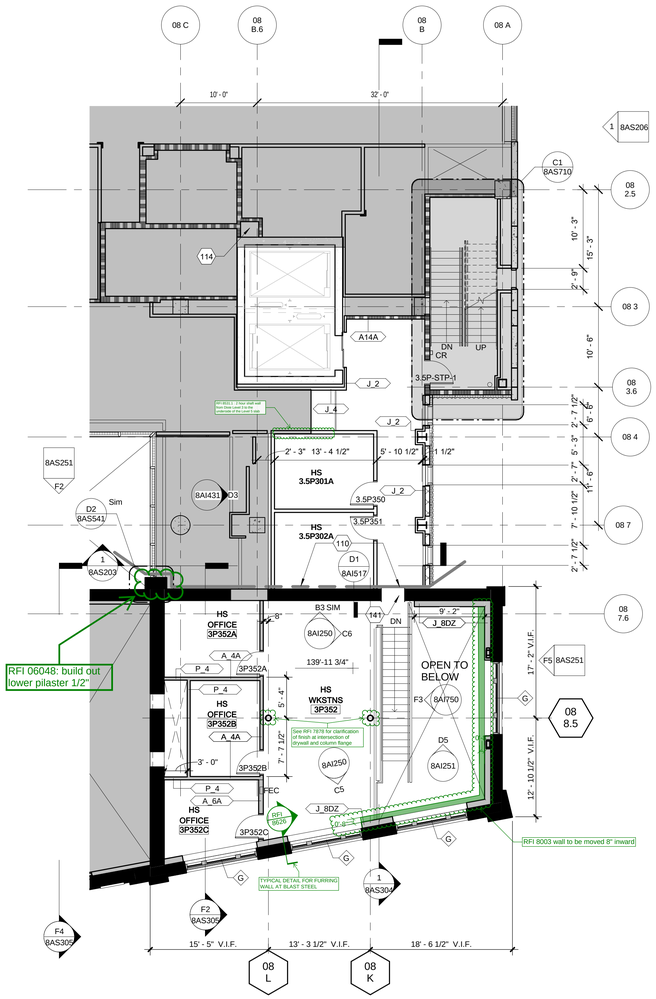

1 1-8 B8 LEVEL 3.5
SCALE: 1/8" = 1'-0"

GENERAL FLOOR PLAN NOTES

1. REFER TO SHEET 8AI002 FOR PARTITION SCHEDULE AND GENERAL PARTITION TYPE NOTES AND 8AI400 FOR FLOOR PLAN LEGEND.
2. REFER TO AI400 SERIES FOR ENLARGED FLOOR PLAN VIEWS INCLUDING MEDICAL EQUIPMENT NOT SHOWN IN AI100 SERIES PLANS.
3. REFER TO LIFESAFETY DRAWINGS (0AS109 and 0AS109.1) FOR SCOPE OF RATED WALL CONSTRUCTION AND EXIT DISCHARGE INFORMATION.
4. PARTITION TYPES AS NOTED BY THE SYMBOL CONTINUE BETWEEN ROOM/SPACE CORNERS OR ANY INTERSECTING PARTITION.
5. DIFFERING PARTITION TYPES SHALL ALIGN SO THAT WALL PLANES CONTINUE UNBROKEN WITHIN/ACROSS ROOMS AND/OR SPACES.
6. LABS AND CLINICAL ROOMS ARE TYPICALLY DIMENSIONED TO CENTER OF STUD. OTHER SPACES ARE TYPICALLY DIMENSIONED TO FACE OF WALL.
7. REFER TO 8AI600 SERIES DRAWINGS FOR DOOR & RELITE SCHEDULES.
8. DISTANCE FROM HINGE SIDE OF DOOR TO INTERSECTING STUD WALL SHALL BE 4" UNLESS NOTED OR DETAILED OTHERWISE (MEASURED FROM OUTSIDE OF FRAME).
9. CONTRACTOR SHALL VERIFY ALL DIMENSIONS NOTED AS "CLEAR" OR "MIN". DIMENSIONS NOTED AS "HOLD" ARE CRITICAL TO COORDINATE OTHER WORK (E.G. CEILING GRIDS, LIGHTING, FINISHES).
10. CONTRACTOR SHALL VERIFY ALL DIMENSIONS PRIOR TO INITIATING CONSTRUCTION AND REPORT DISCREPENCIES TO ARCHITECT PRIOR TO COMMENCING WORK. NEW FLOOR SLAB ELEVATIONS THAT ALIGN WITH EXISTING ARE TO BE CONFIRMED, BASED ON FIELD VERIFIED ELEVATIONS OF EXISTING DIXIE FLOOR SLAB. INCLUDE ADDITIONAL DEPTH FOR CAST UNDERLAYMENT LEVELING TOPPING ON DIXIE SLABS
11. CONTRACTOR SHALL PROVIDE ALL BLOCKING REQUIRED TO ANCHOR ALL WALL AND CLG MOUNTED ITEMS, INCLUDING BUT NOT LIMITED TO TOILET ROOM ACCESSORIES, MILLWORK, CASEWORK, HANDRAILS, DOOR STOPS ETC...
12. FIRE STOPPING SYSTEMS - REFER TO SPEC SECTION 07 84 00 FOR INFO REGARDING PENETRATIONS OF ALL RATED ASSEMBLIES (BOTH SINGLE AND DOUBLE MEMBRANE PENETRATIONS) INCLUDING BUT NOT LIMITED TO PENETRATIONS FOR DUCTWORK, CONDUIT, PIPING AND SUPPORT FOR WALL MOUNTED EQUIPMENT, CABINETS AND COUNTERTOPS.
13. HOUSEKEEPING AND COPY ROOMS - ALL PARTITIONS TO BE FULL HEIGHT TO UNDERSIDE OF DECK/INTERSTITIAL ABOVE. SEE PARTITION TYPE NOTES SHEET 0AI002.
14. SEE DETAIL A3/0AI516 FOR COLUMN BASE WATERPROOFING AT EXPOSED COLUMNS IN SERVICE BAYS & MECHANICAL ROOMS.
15. SHIELDING REQUIREMENTS - VERIFY ALL SHIELDING REQUIREMENTS WITH FINAL EQUIPMENT SELECTIONS AND A VA APPROVED REGISTERED PHYSICIST PRIOR TO COMMENCING WORK IN SHIELDED-ROOM AREAS.
16. PROVIDE HOISTWAY PER EWP-2 DRAWING 8AS701

1XX FLOOR PLAN SHEET NOTES

FLOOR PLAN SHEET NOTE SERIES BEGINS WITH NOTE 100
NOT ALL SHEET NOTES APPEAR ON EVERY SHEET

100. SLAB OPENING - REF STRUCTURAL DWGS
101. ALIGN PARTITIONS
102. CENTER PARTITION ON GRID LINE
103. SLAB DEPRESSION. SLOPE FINISH FLOORING TO FLOOR DRAIN
104. SLAB RECESS FOR WALK-OFF GRILLE. VERIFY RECESS DIMENSION W/ GRILLE MANUFACTURER. SEE FLOOR FINISH PLANS FOR EXTENTS.
105. ROOF/OVERFLOW DRAIN LEADER - REF PLUMBING DWGS
106. ELECTRICAL PANEL - REF ELECTRICAL DWGS
107. EMERGENCY GAS SHUT-OFF VALVE BOX - REF MED GAS DWGS
108. CONCRETE HOUSEKEEPING PAD - REF STRUCTURAL DWGS
109. RECESSED EMERG EYE/FACE WASH AND SHOWER SAFETY STATION WITH DRAIN PAN AND CLG MTD EXPOSED SST SHOWER HEAD - REF PLUMBING DWG.
110. BOLD DASHED LINE INDICATES STRUC EXPANSION JOINT - REF STRUC DWGS. REF FLOOR PLAN LEGEND FOR INT EXP JT CVR ASMBLY INFO.
111. 05 05 00 ACCESS LADDER
112. 05 50 00 METAL GRATE CATWALK - REF DWGS 8SF105 & 4/8SF504
113. 05 52 13 PIPE AND TUBE RAILING - SEE E6/8AS700
114. ELEC RISERS - SEE PLAN DETS ON C3/0AI505 - REF ELEC DWGS
115. 08 31 13 3-HOUR FIRE-RATED 24" X 48" ACCESS PANEL. WHERE COVEED BY FURG, FURNISH & INSTALL FINISH ACCESS PANEL LARGE ENOUGH TO ALLOW FULL OPENING OF FIRE-RATED ACCESS PANEL.
116. NOT USED
117. 10 11 00 MARKER BOARD REF INTERIOR ELEV SHEET NOTES.
118. 10 11 00 TACK BOARD REF INTERIOR ELEV SHEET NOTES.
119. 10 21 13 TOILET PARTITIONS
120. 10 22 13 WIRE MESH STOR LKR PTNS: SINGLE/DOUBLE TIER AS NOTED
121. 11 13 00 FACE MOUNTED MANUAL DOCK LEVELER AND BUMPERS
122. CONC ELEV SHAFTS - REF STRUC DWGS
123. WALL MOUNTED HAND SINK - REF PLUMBING DWGS
124. LINE OF 2-HR RATED SHAFT ABOVE. REF DET D1/8AI503
125. LINE OF HOISTWAY BELOW
126. TOP OF SHAFT LID ASSEMBLY - REF DETAIL E4/8AI516
127. PLENUM SYSTEM - SEE MECHANICAL DRAWINGS
128. AIR HANDLER UNIT - REF MECHANICAL DWGS
129. BENT PLATE W/ TRAFFIC COATING WRAP @ WALL BASE - REF B3/0AI516
130. BENT PLATE W/ PEDESTRIAN TRAFFIC COATING WRAP - REF C3/0AI516
131. CONC CURB W/ PEDESTRIAN TRAFFIC COATING WRAP - REF D3/0AI516
132. NOT USED
133. NOT USED
134. 11 71 02 STERILIZER/WASHER ENCLOSURE PANELS (MODULAR WALLS)
135. CHECKER PLATE RAMP
136. DRIP PIT WITH REMOVABLE SS DRAINAGE GRATE. EXTEND EPOXY RESIN FLOOR FINISH TO DRAIN
137. DEPRESS SLAB ENTIRE ROOM
138. LOCATION FOR FUTURE REFRIGERATOR/FREEZER IF REQUIRED.
139. ALIGN FACE OF PARTITION WITH GRIDLINE.
140. FURRING TO BE FLUSH WITH COLUMN.
141. PROVIDE CAST UNDERLAYMENT NOT TO EXCEED 1/8" RISE IN 1'-0" RUN MAXIMUM ON EITHER SIDE OF OPENING AS REQUIRED FOR ALIGNMENT OF SLAB ELEVATION AT OPENING AS VERIFIED BY CONTRACTOR IN FIELD. MAXIMUM THICKNESS OF CAST UNDERLAYMENT NOT TO EXCEED 2 1/2".

KEY PLAN

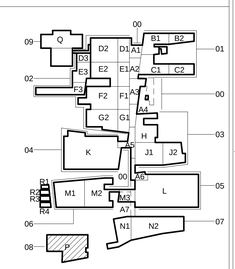

PLAN NORTH

CONSTRUCTION DOCUMENTS 1
FULLY SPRINKLERED

REVISIONS:	DATE

CONSULTANTS:

DESMAN ASSOCIATES / PARKING
CODE CONSULTANTS, INC. / CODE CONSULTANT
THE SEXTANT GROUP / AV & ACOUSTICAL
HAMMER DESIGN ASSOCIATES / FOOD SERVICE
PYBURN & ODOM / ABATEMENT
TATA & HOWARD / TANK CONSULTANT
I.S.C.O. GROUP, INC. / IRRIGATION
DAN EUSER WATER ARCHITECTURE, INC. / WATER FEATURE

RALPH D. PARRIS No. 6531 STATE OF LOUISIANA LICENSED ARCHITECT

ARCHITECT/EGINEERS:

studioNOVA
SCHRENK & PETERSON CONSULTING ENGINEERS / CIVIL
KORDA/NEMETH ENGINEERING / STRUCTURAL
BR+A CONSULTING ENGINEERS / MECH, ELECT, PLUMBING, LOW VOLTAGE
ARCHITECTURAL ENGINEERING / PLUMBING
SCALES ASSOCIATES / FIRE PROTECTION

DRAWING TITLE: BLDG 8 LEVEL 3.5 FLOOR PLAN

APPROVED: PROJECT DIRECTOR: Todd Tandus

PROJECT TITLE: SLVHCS REPLACEMENT MEDICAL CENTER PROJECT

LOCATION: NEW ORLEANS, LOUISIANA

DATE: July 16, 2012 | CHECKED: JR | DRAWN: KS/DMK

PROJECT NUMBER: 100342.00 | BUILDING NUMBER: 08

DOCUMENT SET PACKAGE: WP_09B

DRAWING NUMBER: 8AS103.5

OFFICE OF CONSTRUCTION AND FACILITIES MANAGEMENT

Department of Veterans Affairs

VA FORM 08-6231