

GENERAL INTERIOR FINISH PLAN NOTES

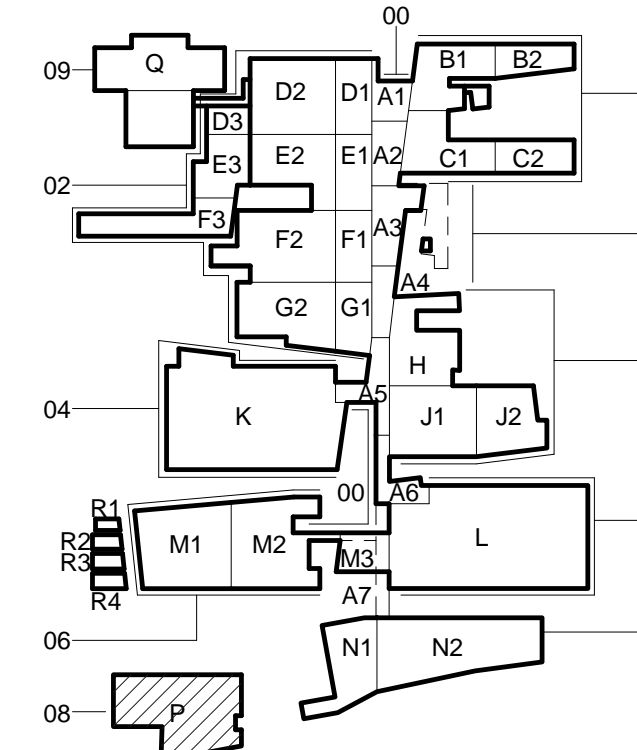
- NO T-JOINTS OR PARTIAL PIECES ACCEPTED FOR SEAMLESS FLOORING
 - SEE SPECIFICATIONS IN CONJUNCTION WITH FINISH LEGEND FOR FINISH INFORMATION
 - ALL WALLS TO BE PAINTED P-2 UON
 - METAL DOOR FRAMES AND DOOR TO MATCH COLOR OF THE ADJACENT WALL
 - SEAMS FOR CARPET AND SEAMLESS FLOORING TO NOT BE LOCATED AT DOORWAYS
 - REFER TO WALL PROTECTION TYPICAL SHEET FOR FINISH APPLICATION
 - TYPICAL FLOOR TRANSITION OCCUR UNDER OR AT CENTER LINE OF DOORS UON
 - WALL PROTECTION LOCATION AS SHOWN ON AF SERIES DRAWINGS AND EXTENT AS INDICATED ON ELEVATIONS
 - FOR ALL COUNTERTOPS, REFER TO SHEET 0A1532 FOR COUNTERTOP FINISH APPLICATION DETAIL UON
 - CPT TO BE LAID MONOLITHIC ASHLAR WITH GRAIN RUNNING PERPENDICULAR TO CORRIDORS
 - PAINT TO BE SEMI-GLOSS IN ALL TOILET ROOMS
 - CARPET TO BE FLUSH WITH ADJACENT FLOOR MATERIAL
 - GROUT JOINTS TO ALIGN WITH FINISHED BASE OF WALL
 - DRAWINGS PROVIDE FINISH CODE FOR ACCENTS IN FLOORING AND WALL AND TYPICAL FINISH ROOM APPLICATIONS
 - REFER TO SCHEDULE AND LEGEND IN CONJUNCTION WITH FINISH PLANS
 - ALL FULL HEIGHT CORNER GUARDS SHOULD BE COORDINATED WITH ELEVATIONS AND REFLECTED CEILING PLANS
 - CRASH RAILS AND HANDRAILS TO TERMINATE 2" FROM METAL DOOR FRAMES AND CORNER GUARDS UON
 - ALL TOILET PARTITIONS TO MATCH P-1 UON
 - REFER TO REFLECTED CEILING PLANS FOR ACCENT CEILING PAINT LOCATIONS
 - INTERIOR OF OPEN CABINETRY TO BE FINISHED WITH SAME MATERIAL LISTED UNDER VERTICAL WOODCASEWORK
 - REFER TO SHEETS 8A1515 & 8A1516 FOR INTERIOR FINISH DETAILS
 - CONCRETE COLUMNS NOT PAINTED UON. SEAL PER SPECIFICATION
 - ALL EXISTING EXPOSED BRICK NOT TO BE PAINTED UON.
 - REFER TO SHEET 8A1515 FOR INTERIOR FLOORING TRANSITION AND BASE DETAILS
 - CEILING AREAS EXPOSED TO ABOVE IN FINISHED SPACES WITHIN THE DIXIE FOOTPRINT SHALL BE PAINTED P-8, INCLUDING STRUCTURE, FIREPROOFING, AND ALL UTILITIES AND THEIR ASSOCIATED SUPPORTS
- RFI 8100 Catwalk steel is to be painted safety yellow.
- RFI 8129 BLACK MATERIAL ON EXISTING BRICK WALLS IS TO BE REMOVED WHERE EXPOSED TO VIEW. TYPICAL AT ALL LOCATIONS.

INTERIOR FINISH PLAN CODED NOTES

- REFER TO A1500 SERIES SHEETS FOR MILLWORK FINISH DESIGNATIONS
- ALIGN FLOOR TRANSITIONS WITH WALL / ADJACENT FINISHED FACE
- ALL SHOWERS TO HAVE FULL-HEIGHT CERAMIC TILE ON ALL WALLS
- SSB-1 USED AT BASE OF COLUMN
- WALL GRAPHIC TO BE APPLIED - WILL COVER ENTIRE WALL. REFER TO EGD PACKAGE FOR DETAILS.
- ALIGN TO FRAME OF DOOR

SYMBOLS LEGEND

- FLOOR FINISH - SEE 8AF602
- WALL FINISH - SEE 8AF603
- ROOM NAME NUMBER [KEY] ROOM FINISH KEY - PROVIDED FOR COMPARING TO TYPICAL ROOM FINISHES ON FINISH PLANS AND ROOM FINISH SCHEDULE
- [X#] TYPICAL ROOM/TYPICAL ROOM FINISH CODE
- WALL PROTECTION - SEE 8AF605
- CORNERGUARD - SEE 8AF603

CONSTRUCTION DOCUMENTS 1
FULLY SPRINKLERED

CONSULTANTS:

DESMAN ASSOCIATES / PARKING
CODE CONSULTANTS, INC. / CODE CONSULTANT
THE SEXTANT GROUP / AV & ACOUSTICAL
HAMMER DESIGN ASSOCIATES / FOOD SERVICE
PYBURN & ODOM / ABATEMENT
TATA & HOWARD / TANK CONSULTANT
I.S.C. GROUP, INC. / IRRIGATION
DAN EUSER WATER ARCHITECTURE, INC. / WATER FEATURE

ARCHITECT/ENGINEERS:

studio **NOVA**

SCHRENK & PETERSON CONSULTING ENGINEERS / CIVIL
KORDA/NEMETH ENGINEERING / STRUCTURAL
BR+A CONSULTING ENGINEERS / MECH, ELECT, PLUMBING, LOW VOLTAGE
ARCHITECTURAL ENGINEERING / PLUMBING
SCALES ASSOCIATES / FIRE PROTECTION

DRAWING TITLE
BLDG 8 LEVEL 5 FINISH FLOOR PLAN

APPROVED: PROJECT DIRECTOR

PROJECT TITLE
SLVHCS REPLACEMENT MEDICAL
CENTER PROJECTLOCATION
NEW ORLEANS, LOUISIANADATE
July 16, 2012CHECKED
JRDRAWN
ANPROJECT NUMBER
100342.00
BUILDING NUMBER
08
DOCUMENT SET PACKAGE
WP_09B

DRAWING NUMBER

8AF105

OFFICE OF
CONSTRUCTION
AND FACILITIES
MANAGEMENT

1	Addendum #1	9/21/12
REVISIONS:		DATE