

EXTERIOR MATERIALS LEGEND

MATERIAL TYPES

	INSULATED LAMINATED VISION
	INSULATED LAMINATED SPANDREL
	METAL PANEL (MP-1B)
	METAL PANEL (MP-1A)
	PRECAST
	STUCCO / EIFS (SEE NOTE ON ELEV.)
	MECHANICAL LOUVER
	MASONRY CAVITY WALL (BR-1)

GLAZING TYPES

IG-01	INSULATED LAMINATED VISION
IG-01x-T	INSUL. LAMINATED VISION TEMPERED
SG-01	INSUL. LAMINATED SPANDREL
SG-01x-T	INSUL. LAMINATED SPANDREL TEMPERED
SGS-1	LAMINATED GLASS SPANDREL

SYMBOLS LEGEND

	PRECAST (WALL TYPE PC-1) PATTERN TYPE INDICATOR. SEE SHEET 8AS506 FOR PANEL TYPES
	OVERFLOW DRAIN (SECONDARY)
	M.E.P. PENETRATIONS THROUGH ENCLOSURE
	LIGHTING OVER EXIT

WALL TYPES LEGEND

WALL TYPE MARK	REFER TO SHEET
MP-1	8AS501
MP-1A	8AS502
BR-1	8AS503
PC-1	8AS504
CW-1	8AS505


- CURTAINWALL: WALL TYPE CW-1 IS TYPICAL U.N.O.
- DASHED LINES ON PC-1 DENOTE AREA OF INDICATED PATTERN, NOT PANELIZATION. SUBCONTRACTOR TO OPTIMIZE PANEL LAYOUT WITHIN JOINTS SHOWN.

DIMENSION NOTES

- ALL DIMENSION STRINGS FROM CIL. OF JT. TO CIL. OF JT. EXCEPT AT ENDS OF EXTERIOR WALL & U.N.O.
- REFER TO PLANS FOR CW. VERT. FRAMING LOCATIONS. REFER TO ELEVATIONS FOR GLASS TYPE
- REFER TO PLANS FOR WINDOW LOCATIONS IN METAL PANEL & PRECAST SYSTEMS. REFER TO ELEVATIONS FOR LOCATIONS OF JOINTS IN THESE SYSTEMS.
- VERIFY IN FIELD LOCATION OF ALL EXISTING DIXIE BUILDING ELEMENTS


Per RFI 5045: Remove Brick at window openings similar to arched windows on South elevation (with rectangular opening). Cut back 2nd wythe of brick to be flush with face brick.

Per RFI 5045: 1: Install W10x22 with 5/16" bottom plate lintel with 14" bearing.

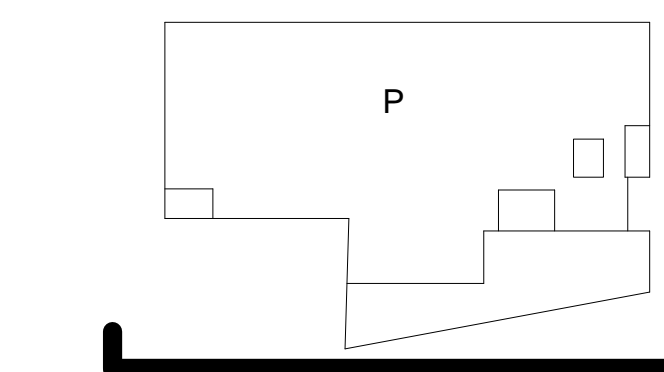

CONSTRUCTION DOCUMENTS 1
FULLY SPRINKLERED

OFFICE OF
CONSTRUCTION
AND FACILITIES
MANAGEMENT

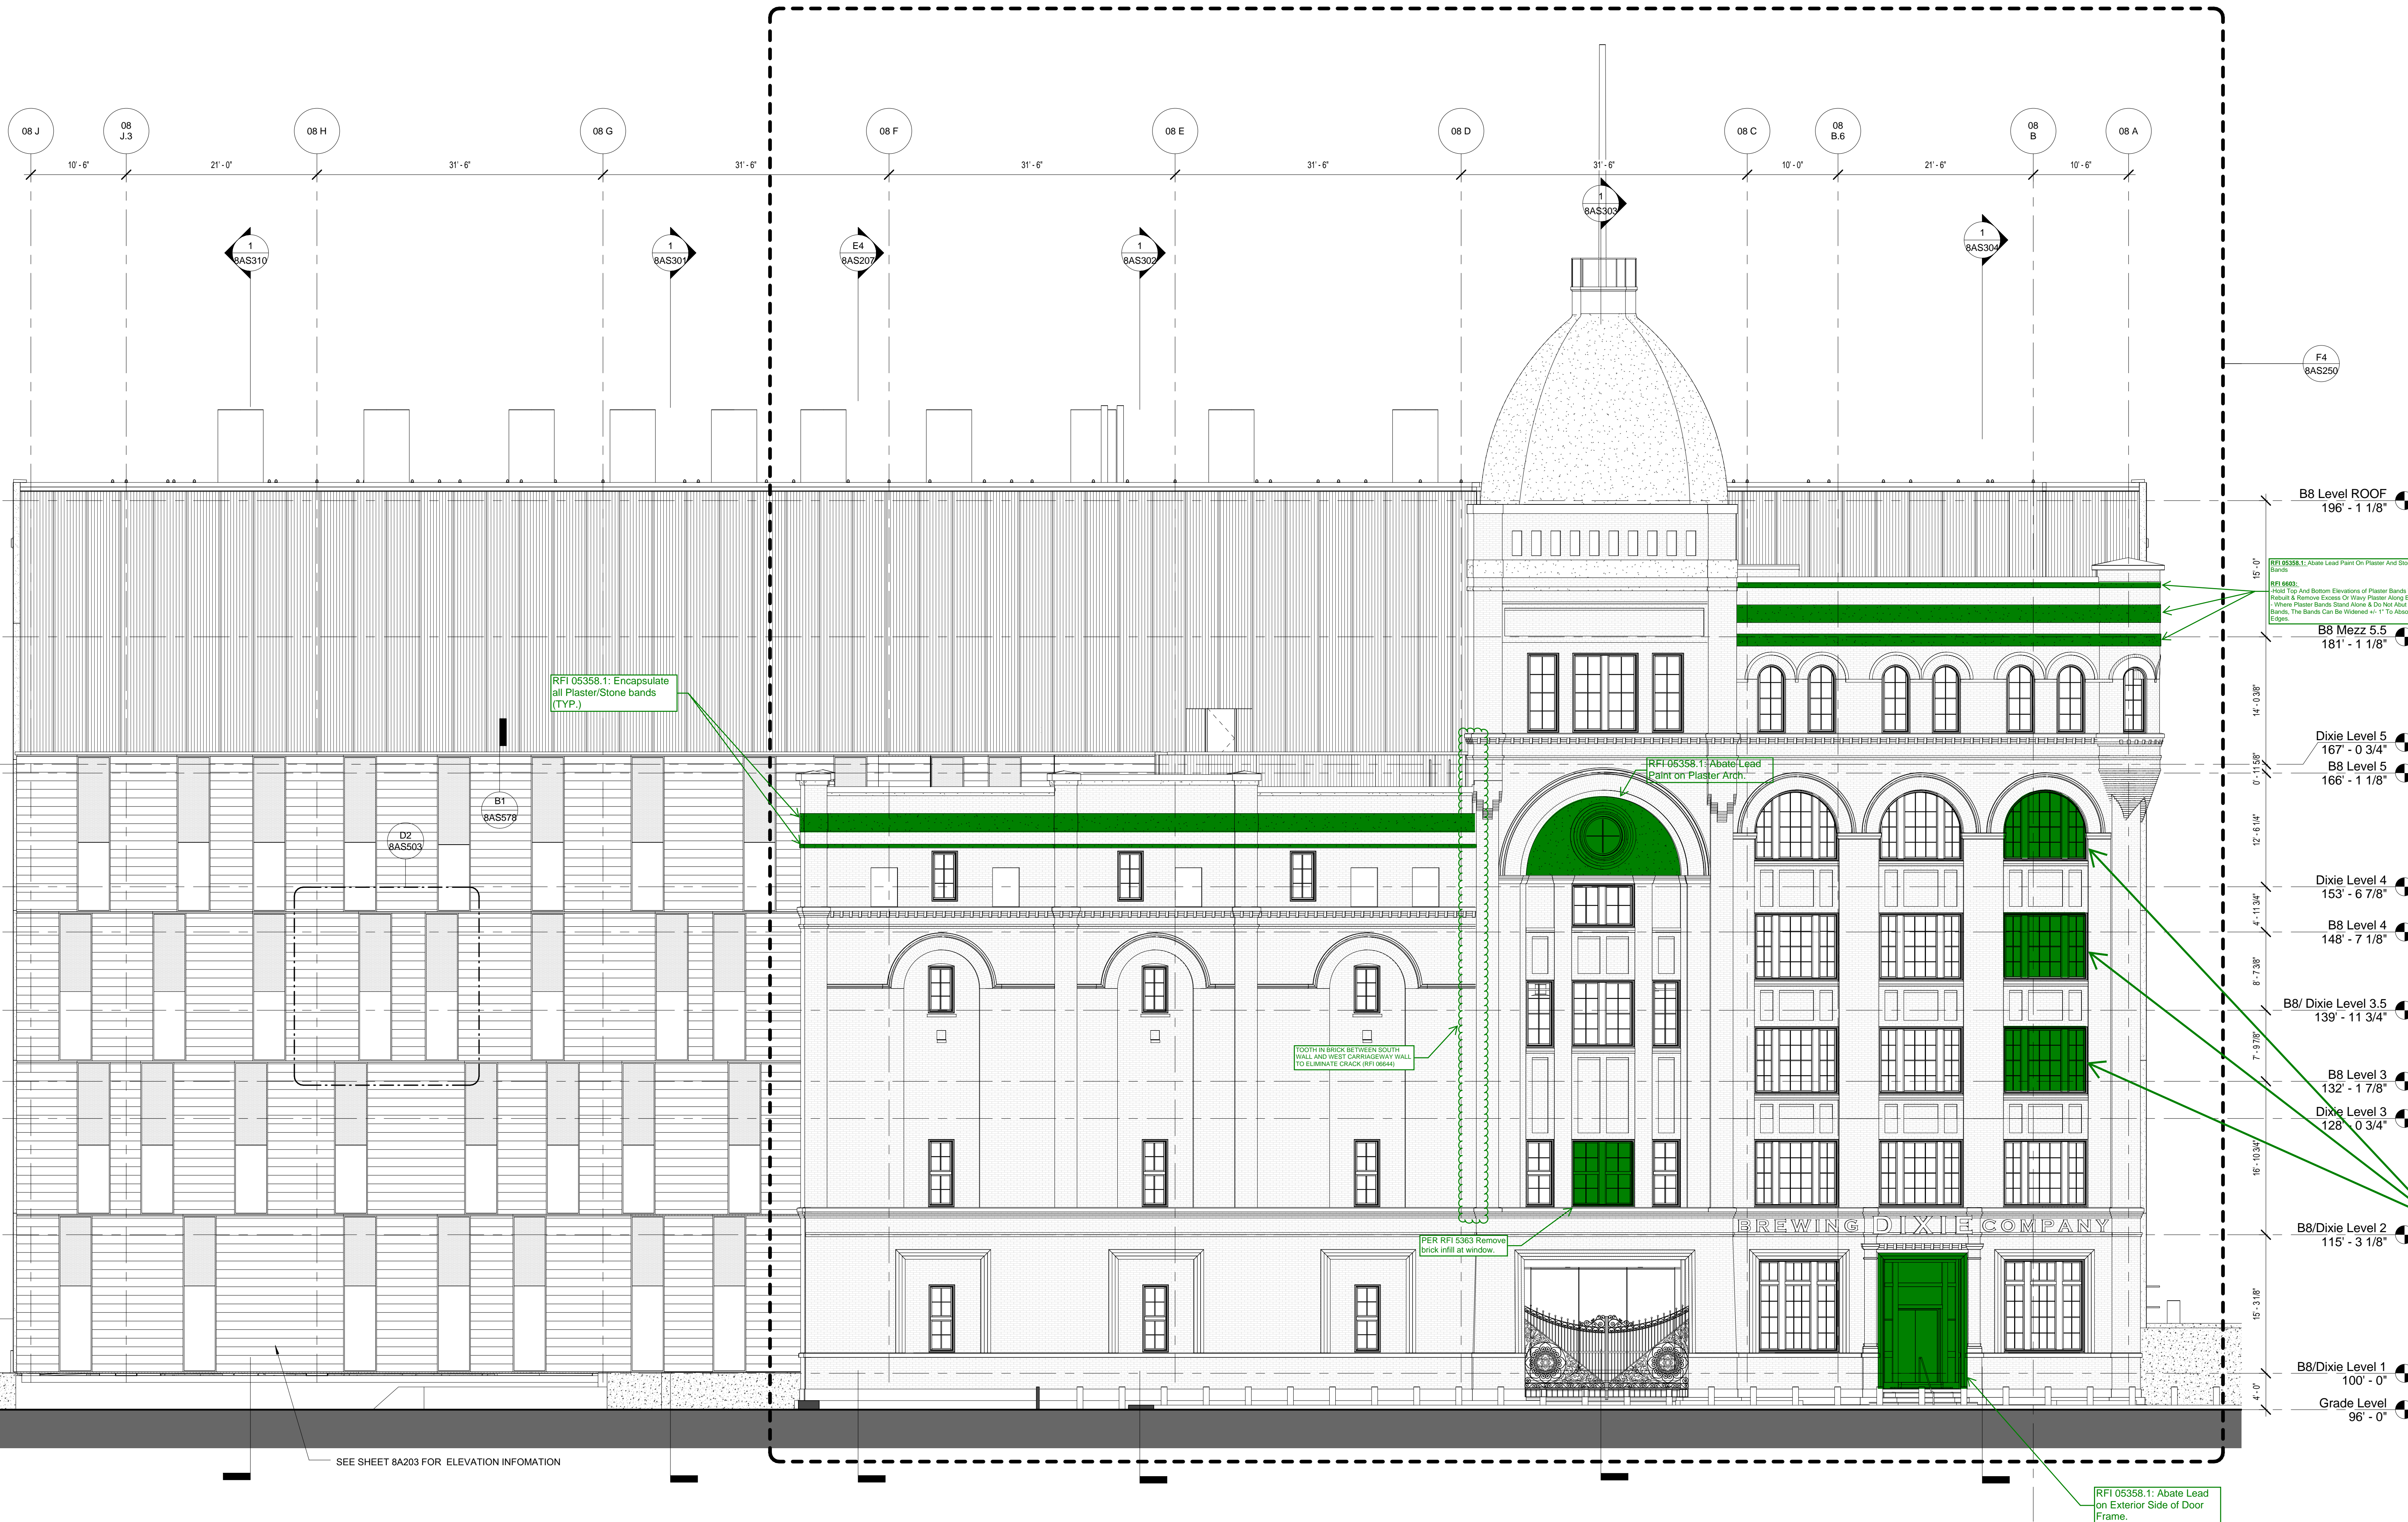

1 SOUTH OVERALL ELEVATION
SCALE: 1/8" = 1'-0"

CONSULTANTS:

DESMAN ASSOCIATES / PARKING
CODE CONSULTANTS, INC. / CODE CONSULTANT
THE SEXTANT GROUP / AV & ACOUSTICAL
HAMMER DESIGN ASSOCIATES / FOOD SERVICE
PYBURN & ODOM / ABATEMENT
TATA & HOWARD / TANK CONSULTANT
I.S.C. GROUP, INC. / IRRIGATION
DAN EUSER WATER ARCHITECTURE, INC. / WATER FEATURE



ARCHITECT/ENGINEERS:

studio **NOVA**

SCHRENK & PETERSON CONSULTING ENGINEERS / CIVIL
KORDA/NEMETH ENGINEERING / STRUCTURAL
BR+A CONSULTING ENGINEERS / MECH. ELECT. PLUMBING, LOW VOLTAGE
ARCHITECTURAL ENGINEERING / PLUMBING
SCALES ASSOCIATES / FIRE PROTECTION

DRAWING TITLE

BLDG 8 SOUTH ELEVATION

APPROVED: PROJECT DIRECTOR

Yadda Sanders

PROJECT TITLE

SLVHCS REPLACEMENT MEDICAL
CENTER PROJECT

LOCATION

NEW ORLEANS, LOUISIANA

DATE
July 16, 2012

CHECKED
NF

DRAWN
KS

PROJECT NUMBER

100342.00

DOCUMENT SET PACKAGE

WP_09B

DRAWING NUMBER

8AS202

BUILDING NUMBER

08