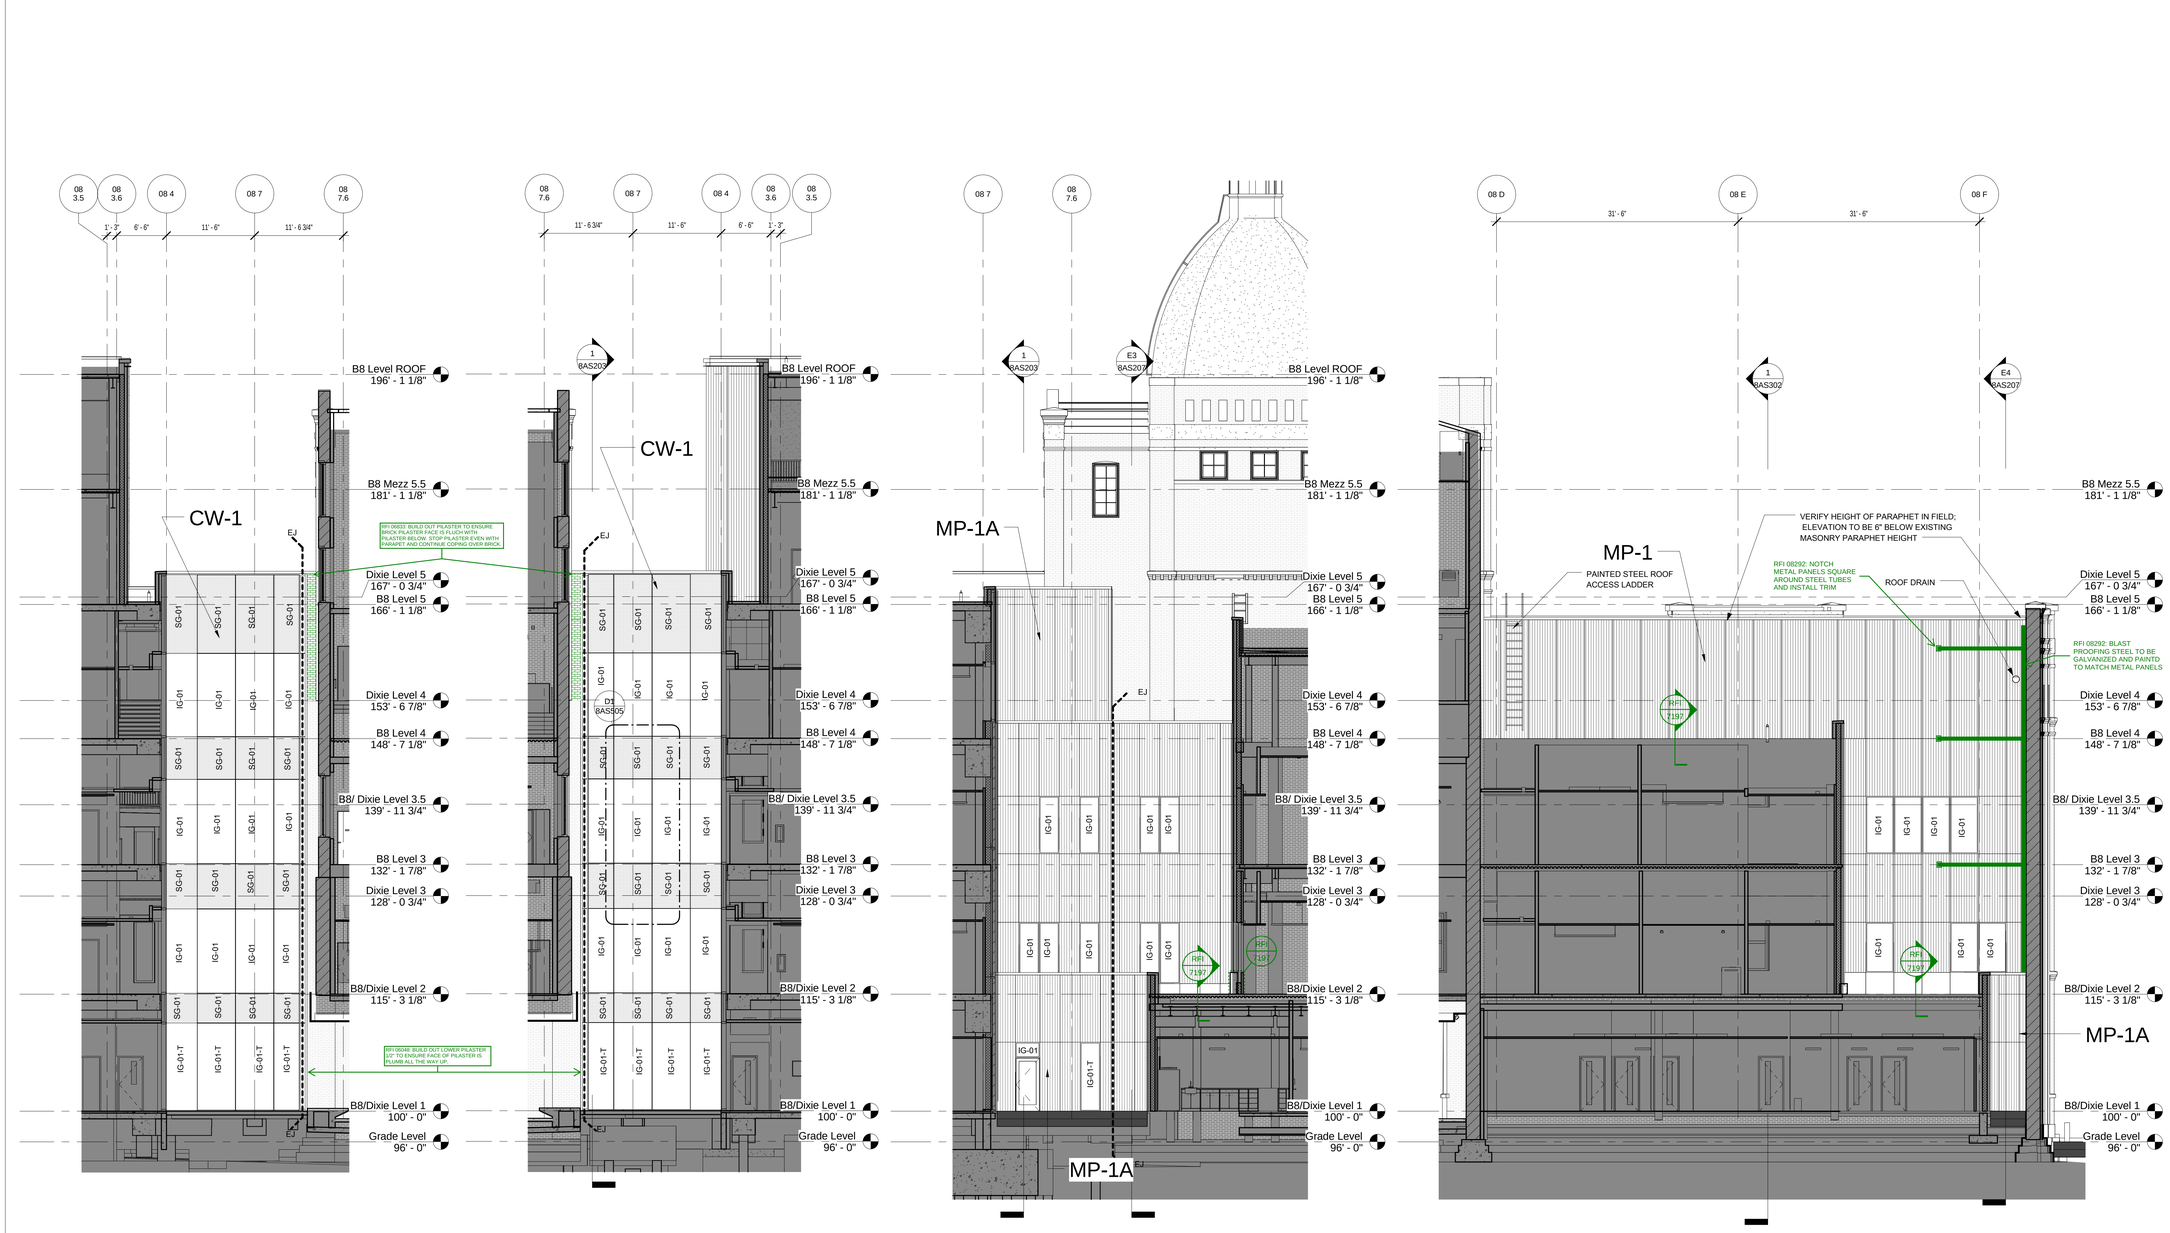

E6 Elevation West Lightwell
SCALE: 1/8" = 1'-0"

E5 Elevation East Lightwell
SCALE: 1/8" = 1'-0"

E4 Elevation West Dixie
SCALE: 1/8" = 1'-0"

E3 Elevation North Dixie
SCALE: 1/8" = 1'-0"

EXTERIOR MATERIALS LEGEND

MATERIAL TYPES

- INSULATED LAMINATED VISION
- INSULATED LAMINATED SPANDREL
- METAL PANEL (MP-1B)
- METAL PANEL (MP-1, MP-1A)
- PRECAST
- STUCCO / E.I.F.S (SEE NOTE ON ELEV.) — SEE RFI 04287: NO STUCCO/EIFS.
- MECHANICAL LOUVER
- MASONRY CAVITY WALL (BR-1)

GLAZING TYPES

IG-01	INSULATED LAMINATED VISION
IG-01x-T	INSUL. LAMINATED VISION TEMPERED
SG-01	INSUL. LAMINATED SPANDREL
SG-01xT	INSUL. LAMINATED SPANDREL TEMPERED
SGS-1	LAMINATED GLASS SPANDREL

SYMBOLS LEGEND

- (X) PRECAST (WALLTYPE PC-1) PATTERN TYPE INDICATOR. SEE SHEET 8AS506 FOR PANEL TYPES
- O.D OVERFLOW DRAIN (SECONDARY)
- O.S OVER FLOW SCUPPER
- M.E.P. FP PENETRATIONS THROUGH ENCLOSURE
- LIGHTING OVER EXIT

WALL TYPES LEGEND

WALL TYPE MARK	REFER TO SHEET
MP-1	8AS501
MP-1A	8AS502
BR-1	8AS503
PC-1	8AS504
CW-1	8AS505

1. CURTAINWALL: WALL TYPE CW-1 IS TYPICAL U.N.O.
2. DASHED LINES ON PC-1 DENOTE AREA OF INDICATED PATTERN, NOT PANELIZATION. SUBCONTRACTOR TO OPTIMIZE PANEL LAYOUT WITHIN JOINTS SHOWN.

DIMENSION NOTES

1. ALL DIMENSION STRINGS FROM C/L OF JT. TO C/L OF JT. EXCEPT AT ENDS OF EXTERIOR WALL & U.N.O.
2. REFER TO PLANS FOR CW. VERT. FRAMING LOCATIONS. REFER TO ELEVATIONS FOR GLASS TYPE
3. REFER TO PLANS FOR WINDOW LOCATIONS IN METAL PANEL & PRECAST SYSTEMS. REFER TO ELEVATIONS FOR LOCATIONS OF JOINTS IN THESE SYSTEMS.
4. VERIFY IN FIELD LOCATION OF ALL EXISTING DIXIE BUILDING ELEMENTS

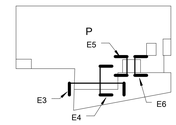

PLAN NORTH

CONSTRUCTION DOCUMENTS 1
FULLY SPRINKLERED

REVISIONS: DATE

CONSULTANTS:

DESMAN ASSOCIATES / PARKING
CODE CONSULTANTS, INC. / CODE CONSULTANT
THE SEXTANT GROUP / AV & ACOUSTICAL
HAMMER DESIGN ASSOCIATES / FOOD SERVICE
PYBURN & ODOM / ABATEMENT
TATA & HOWARD / TANK CONSULTANT
I.S.C. GROUP, INC. / IRRIGATION
DAN EUSER WATER ARCHITECTURE, INC. / WATER FEATURE

RALPH D. PARRIS No.6231 STATE OF LOUISIANA LICENSED ARCHITECT

ARCHITECT/ENGINEERS:

studioNOVA
SCHRENK & PETERSON CONSULTING ENGINEERS / CIVIL
KORDA/NEMETH ENGINEERING / STRUCTURAL
BR+A CONSULTING ENGINEERS / MECH, ELECT, PLUMBING, LOW VOLTAGE
ARCHITECTURAL ENGINEERING / PLUMBING
SCALES ASSOCIATES / FIRE PROTECTION

DRAWING TITLE	BLDG 8 MISCELLANEOUS ELEVATIONS
PROJECT TITLE	SLVHCS REPLACEMENT MEDICAL CENTER PROJECT
PROJECT NUMBER	100342.00
BUILDING NUMBER	08
DOCUMENT SET PACKAGE	WP_09B
APPROVED: PROJECT DIRECTOR	Todd Tandus
LOCATION	NEW ORLEANS, LOUISIANA
DRAWING NUMBER	8AS207
DATE	July 16, 2012
CHECKED	NF
DRAWN	KS

OFFICE OF CONSTRUCTION AND FACILITIES MANAGEMENT
Department of Veterans Affairs

VA FORM 08-6231