
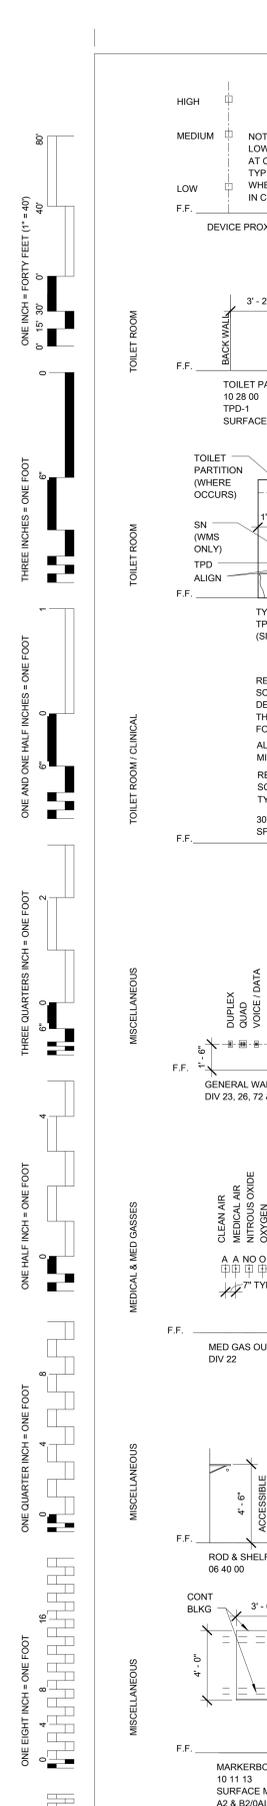



TYPICAL MOUNTING HEIGHT NOTES

- REFER TO FINISH PLANS IN AF800 SERIES SHEETS FOR WALL PROTECTION TYPES, CORNER GUARDS, AND DETAILS.
- FOR TOILET ACCESSORIES, REFER TO TOILET ACCESSORY TYPE LEGEND 0A202, AND SCHEDULES 0A2xx-0A2xx.
- REFER TO NURSE CALL SHEETS FOR LOCATIONS AND TYPES OF RELATED EQUIPMENT.
- PRODUCT NUMBERS: ACCESSORIES LABELED ON THIS SHEET WITH "B-XXX" NUMBERS REFER TO CATALOG NOS OF BOBRICK COMPANY PRODUCTS. ADDITIONAL ACCEPTABLE MANUFACTURERS ARE LISTED IN SPECIFICATIONS.
- TYPICAL MOUNTING HEIGHTS: MOUNT ITEMS AT HEIGHTS ABOVE FLOOR LEVEL AS SHOWN ON THIS SHEET, UNLESS OTHERWISE NOTED ON INTERIOR ELEVATIONS OR OTHER DRAWINGS. NOTIFY ARCHITECT OF POTENTIAL CONFLICTS PRIOR TO PURCHASE OR INSTALLATION.
- FIRE RATED PARTITIONS: WHERE ITEMS ARE RECESSED INTO FIRE-RATED PARTITIONS, PROVIDE CONTINUOUS FIRE-RATED CONSTRUCTION BEHIND AND ALL AROUND ITEMS. WHERE MANUAL FLUSH VALVE IS INSTALLED FOR TOILET, MOUNT THE FLOW CONTROL TO THE OPEN SIDE OF THE STALL OR TOILET ROOM.

SEE RFI 3147 FOR TOILET ROOM ACCESSORIES CLARIFICATIONS.

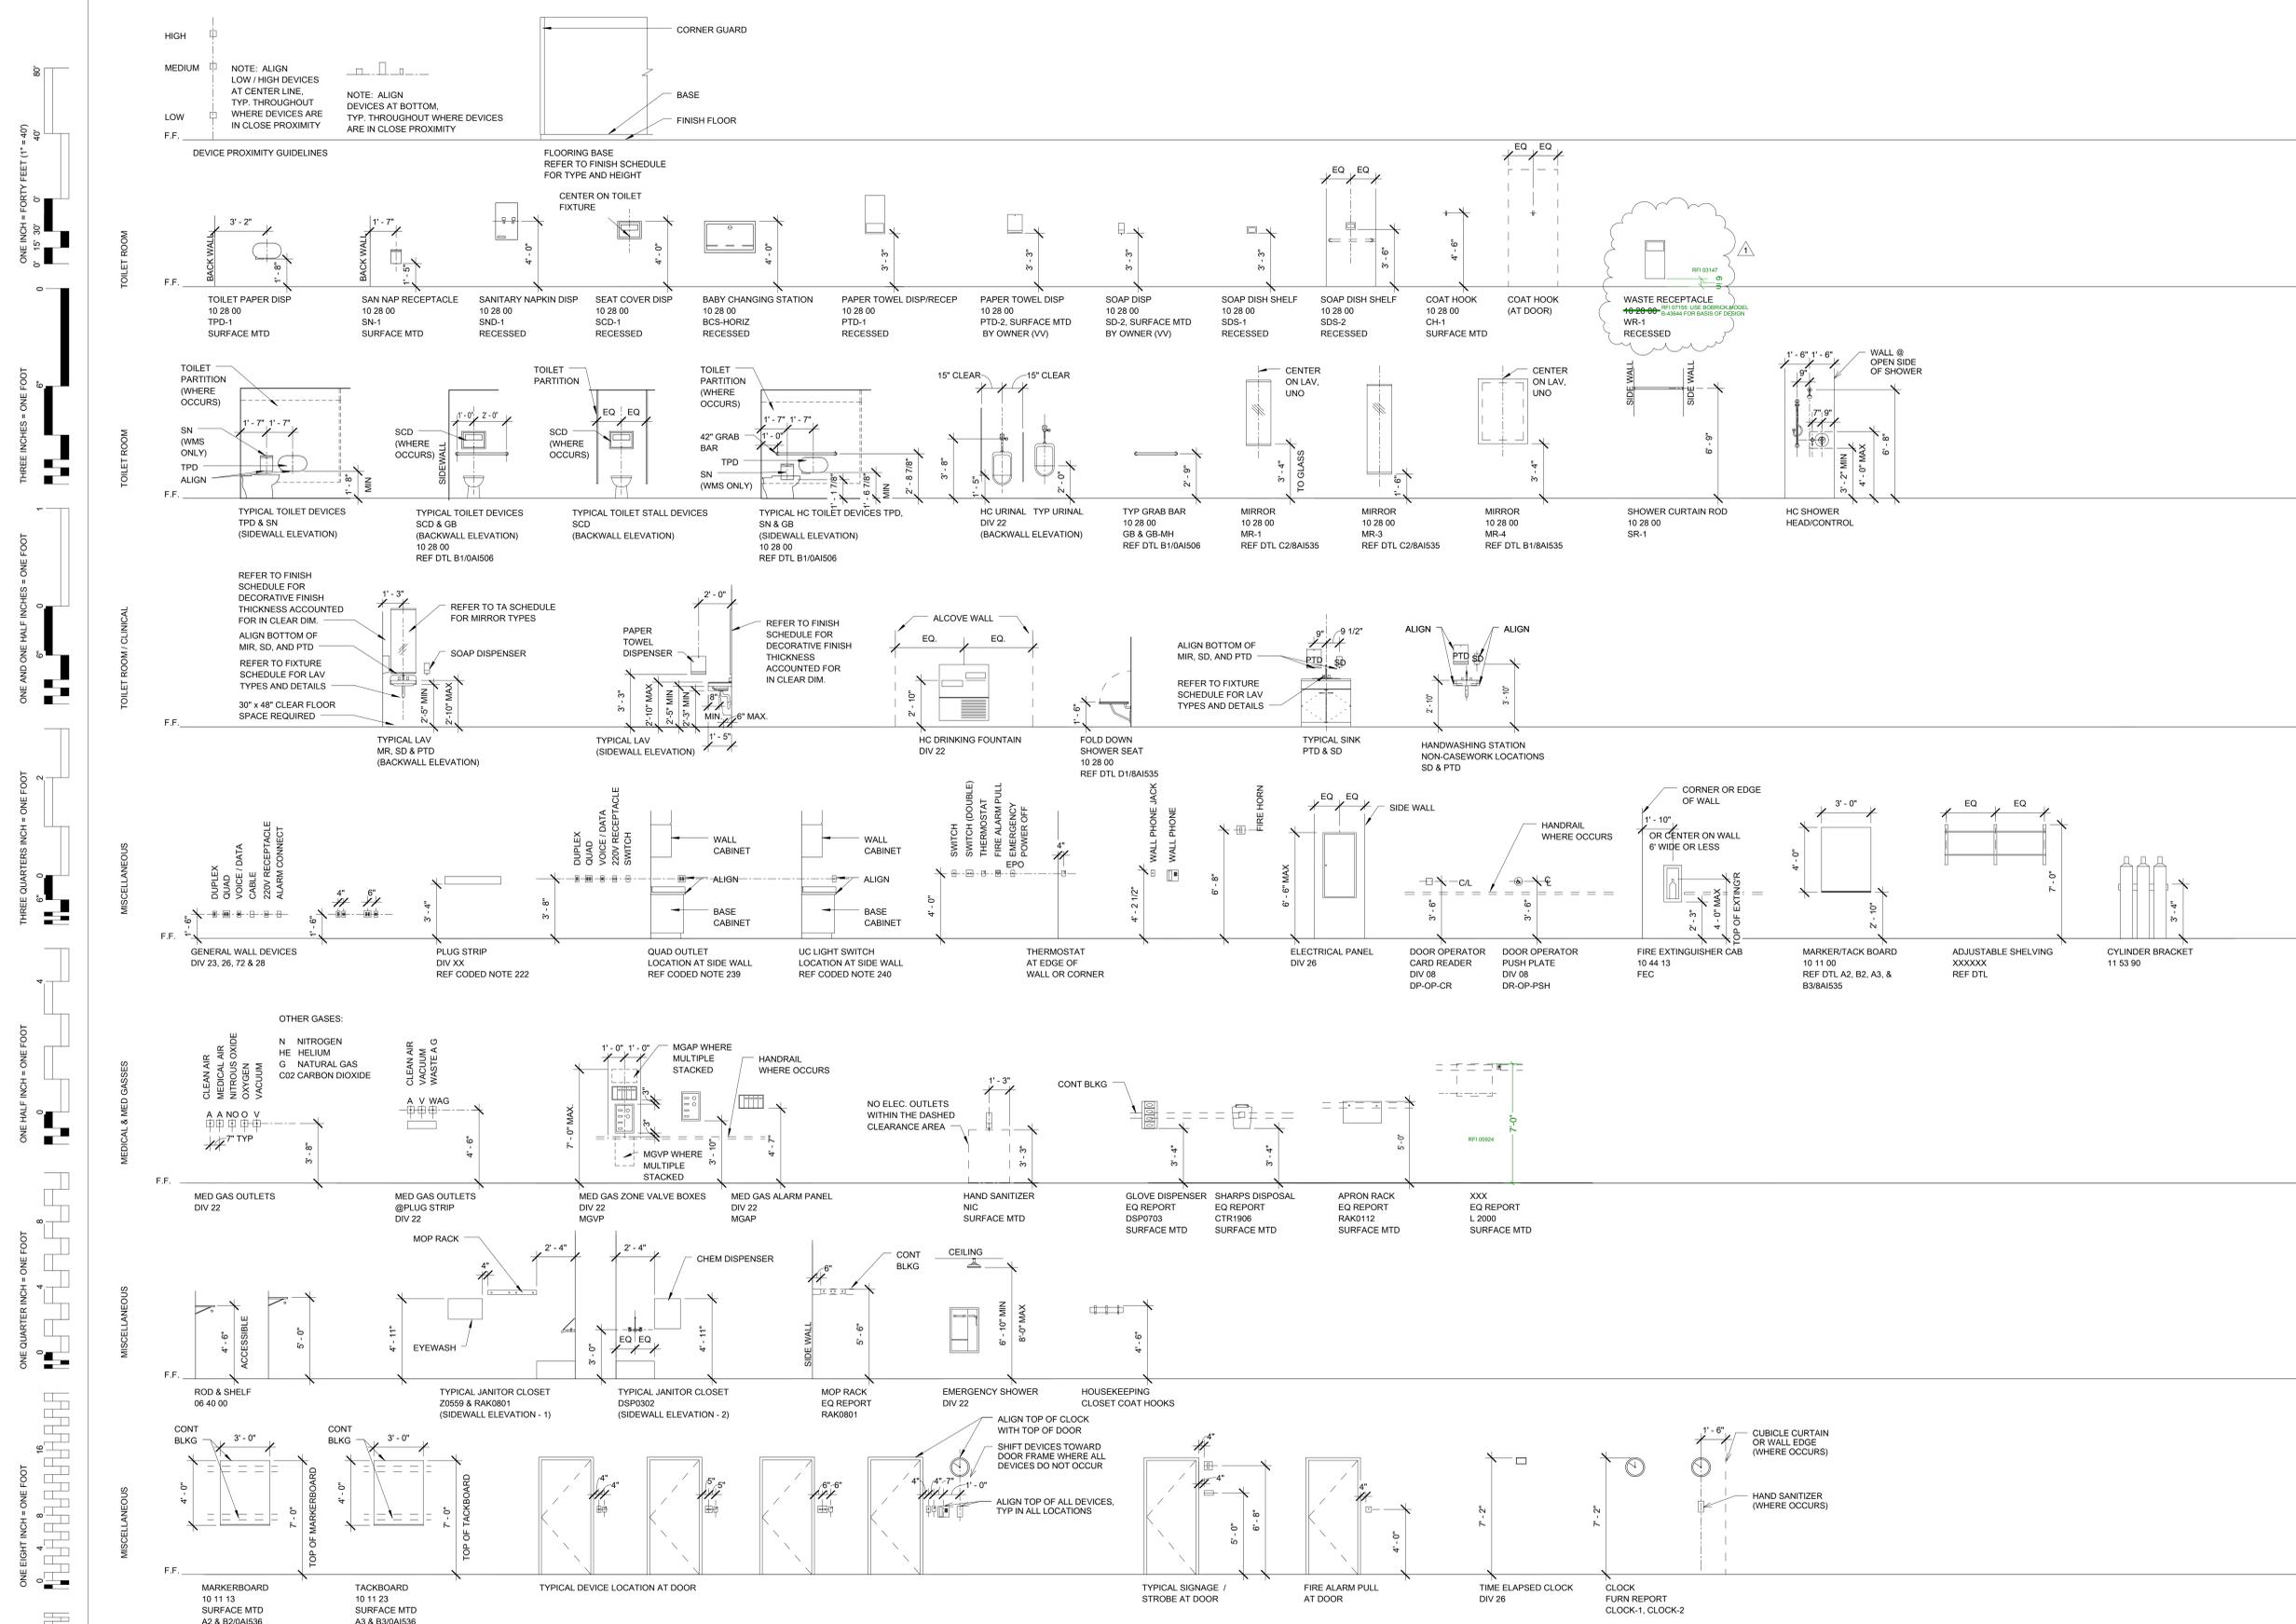

CONSULTANTS:
 DESMAN ASSOCIATES / PARKING
 CODE CONSULTANTS, INC. / CODE CONSULTANT
 THE SEXTANT GROUP / AV & ACOUSTICAL
 HAMMER DESIGN ASSOCIATES / FOOD SERVICE
 PYBURN & ODOM / ABATEMENT
 TATA & HOWARD / TANK CONSULTANT
 I.S.C. GROUP, INC. / IRRIGATION
 DAN EUSER WATER ARCHITECTURE, INC. / WATER FEATURE

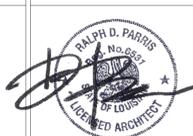

ARCHITECT/ENGINEERS:
 studio NOVA
 SCHRENK & PETERSON CONSULTING ENGINEERS / CIVIL
 KORDA/NEMETH ENGINEERING / STRUCTURAL
 BR+A CONSULTING ENGINEERS / MECH. ELECT, PLUMBING, LOW VOLTAGE
 ARCHITECTURAL ENGINEERING / PLUMBING
 SCALES ASSOCIATES / FIRE PROTECTION

DRAWING TITLE
 MOUNTING HEIGHTS SCHEDULE & GRAPHIC
 LEGEND

APPROVED: PROJECT DIRECTOR
Judd Jandrea

PROJECT TITLE
 SLVHCS REPLACEMENT MEDICAL
 CENTER PROJECT

LOCATION
 NEW ORLEANS, LOUISIANA

DATE
 July 16, 2012

CHECKED
 SG

DRAWN
 SG/AN

PROJECT NUMBER
 100342.00

BUILDING NUMBER
 08

DOCUMENT SET PACKAGE
 WP_09B

DRAWING NUMBER
 8A1200

OFFICE OF
 CONSTRUCTION
 AND FACILITIES
 MANAGEMENT

Department of
 Veterans Affairs