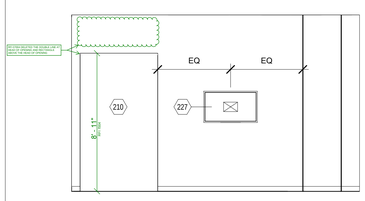

A6 1P100D Waiting- W
1/4" = 1'-0"

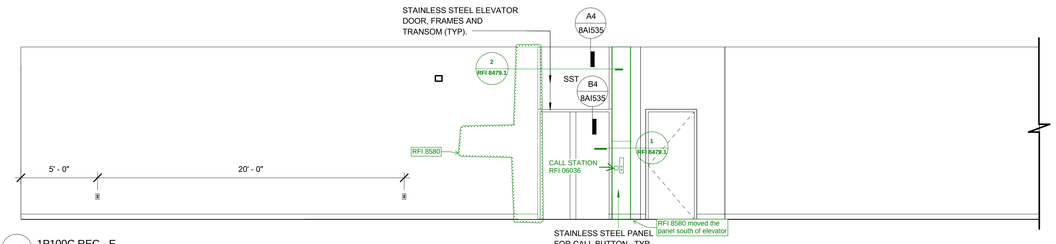

A5 1P100C REC - E
1/4" = 1'-0"

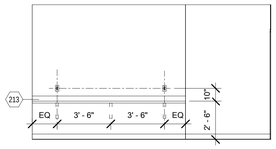

B6 IP108 CONF - S
1/4" = 1'-0"

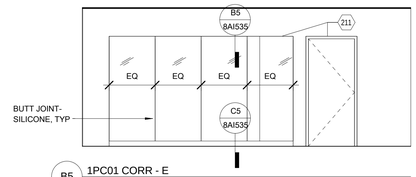

B5 1PC01 CORR - E
1/4" = 1'-0"

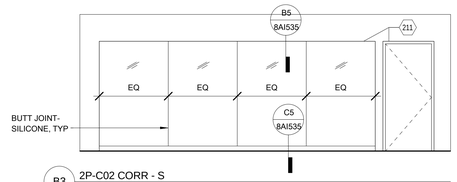

B3 2P-C02 CORR - S
1/4" = 1'-0"

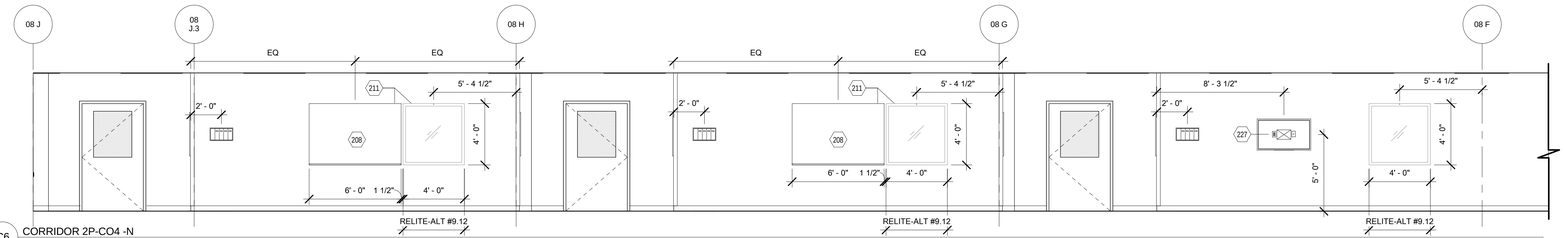

C6 CORRIDOR 2P-CO4 -N
1/4" = 1'-0"

D3 1P102 CPY- E
1/4" = 1'-0"

INTERIOR ELEVATIONS LEGEND

REF SHT 0AI400 FOR FLR PLAN, INT ELEV, RCP GEN NOTES, SHT NOTES AND SYMBOLS LEGENDS.
REF SHT 0AI201 FOR MOUNTING HEIGHTS SCHED AND GRAPHIC LEGEND OF WALL DEVICES.

REF: REFERS TO A DESIGNATED TYPICAL ROOM FOR PERTINENT INFO SUCH AS EQUIPMENT AND INTERIOR ELEVATION.

DSP0705 EXAMPLE OF MEDICAL EQUIPMENT TAG

B3030 **CASEWORK TYPE TAG**
- HEIGHT
- WIDTH
- TYPE- REFER TO DETAILS ON SHEET 0AI530-0AI534

CASEWORK - UNDERCABINET LIGHT FIXTURE

DEVICE PROXIMITY GUIDLINES

HIGH
MED
LOW
F.F.
VERTICAL DEVICE ALIGNMENT

NOTE: ALIGN LOW / HIGH DEVICES AT CENTER LINE, TYP. THROUGHOUT WHERE DEVICES ARE IN CLOSE PROXIMITY

F.F.
HORIZONTAL DEVICE ALIGNMENT

NOTE: ALIGN DEVICES AT TOP, TYP. THROUGHOUT WHERE DEVICES ARE IN CLOSE PROXIMITY

COUNTERTOP BRACKETS

SURFACE MTD BRACKET. SEE DETAIL E3/0AI532.

CONCEAL MTD BRACKET. SEE DETAIL C3/0AI532.

LEVEL HEAD

L-02 FLOOR
119'-0" FLOOR ELEVATION

GENERAL INTERIOR ELEVATION NOTES

1. REF SHT 8AI200 FOR GRAPHIC LEGEND OF WALL DEVICES AND TYP MTG HT, UON.
2. REF AF600 SERIES FIN SCHED FOR WALL AND CSWK FIN.
3. REF AF600 SERIES FOR WALL PROTECTION TYPES, CNR GD AND DET.
4. FOR TOIL ACCESSORIES, REF SHT 0AI201 FOR TYP MTG HT, UON; SHT 8AI620 FOR TOIL ACCESSORY LEGEND, TOIL ACCESSORY GROUPS AND TOIL ACCESSORY SCHED.
5. REF SHT 8A530-8AI532 FOR TYP CAB SECT AND DET.
6. REF AI600 SERIES FOR DR SCHEDULE, RELITE LEGEND AND DET.
7. REF AI140 SERIES FOR CLG HT.
8. REF AV DWG FOR DISPLAY EQUIP TYPES, SCHED, ELEV AND DET.
9. PROVIDE MIN 1" FILLER PNL(G) AGAINST FIN WALL PTN AND WHERE CSWK TURNS CNR @ WALL AND BASE CAB, UON.
10. ALL CNTR TOP 30" DEEP UON.
11. PROVIDE FIN PNL(G) ON ALL EXPOSED SIDES AND BACKS OF BASE AND WALL CAB.
12. PROVIDE SIDE SPLASH ON ALL SIDE WALLS AND WHERE INDICATED.
13. ALIGN ALL PWR/DATA OULETS LOCATED BELOW WALL CAB AND ABV BASE CAB W/ CENTER OF CAB AS SHOWN ON INT ELEV .
14. LTNG FIXT TYPES NOTED ON INT ELEV. REF ELEC LTNG DWG AND LUMINARE SCHED.

2XX INTERIOR ELEVATION SHEET NOTES

FLOOR PLAN SHEET NOTE SERIES BEGINS WITH NOTE 100
NOT ALL SHEET NOTES APPEAR ON EVERY SHEET

201. 10 26 00 WALL PROTECTION - REF AF100 SERIES.
202. 09 29 00 GWB SOFFIT - REF DET C2/8AI532.
203. 12 32 00 PLAM SOFFIT - REF DET C1/8AI532.
204. 12 32 00 SST SOFFIT TO MATCH SST CAB - REF SIM DET C1/8AI532.
205. 08 44 13 EXTR WINDOW/GLAZING.
206. WALL PNT TO EXTND TO UNDERSIDE OF SLAB.
207. 10 11 00 MARKER BOARD - SIZE AS NOTED ON SHT 8AI200, UON. REF DET A2 & B2/8AI535.
208. 10 11 00 TACK PANEL - SIZE AS NOTED ON SHT 8AI200, UON. REF DET A3 & B3/8AI535.
209. 12 36 00 GROMMET - LOCATE CENTERED ABOVE PWR/DATA OUTLETS.
210. OPEN.
211. ALIGN SURFACES/EDGES.
212. 12 36 00 PLAM CNTR AND BACKSPLASH - REF DET A3/8AI532.
213. 12 36 00 SOLID SURFACING CNTR TOP AND BACKSPLASH - REF DET A5/8AI532.
214. 12 36 00 SST CNTR TOP AND BACKSPLASH - REF DET A4/8AI532.
215. NOT USED.
216. 12 36 00 EPOXY CNTR TOP, BACKSPLASH. AND INTEGRAL SINK BASIN - REF DET A6/8AI532.
217. 12 36 00 EPOXY CNTR TOP, INTEGRAL SINK BASIN WTH SST DRAIN TROUGH AND BACKSPLASH - REF DET B3/8AI532.
218. PROVIDE LOCKING CAB DR.
219. HOSE BIB- REF PLBG DWG AND SPEC.
220. MARKERBOARD ON CAB DR, PLAM-6.
221. ACID NEUTRALIZATION TANK LOCATED BELOW SINK- REF DET Q/8AI530.
222. PLUG STRIP - REF ELEC DWG.
223. 09 30 13 CERAMIC TILE TRIM - REF DET D2/8AI535.
224. 10 28 00 FOLD DOWN SHR SEAT.
225. 12 31 00 SST SHELF - REF INT ELEV FOR WIDTH AND DEPTH-.?
226. 12 36 00 SST CNTR, BACKSPLASH AND INTEGRAL SINK BASIN. VERIFY DIMS WTH COLD RM FABRICATOR.
227. WALL MTD AV EQUIP - REF TA100 SERIES.
228. DECK MTD SST EYE WASH & HAND SPRAY- REF PLBG DWG.
229. NOT USED.
230. REC EMERG EYE/FACE WASH AND SHR SAFETY STATION WITH DRAIN PAN AND CLG MTD EXPOSED SST SHR HEAD - REF PLBG DWG.
232. EXHAUST DROP TO MATCH LOCATION OF EQUIPMENT Z0483. HOT & COLD WATER, AIR, VAC, WAG SERVICES FROM FLOOR AT BACK OF EQUIPMENT.
233. 4" GALVANIZED MTL PIPING SLEEVE WTH THREADED OPEN END CAP THRU PTN; PNT TO MATCH ADJACENT WALL.
234. 1 1/2" GALVANIZED MTL PIPING SLEEVE WTH THREADED OPEN END CAPS THRU PTN, PNT TO MATCH ADJACENT WALL.
235. SNORKEL DROP.
236. EXH VENT GRILLE- REF MECH DWG.
237. NOT USED.
238. 11 53 13 FUME HOOD.
239. QUAD OUTLET - LOCATE ON ADJACENT SIDE WALL. REF SHT 8AI200 FOR ALIGNMENT.
240. LT SWITCH FOR UNDERCABINET LT FIXT - LOCATE ON THE ADJACENT WALL. REF SHT 8AI200 FOR ALIGNMENT.
241. 12 36 00 ADJ PLAM SHELVING.
242. 11 71 02 STAINLESS STEEL MODULAR PARTITION.

CONSTRUCTION DOCUMENTS 1
FULLY SPRINKLERED

ONE INCH = FORTY FEET (1" = 40')
THREE INCHES = ONE FOOT
ONE AND ONE HALF INCHES = ONE FOOT
THREE QUARTERS INCH = ONE FOOT
ONE HALF INCH = ONE FOOT
ONE QUARTER INCH = ONE FOOT
ONE EIGHT INCH = ONE FOOT
ONE SIXTEENTH INCH = ONE FOOT

REVISIONS:	DATE

CONSULTANTS:
DESMAN ASSOCIATES / PARKING
CODE CONSULTANTS, INC. / CODE CONSULTANT
THE SEXTANT GROUP / AV & ACOUSTICAL
HAMMER DESIGN ASSOCIATES / FOOD SERVICE
PYBURN & ODOM / ABATEMENT
TATA & HOWARD / TANK CONSULTANT
I.S.C. GROUP, INC. / IRRIGATION
DAN EUSER WATER ARCHITECTURE, INC. / WATER FEATURE

RALPH D. PARRIS No. 13557 STATE OF LOUISIANA LICENSED ARCHITECT

ARCHITECT/ENGINEERS:
studioNOVA
SCHRENK & PETERSON CONSULTING ENGINEERS / CIVIL
KORDA/NEMETH ENGINEERING / STRUCTURAL
BR+A CONSULTING ENGINEERS / MECH, ELECT, PLUMBING, LOW VOLTAGE
ARCHITECTURAL ENGINEERING / PLUMBING
SCALES ASSOCIATES / FIRE PROTECTION

DRAWING TITLE	BLDG 8 INTERIOR ELEVATIONS
APPROVED: PROJECT DIRECTOR	
PROJECT TITLE	SLVHCS REPLACEMENT MEDICAL CENTER PROJECT
LOCATION	NEW ORLEANS, LOUISIANA
DATE	July 16, 2012
CHECKED	SG
DRAWN	SG/AN
PROJECT NUMBER	100342.00
BUILDING NUMBER	08
DOCUMENT SET PACKAGE	WP_09B
DRAWING NUMBER	8AI201

OFFICE OF CONSTRUCTION AND FACILITIES MANAGEMENT
Department of Veterans Affairs

VA FORM 08-6231