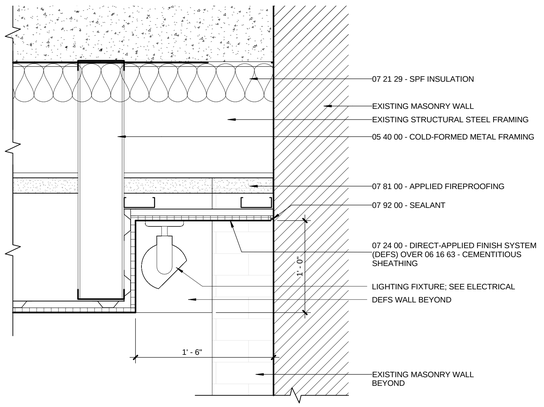

B6 SECTION THRU CARRIAGEWAY CEILING COVE
SCALE: 1 1/2" = 1'-0"

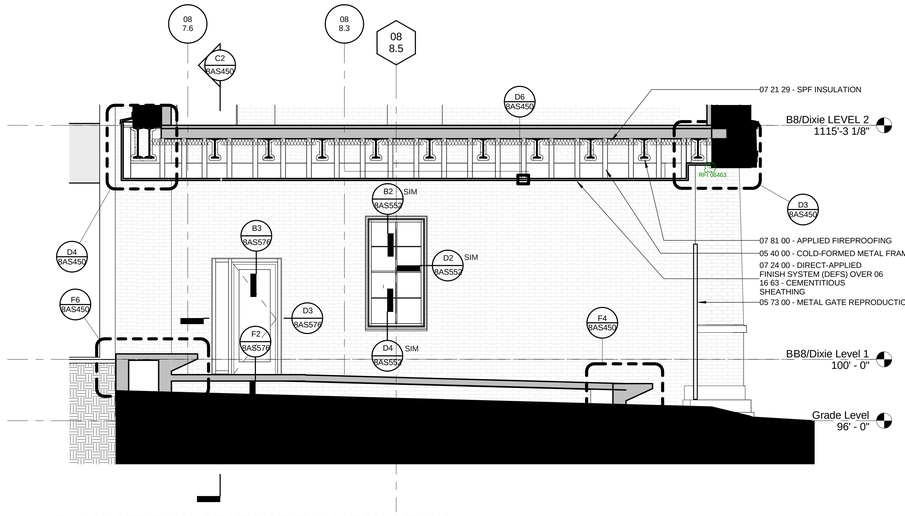

C4 LONGITUDINAL SECTION THRU CARRIAGEWAY
SCALE: 1/4" = 1'-0"

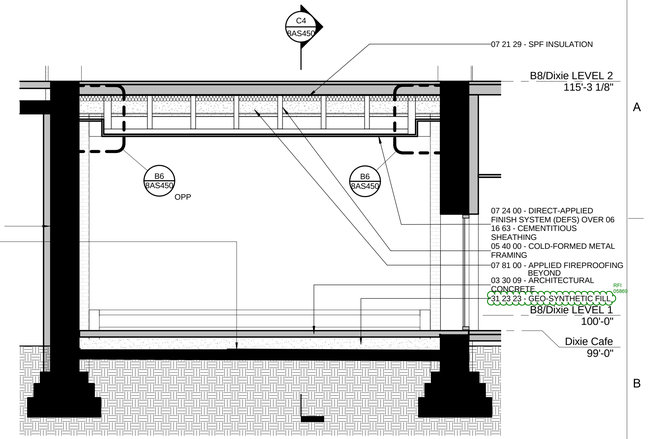

C2 TRANSVERSE SECTION THRU CARRIAGEWAY
SCALE: 1/4" = 1'-0"

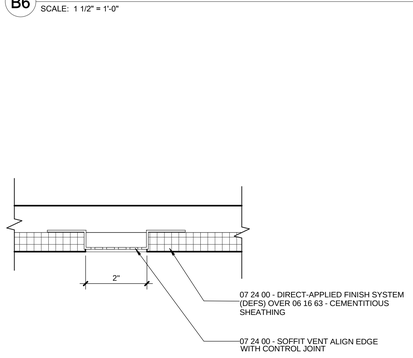

D6 SECTION THRU SOFFIT VENT
SCALE: 6" = 1'-0"

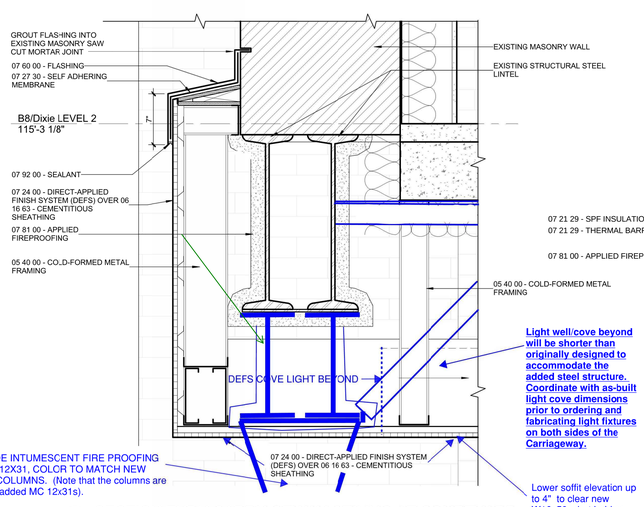

D4 SECTION THRU CARRIAGEWAY CEILING AT COURTYARD
SCALE:

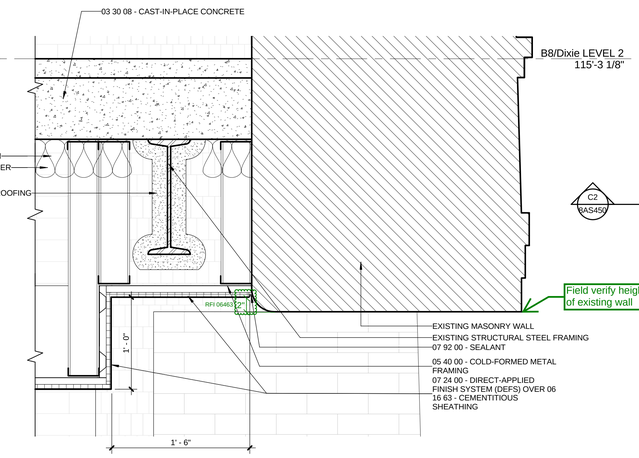

D3 SECTION THRU CARRIAGEWAY CEILING AT PORTAL
SCALE: 1 1/2" = 1'-0"

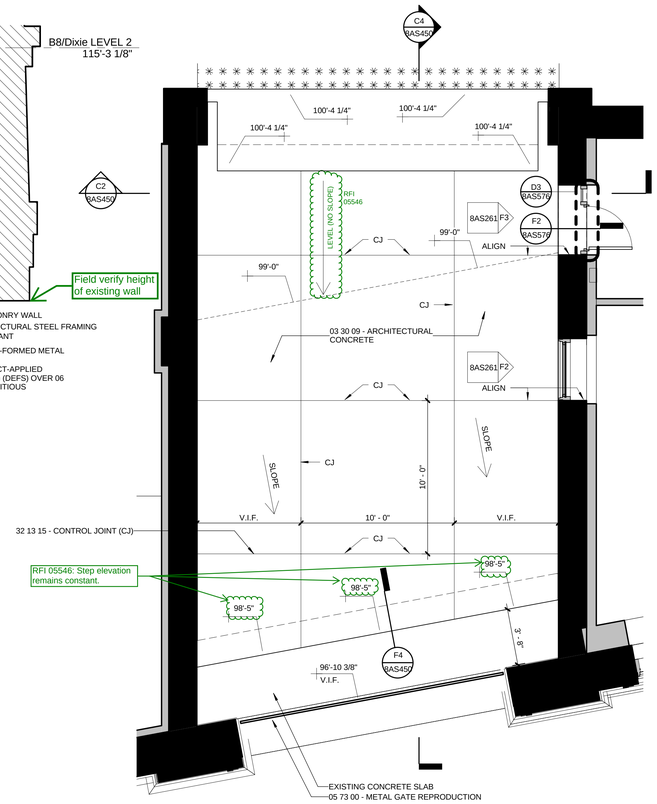

F2 ENLARGED PLAN OF CARRIAGEWAY
SCALE: 1/4" = 1'-0"

RFI 8563 ATTACHMENT - 10/13/16

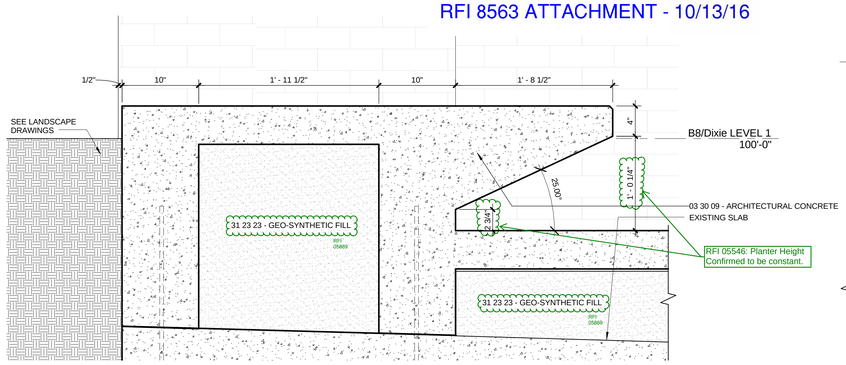

F6 SECTION THRU CARRIAGEWAY AT PLANTER
SCALE: 1 1/2" = 1'-0"

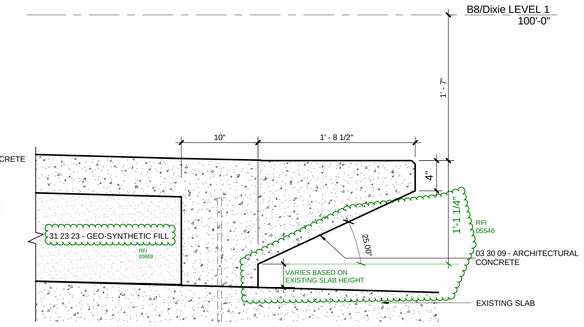

F4 SECTION AT FRONT OF CARRIAGEWAY
SCALE: 1 1/2" = 1'-0"

CONSTRUCTION DOCUMENTS 1
FULLY SPRINKLERED

REVISIONS:	DATE

CONSULTANTS:
DESMAN ASSOCIATES / PARKING
CODE CONSULTANTS, INC / CODE CONSULTANT
THE SEXTANT GROUP / AV & ACOUSTICAL
HAMMER DESIGN ASSOCIATES / FOOD SERVICE
PYBURN & ODOM / ABATEMENT
TATA & HOWARD / TANK CONSULTANT
I.S.C. GROUP, INC / IRRIGATION
DAN EUSER WATER ARCHITECTURE, INC / WATER FEATURE

MARK J. RIPPLE REG. NO. 3454 STATE OF LOUISIANA REGISTERED ARCHITECT

ARCHITECT/ENGINEERS:
studioNOVA
SCHRENK & PETERSON CONSULTING ENGINEERS / CIVIL
KORDA/NEMETH ENGINEERING / STRUCTURAL
BR+A CONSULTING ENGINEERS / MECH & ELEC
ARCHITECTURAL ENGINEERING / PLUMBING
SCALES ASSOCIATES / FIRE PROTECTION
COMMUNICATIONS DESIGN GROUP / LOW VOLTAGE

DRAWING TITLE	BLDG 8 DIXIE CARRIAGEWAY DETAILS
APPROVED: PROJECT DIRECTOR	Todd Sanders
PROJECT TITLE	SLVHCS REPLACEMENT MEDICAL CENTER PROJECT
LOCATION	NEW ORLEANS, LOUISIANA
DATE	July 16, 2012
CHECKED	CD
DRAWN	AM
PROJECT NUMBER	629-HS2-401
BUILDING NUMBER	8
DOCUMENT SET PACKAGE	WP_9B
DRAWING NUMBER	8AS450

OFFICE OF CONSTRUCTION AND FACILITIES MANAGEMENT
Department of Veterans Affairs

VA FORM 08-6231