



LEVEL - 04 AREA - P

REFERENCE SHEET 8A1002 FOR PARTITION TYPE SCHEDULE  
REFERENCE SHEET 8A1400 FOR INTERIOR ELEVATION GENERAL NOTES  
AND CODED NOTES  
REFERENCE SHEET 8A1400 FOR RCP GENERAL NOTES AND CODED NOTES  
REFERENCE SHEET 8A1200 FOR TYPICAL MOUNTING HEIGHTS  
REFERENCE SHEET 8A1201 FOR GRAPHIC LEGEND OF WALL DEVICES

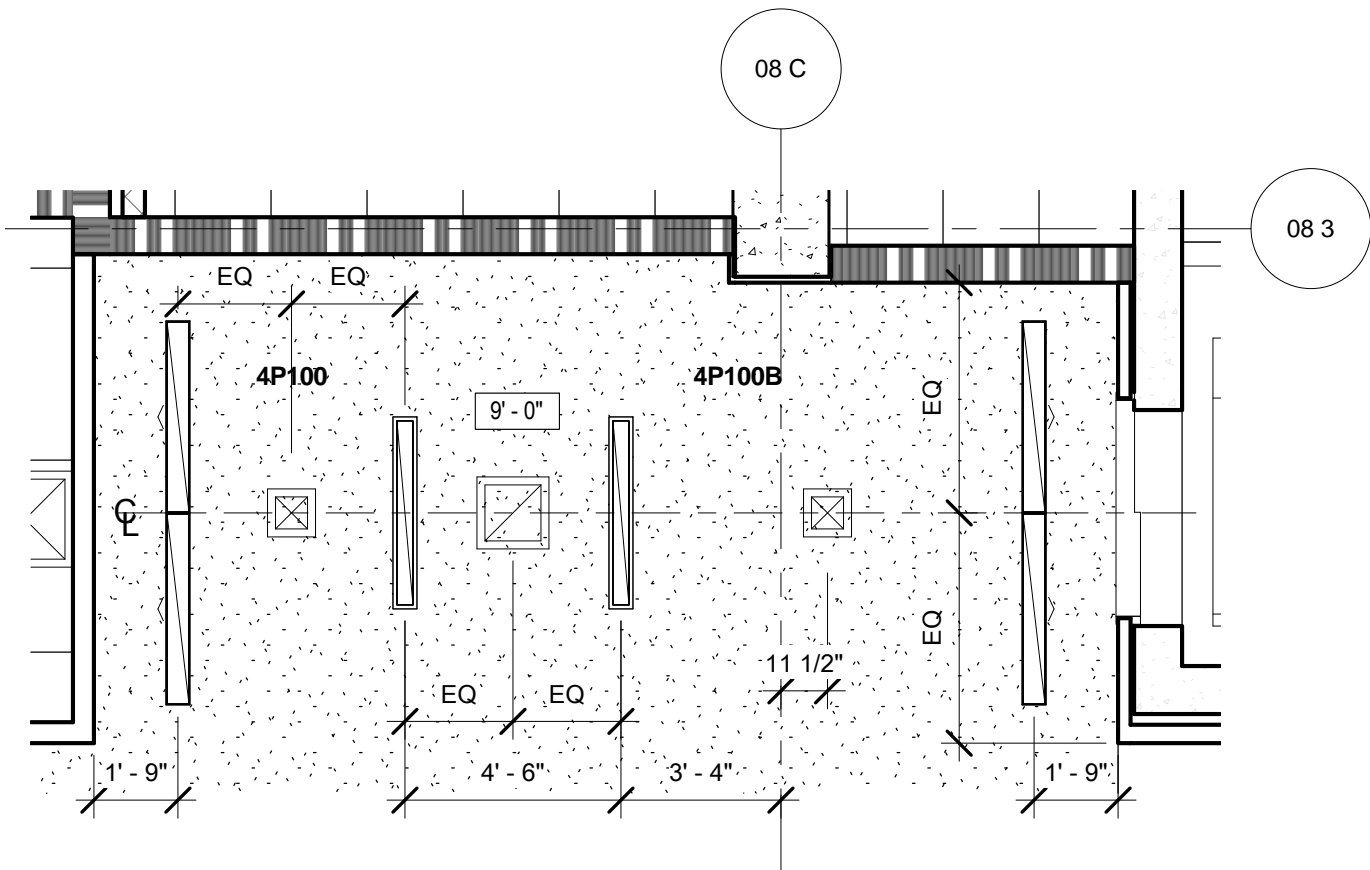


B3 4P100 LOBBY - RCP  
1/4" = 1'-0"

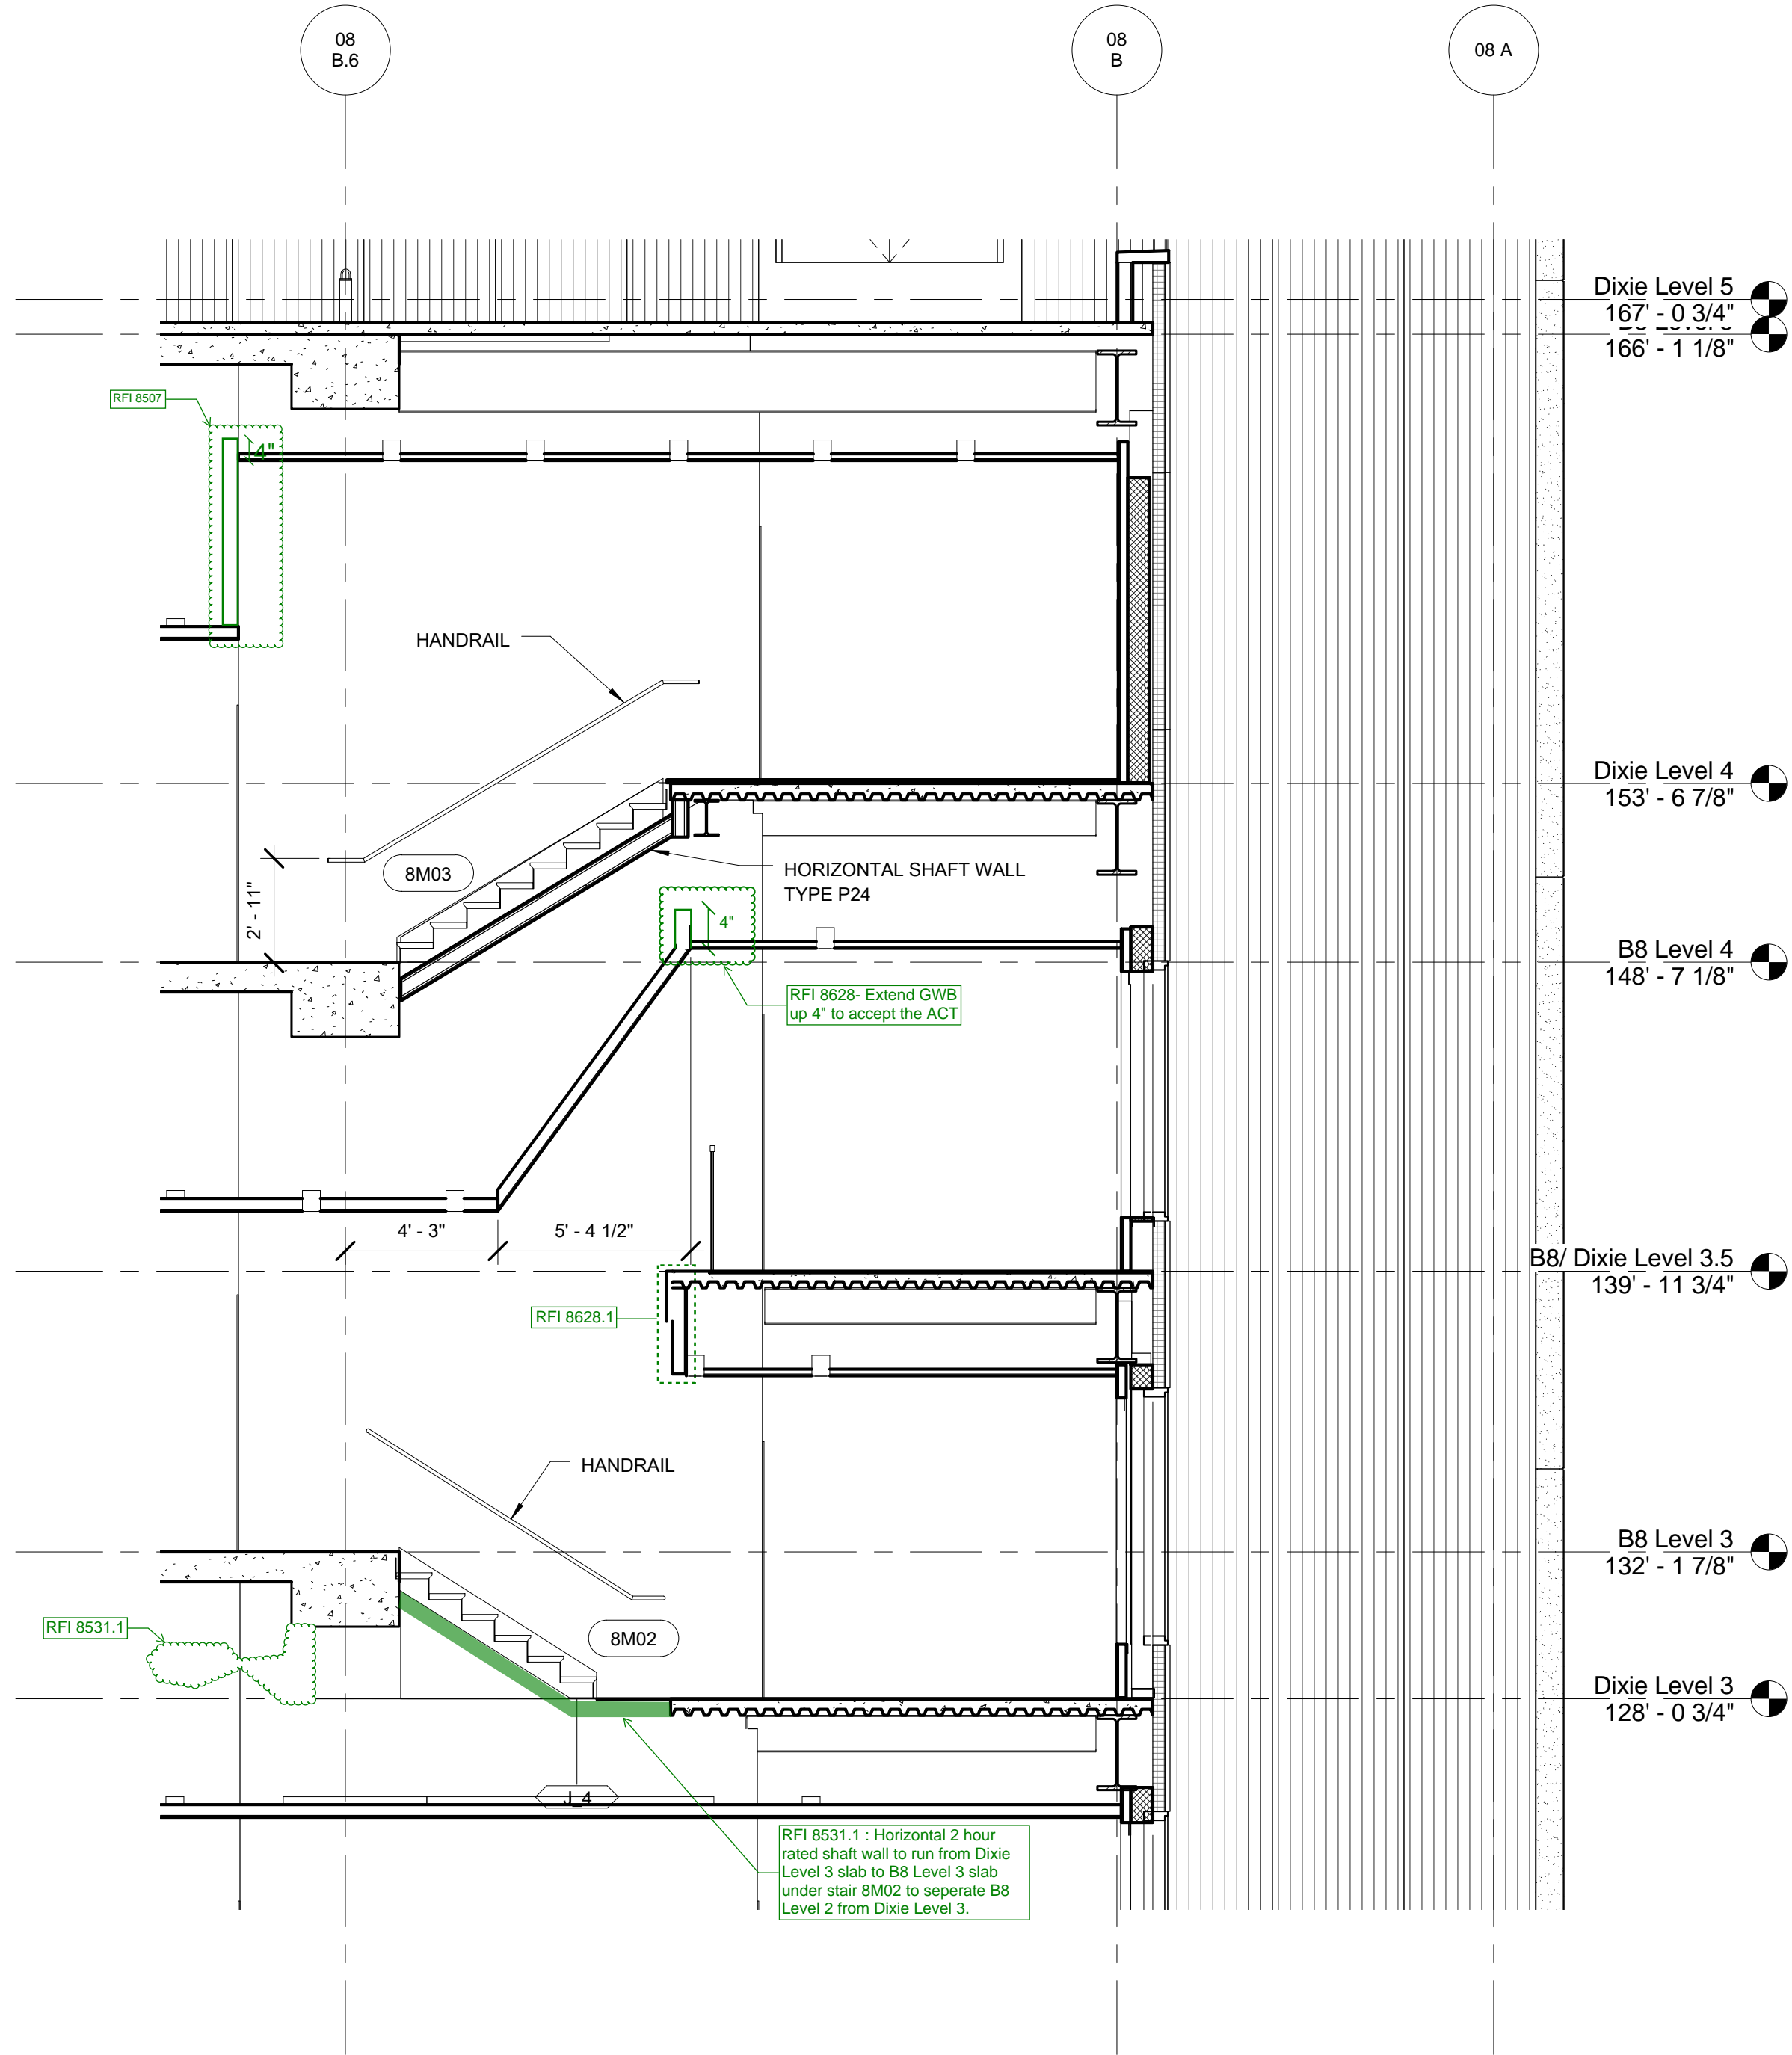

F3 20 Section Level 3 & 3.5  
1/4" = 1'-0"

CONSULTANTS:

DESMAN ASSOCIATES / PARKING  
CODE CONSULTANTS, INC. / CODE CONSULTANT  
THE SEXTANT GROUP / AV & ACOUSTICAL  
HAMMER DESIGN ASSOCIATES / FOOD SERVICE  
PYBURN & ODOM / ABATEMENT  
TATA & HOWARD / TANK CONSULTANT  
I.S.C. GROUP, INC. / IRRIGATION  
DAN EUSER WATER ARCHITECTURE, INC. / WATER FEATURE

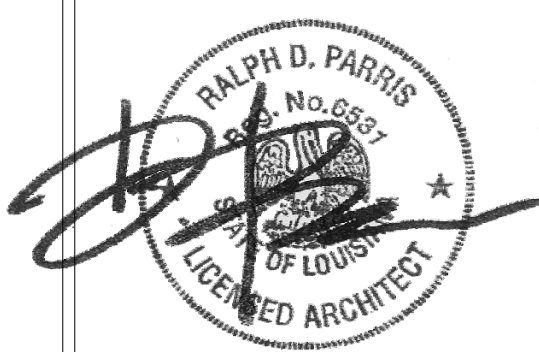

ARCHITECT/ENGINEERS:

studio **NOVA**  
SCHRENK & PETERSON CONSULTING ENGINEERS / CIVIL  
KORDA/NEMETH ENGINEERING / STRUCTURAL  
BR+A CONSULTING ENGINEERS / MECH, ELECT, PLUMBING, LOW VOLTAGE  
ARCHITECTURAL ENGINEERING / PLUMBING  
SCALES ASSOCIATES / FIRE PROTECTION

DRAWING TITLE  
BLDG 8 ENLARGED VIEWS

APPROVED: PROJECT DIRECTOR

*Judd Sanders*

PROJECT TITLE  
SLVHCS REPLACEMENT MEDICAL  
CENTER PROJECT

LOCATION  
NEW ORLEANS, LOUISIANA

DATE  
July 16, 2012

CHECKED  
JK

DRAWN  
JK

PROJECT NUMBER  
100342.00  
BUILDING NUMBER  
08  
DOCUMENT SET PACKAGE  
WP\_09B

DRAWING NUMBER

8A1405

OFFICE OF  
CONSTRUCTION  
AND FACILITIES  
MANAGEMENT

