



LEVEL - 02 AREA - P


REFERENCE SHEET 8A1002 FOR PARTITION TYPE SCHEDULE
REFERENCE SHEET 8A1400 FOR INTERIOR ELEVATION GENERAL NOTES
AND CODED NOTES
REFERENCE SHEET 8A1400 FOR RCP GENERAL NOTES AND CODED NOTES
REFERENCE SHEET 8A1200 FOR TYPICAL MOUNTING HEIGHTS
REFERENCE SHEET 8A1201 FOR GRAPHIC LEGEND OF WALL DEVICES

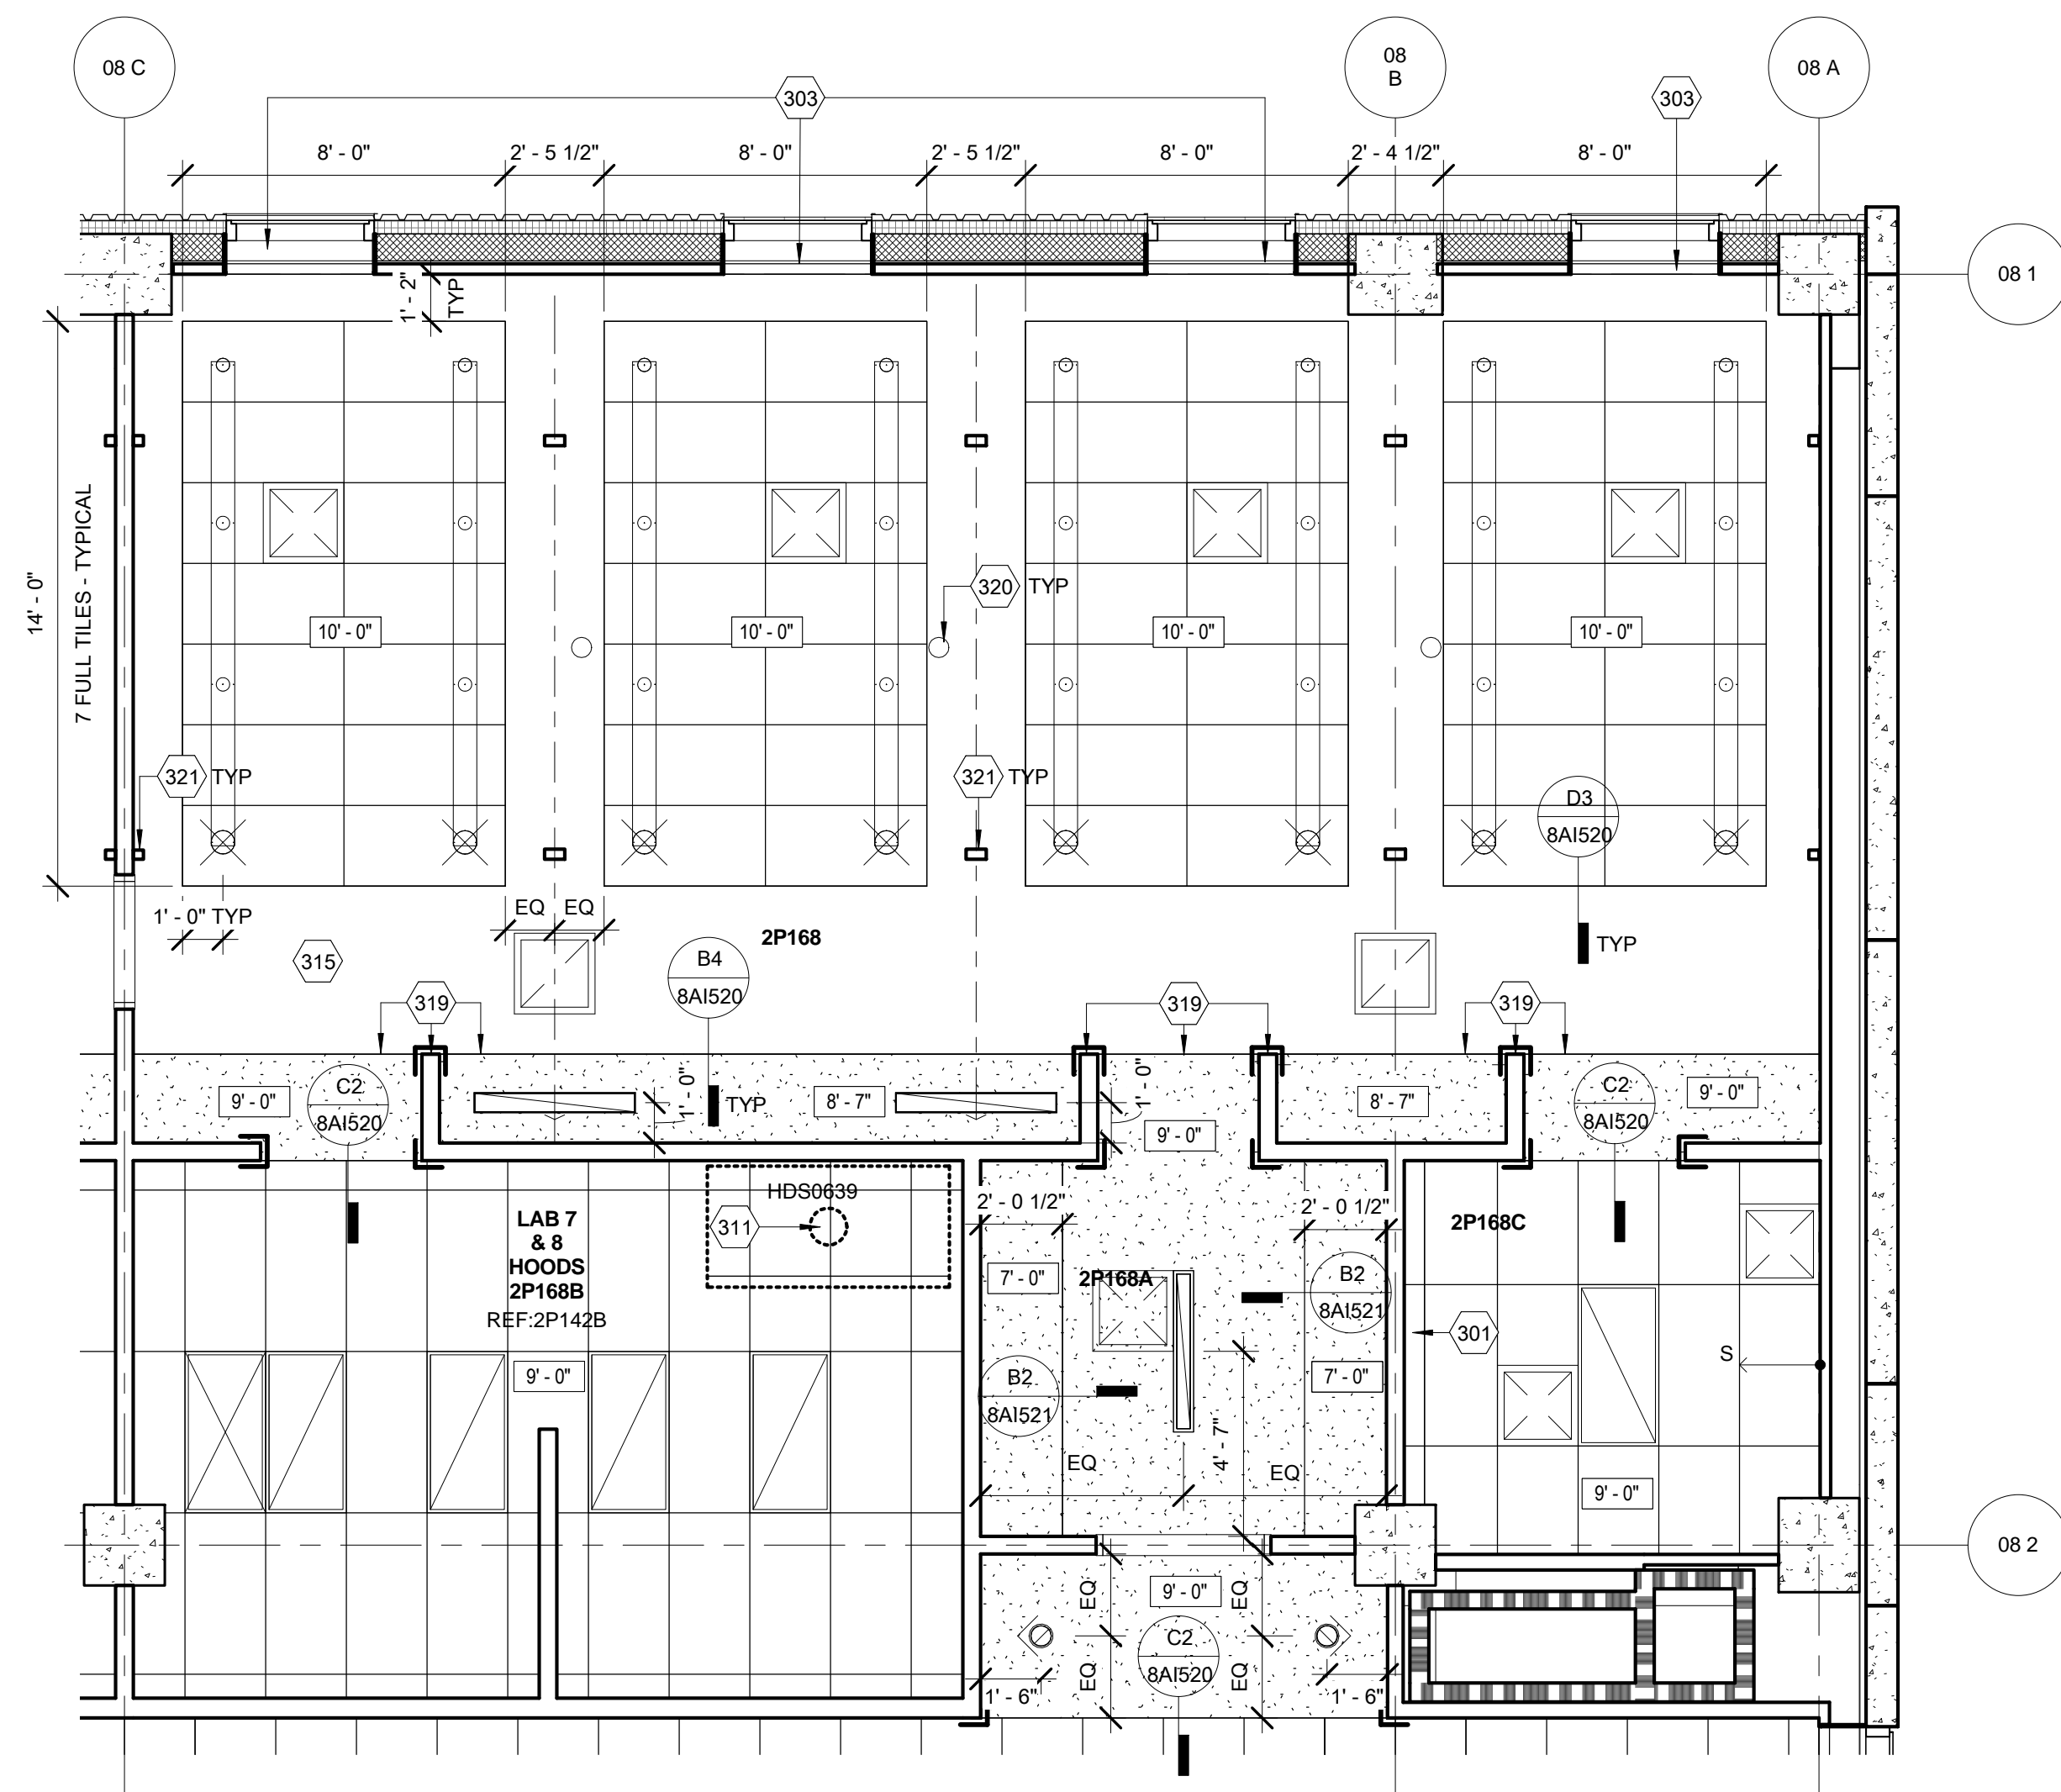


C6 2P168 LAB 7 & 8 - RCP
1/4" = 1'-0"

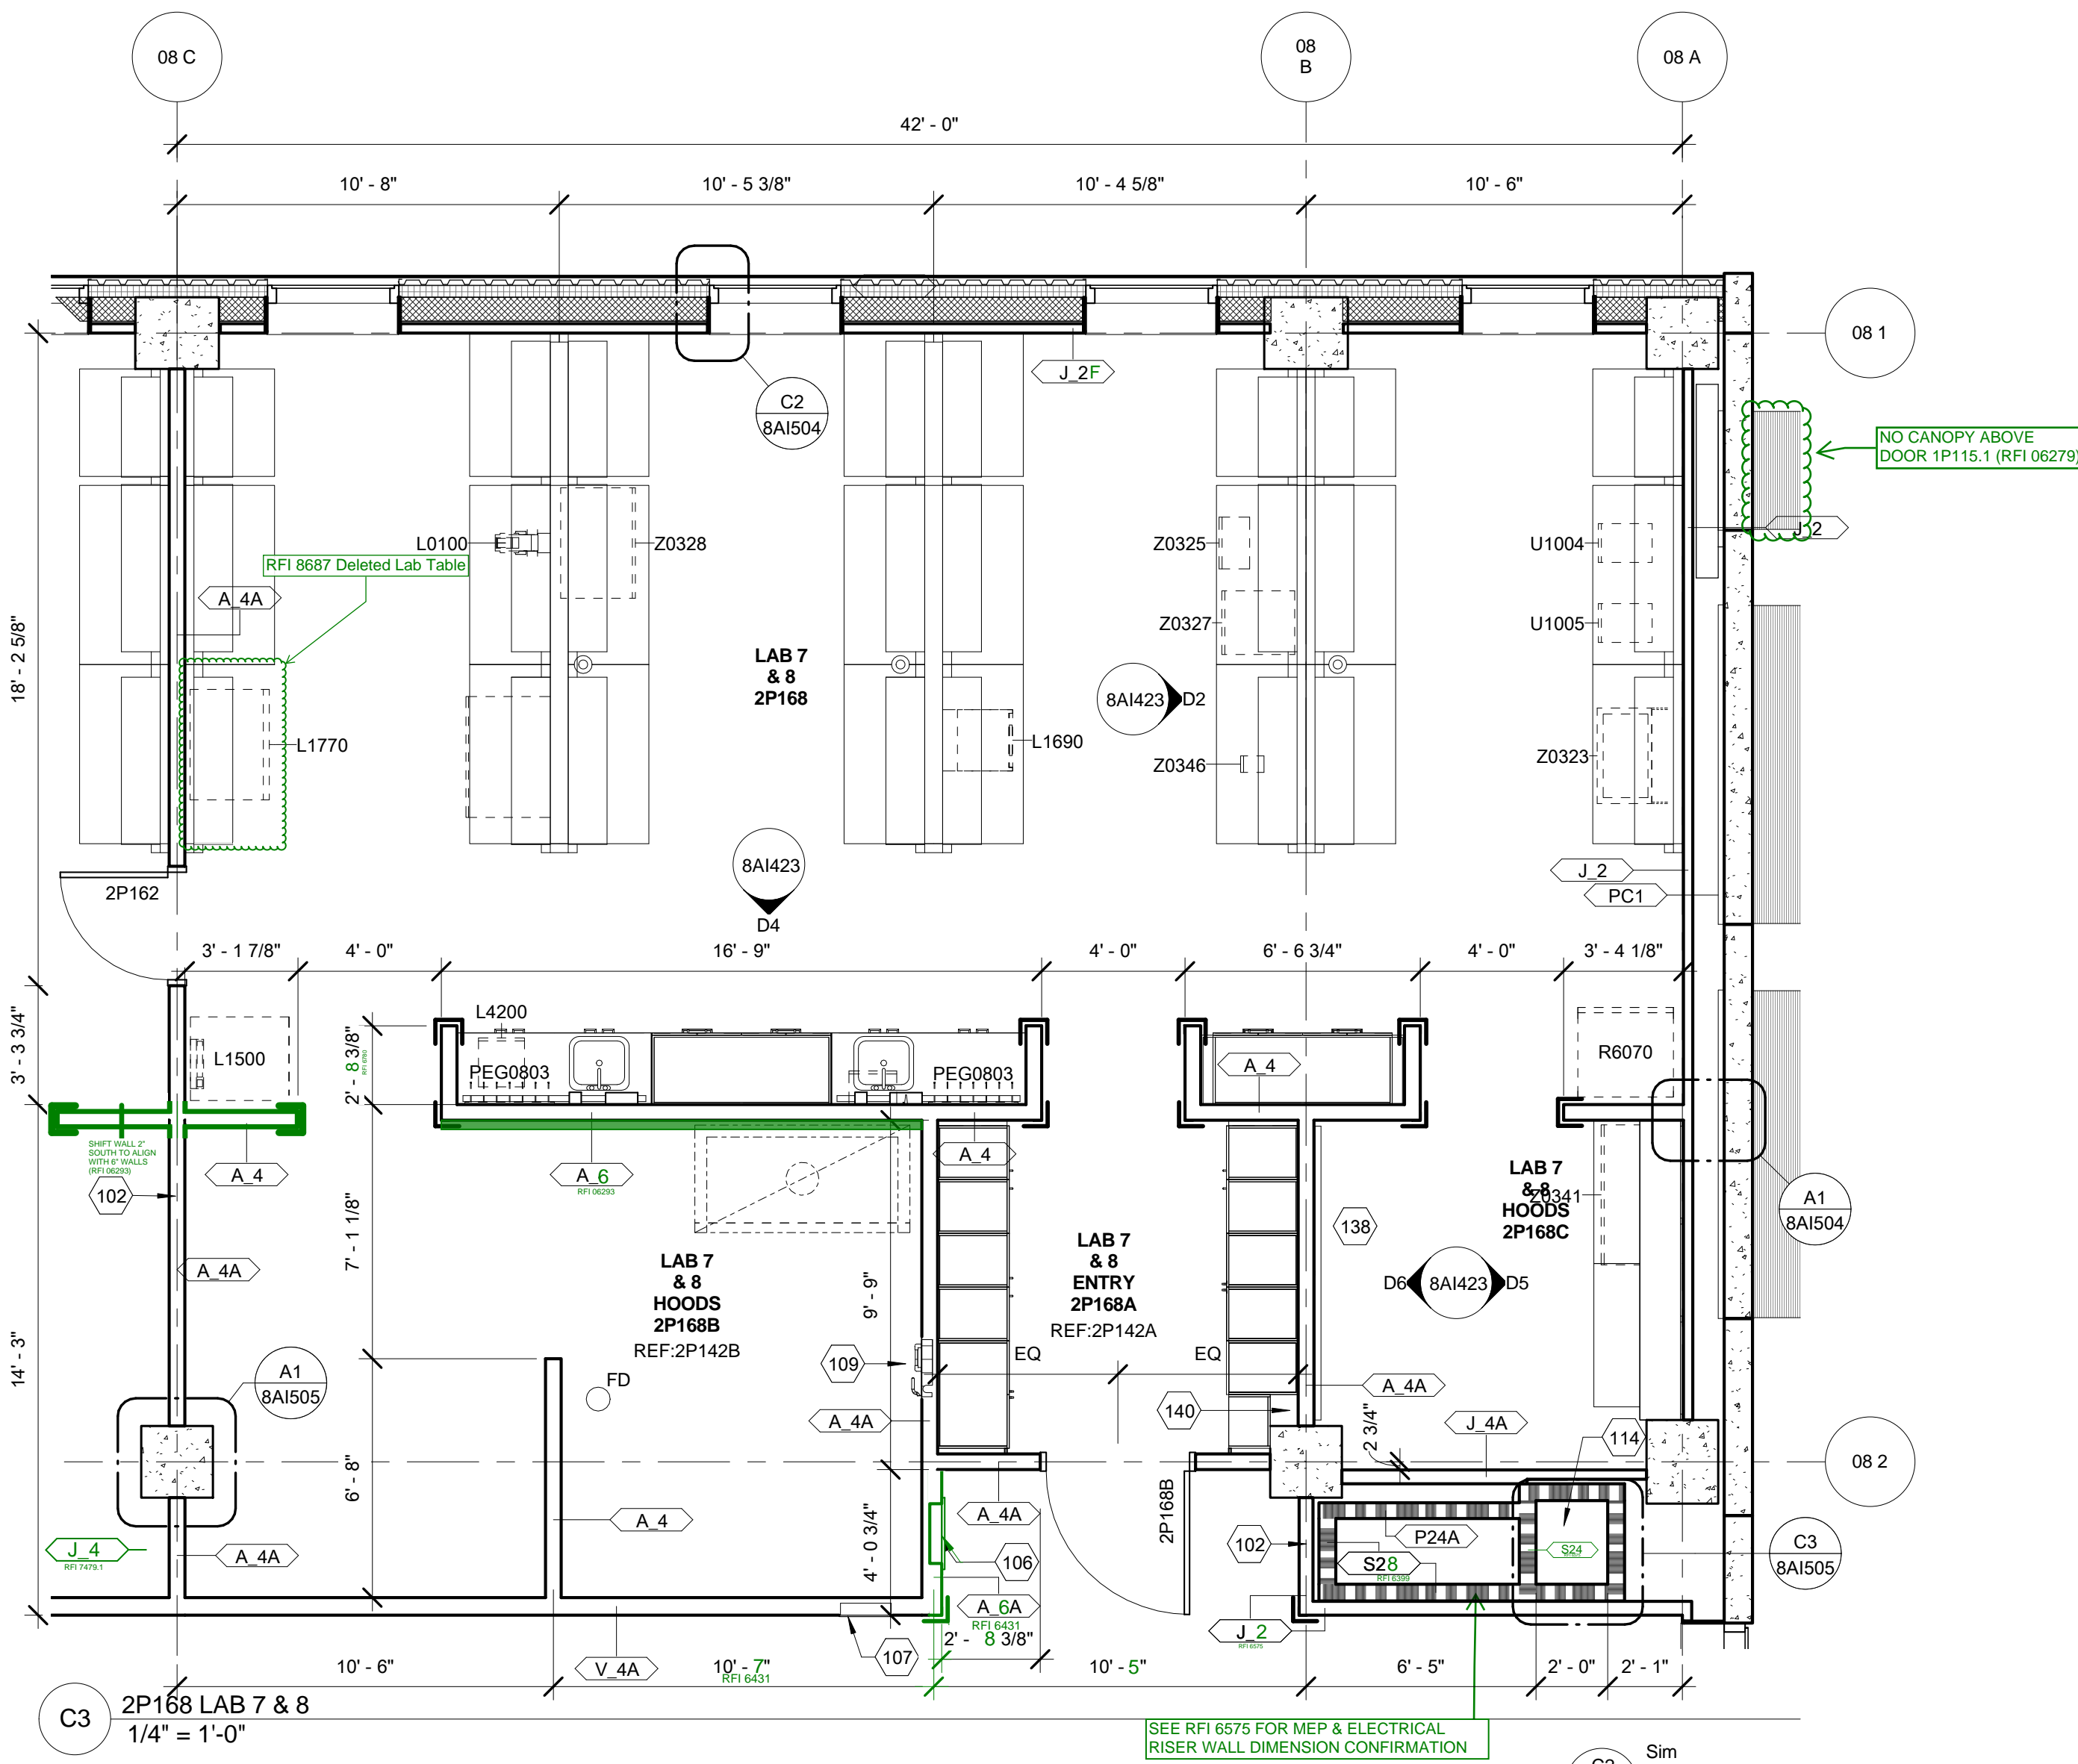


C3 2P168 LAB 7 & 8
1/4" = 1'-0"

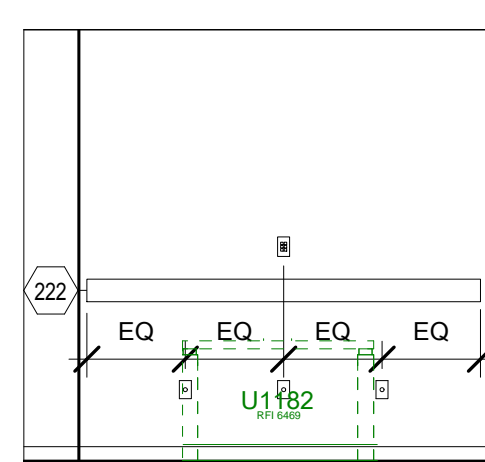


D6 2P168C LAB 7 & 8 HOODS - W
1/4" = 1'-0"

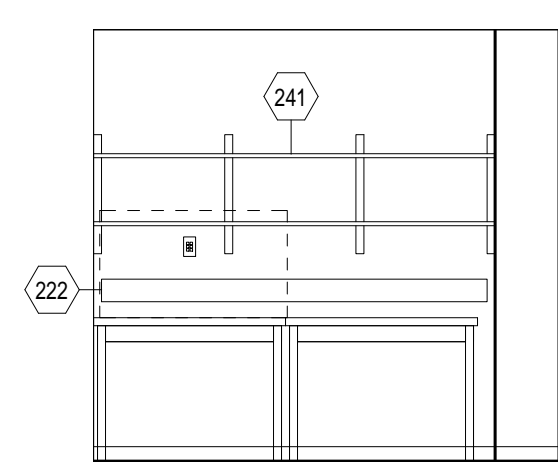


D5 2P168C LAB 7 & 8 HOODS - E
1/4" = 1'-0"

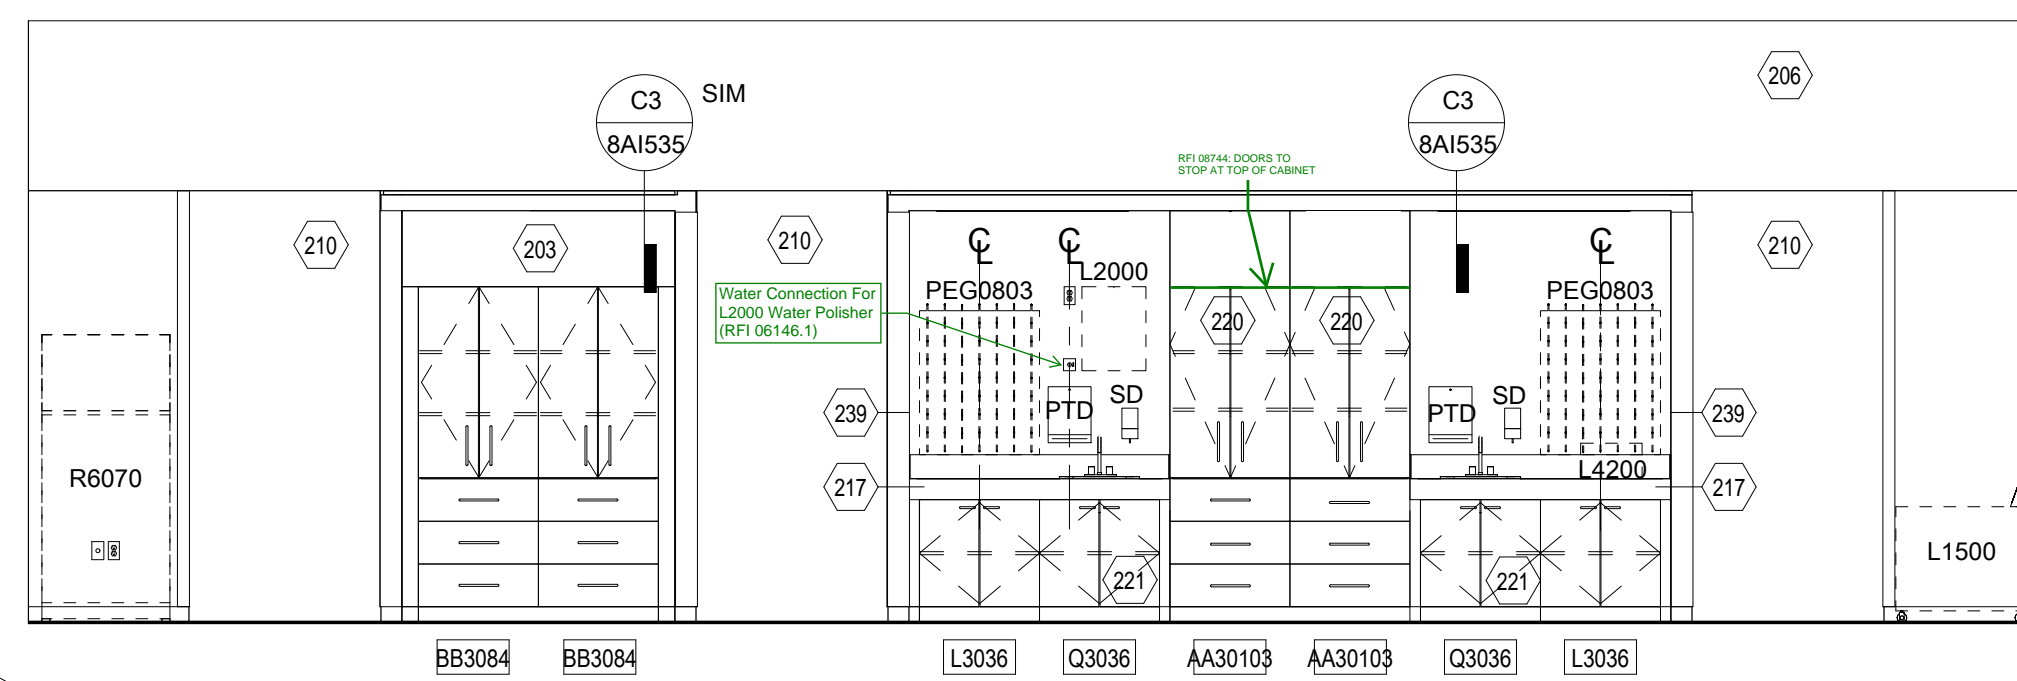


D4 2P168 LAB 7 & 8 - S
1/4" = 1'-0"

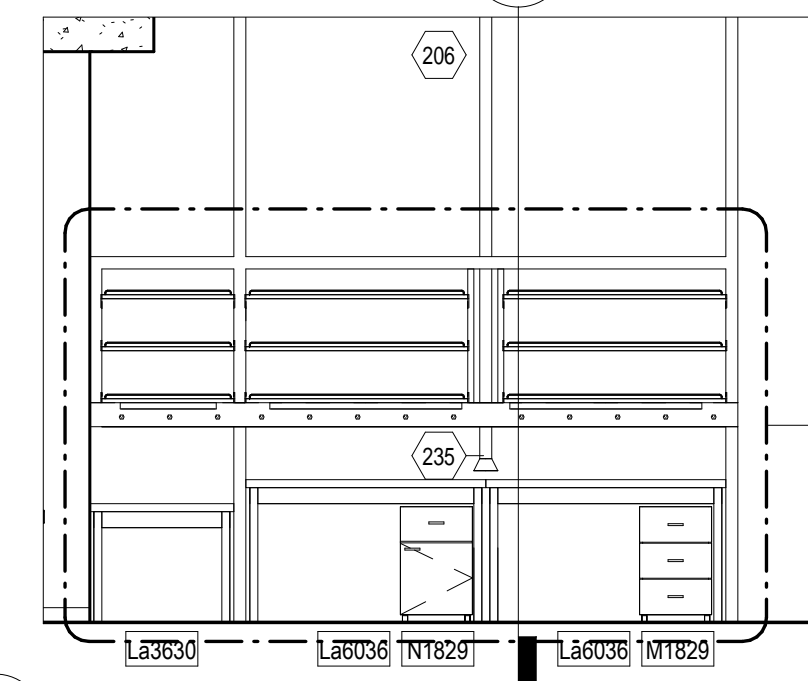


D2 2P168 LAB TYPICAL 3
1/4" = 1'-0"

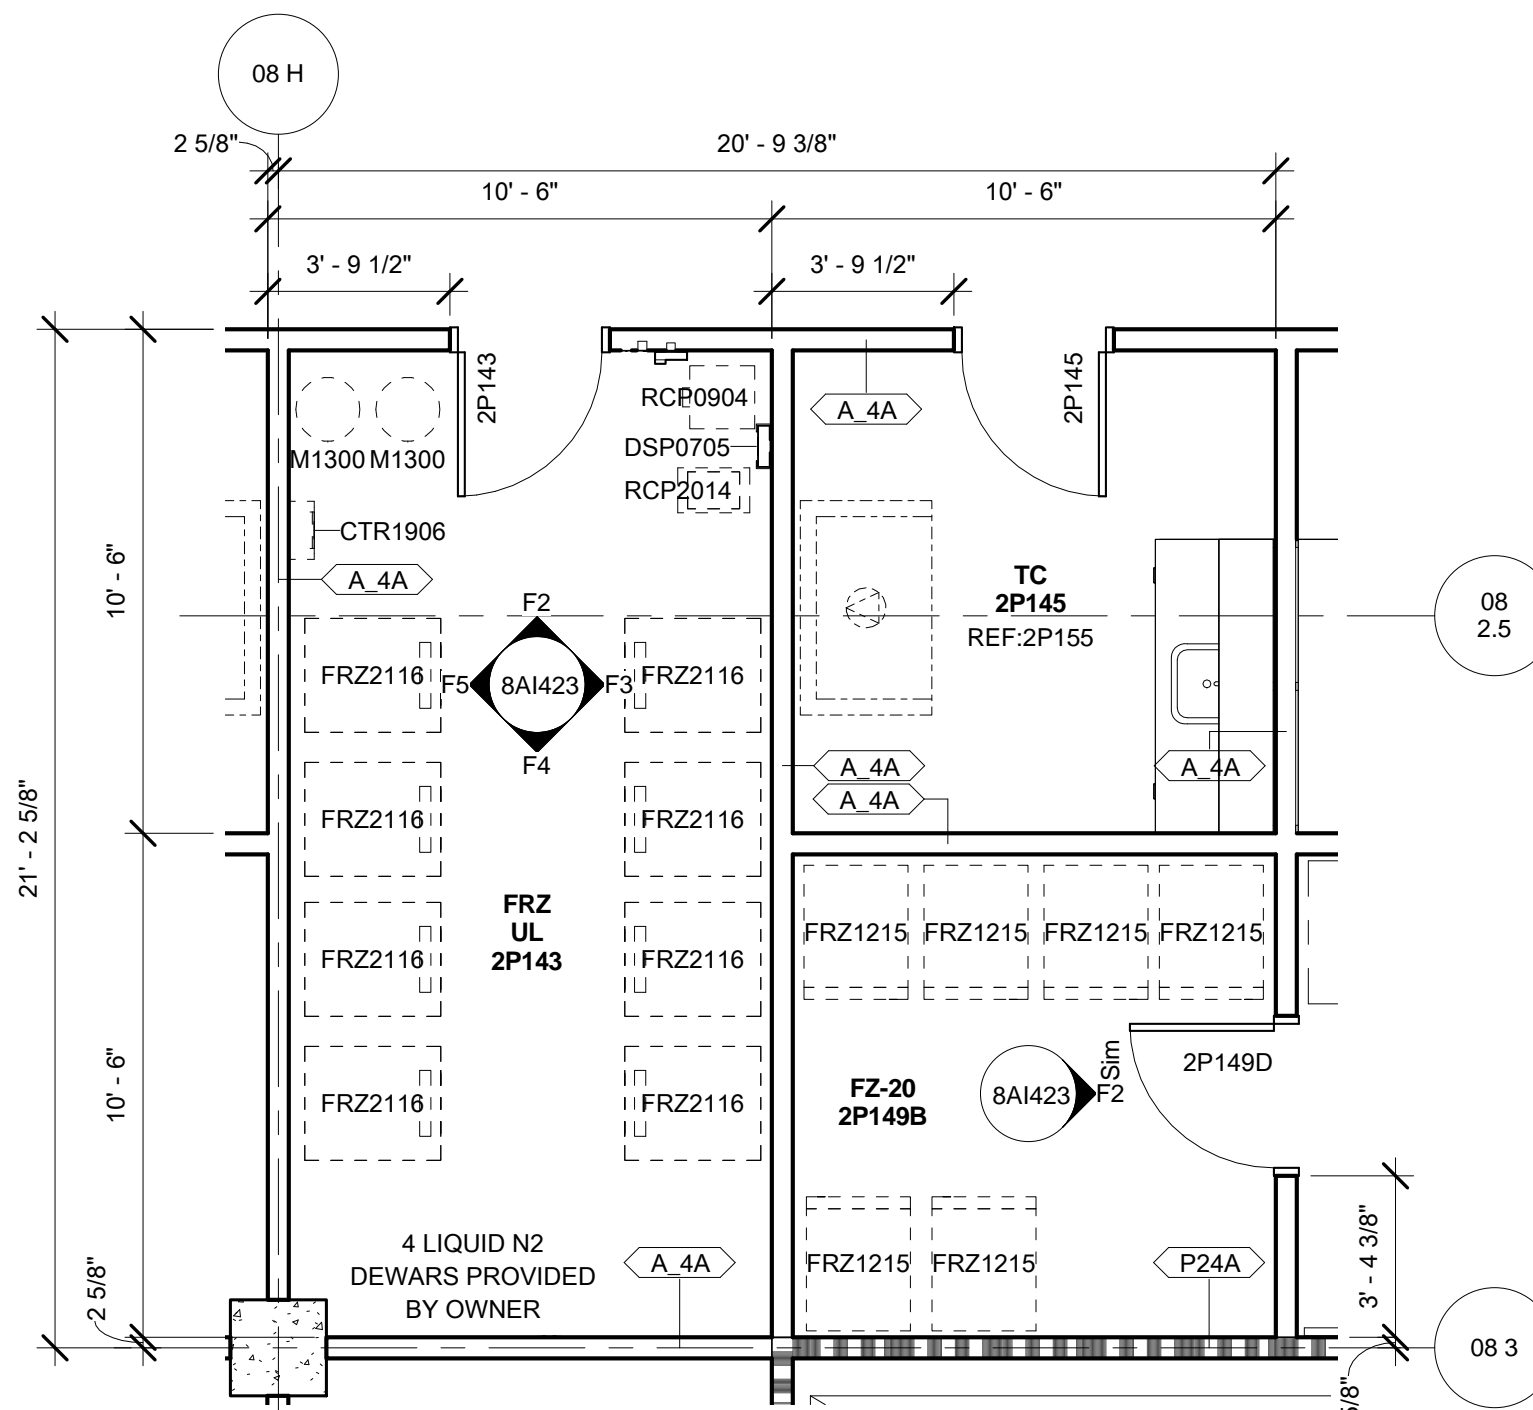


F6 2P143 FREEZER UL/2P149B FZ-20
1/4" = 1'-0"

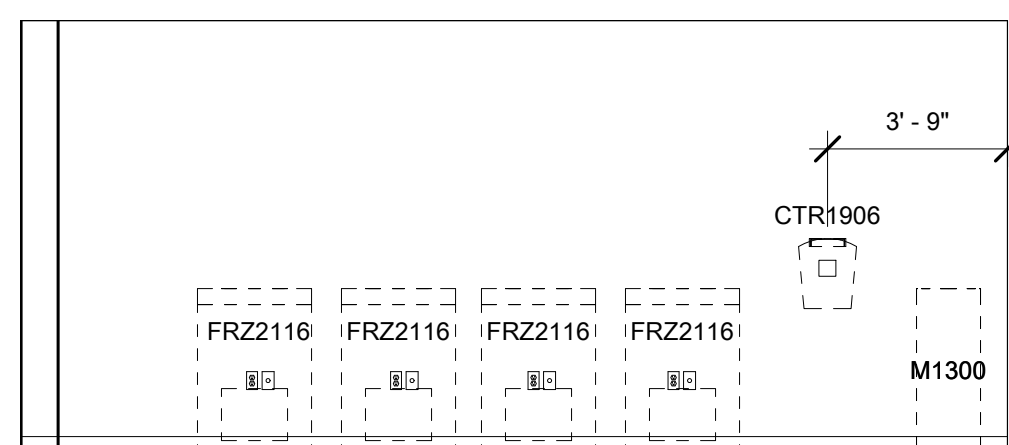


F5 2P143 FRZ UL - W
1/4" = 1'-0"

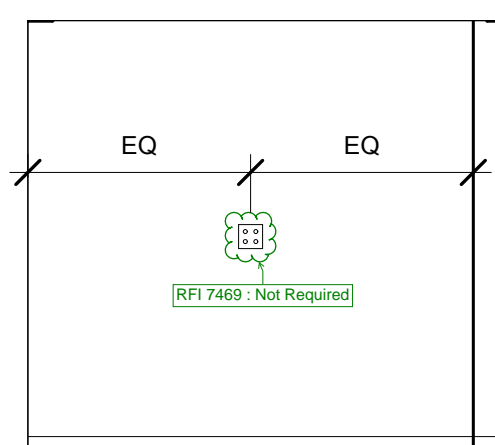

F4 2P143 FRZ UL - S
1/4" = 1'-0"

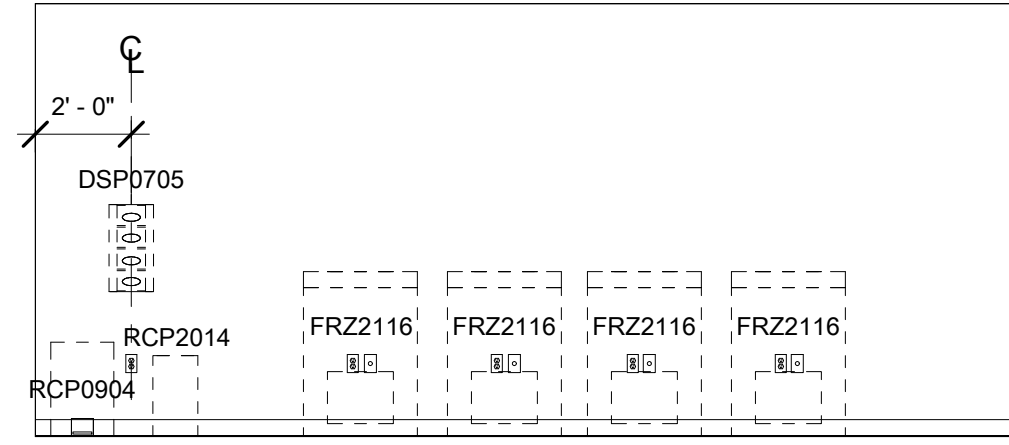

F3 2P143 FRZ UL - E
1/4" = 1'-0"

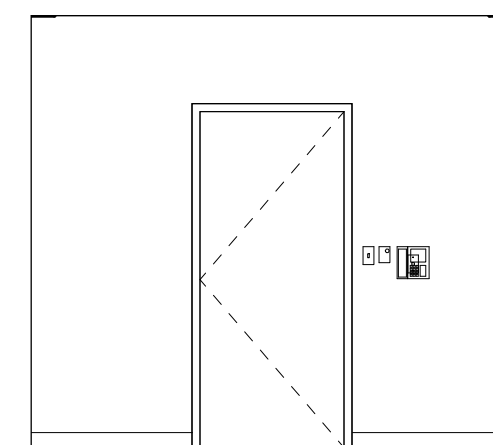

F2 2P143 FRZ UL - N
1/4" = 1'-0"

CONSULTANTS:

DESMAN ASSOCIATES / PARKING
CODE CONSULTANTS, INC. / CODE CONSULTANT
THE SEXTANT GROUP / AV & ACOUSTICAL
HAMMER DESIGN ASSOCIATES / FOOD SERVICE
PYBURN & ODOM / ABATEMENT
TATA & HOWARD / TANK CONSULTANT
I.S.C. GROUP, INC. / IRRIGATION
DAN EUSER WATER ARCHITECTURE, INC. / WATER FEATURE

ARCHITECT/ENGINEERS:

studio **NOVA**
SCHRENK & PETERSON CONSULTING ENGINEERS / CIVIL
KORDA/NEMETH ENGINEERING / STRUCTURAL
BR+A CONSULTING ENGINEERS / MECH. ELECT, PLUMBING, LOW VOLTAGE
ARCHITECTURAL ENGINEERING / PLUMBING
SCALES ASSOCIATES / FIRE PROTECTION

DRAWING TITLE
BLDG 8 LEVEL 2 ENLARGED VIEWS

APPROVED: PROJECT DIRECTOR

Yadda Jandara

PROJECT TITLE
SLVHCS REPLACEMENT MEDICAL
CENTER PROJECT

LOCATION
NEW ORLEANS, LOUISIANA

DATE
July 16, 2012

CHECKED
SG

DRAWN
JD/SG

PROJECT NUMBER
100342.00
BUILDING NUMBER
08
DOCUMENT SET PACKAGE
WP_09B

DRAWING NUMBER

8A1423

CONSTRUCTION DOCUMENTS 1
FULLY SPRINKLERED

OFFICE OF
CONSTRUCTION
AND FACILITIES
MANAGEMENT

Department of
Veterans Affairs