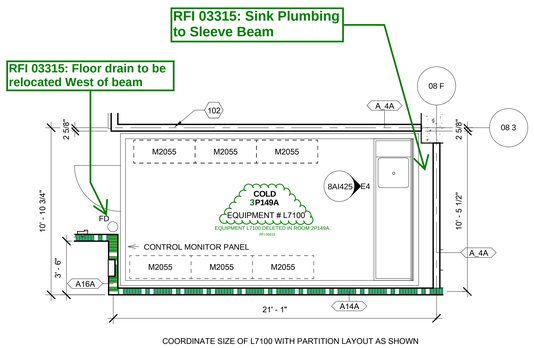

COORDINATE SIZE OF L7100 WITH PARTITION LAYOUT AS SHOWN

B6 2P149A COLD
1/4" = 1'-0"

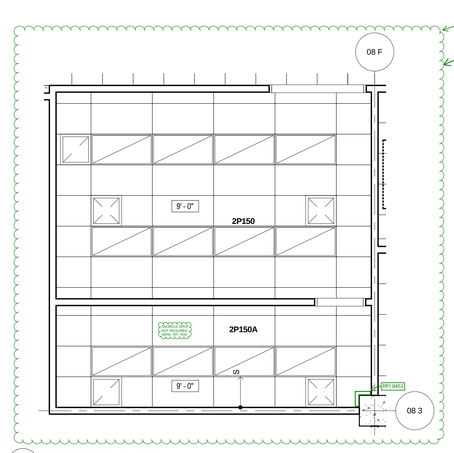

B5 2P150 ELEC MIC - RCP
1/4" = 1'-0"

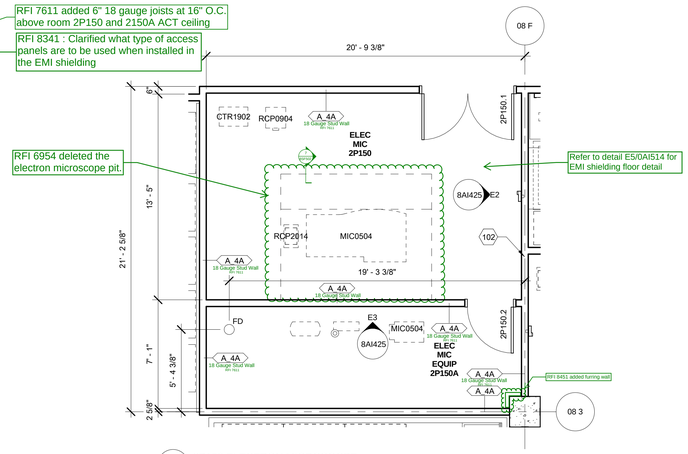

B3 2P150 ELECTRON MICROSOCPE
1/4" = 1'-0"

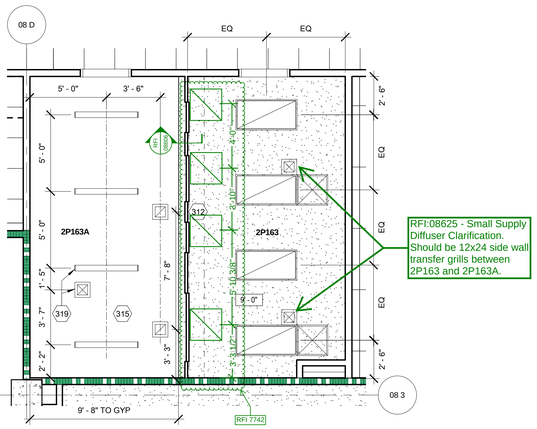

RFI:08625 - Small Supply Diffuser Clarification. Should be 12x24 side wall transfer grills between 2P163 and 2P163A.

D5 2P163A EQUIP RM/2P163 GLASS WASH - RCP
1/4" = 1'-0"

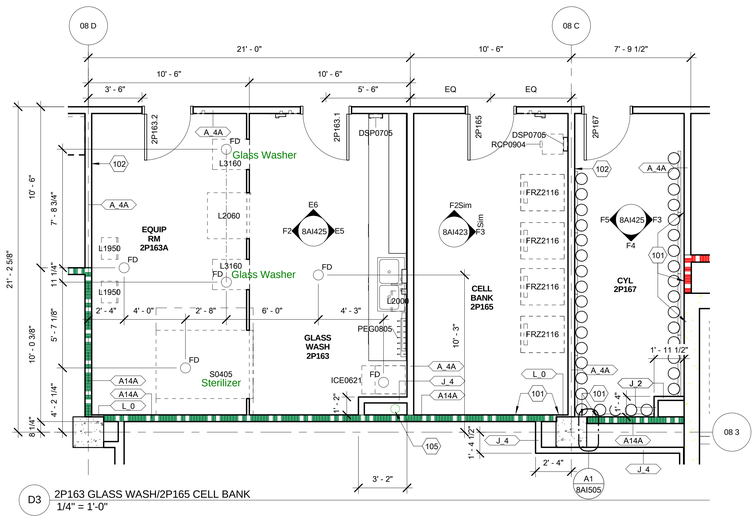

D3 2P163 GLASS WASH/2P165 CELL BANK
1/4" = 1'-0"

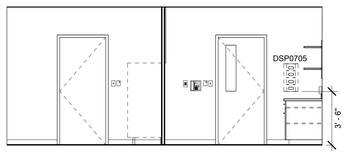

E6 2P163 GLASS WASH - N
1/4" = 1'-0"

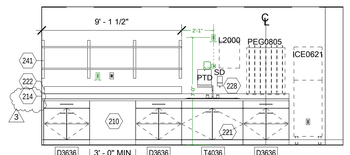

E5 2P163 GLASS WASH - E
1/4" = 1'-0"

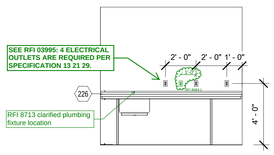

E4 3P149A COLD - E
1/4" = 1'-0"

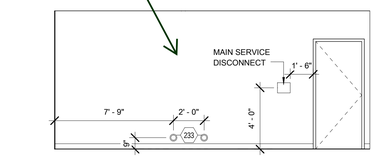

E3 2P150A ELEC MIC EQUIPMENT - N
1/4" = 1'-0"

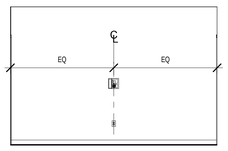

E2 2P150 ELECTRON MIC - E
1/4" = 1'-0"

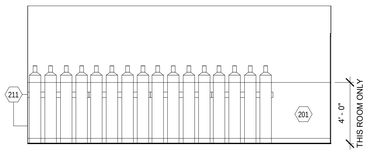

F5 2P167 CYL - W
1/4" = 1'-0"

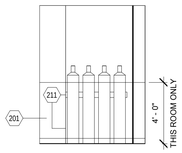

F4 2P167 CYL - S
1/4" = 1'-0"

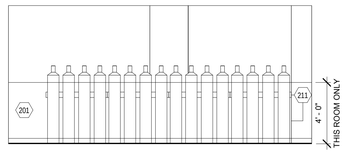

F3 2P167 CYL - E
1/4" = 1'-0"

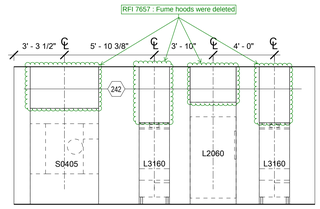

F2 2P163 GLASS WASH - W
1/4" = 1'-0"

LEVEL - 02 AREA - P

REFERENCE SHEET 8AI002 FOR PARTITION TYPE SCHEDULE
REFERENCE SHEET 8AI400 FOR INTERIOR ELEVATION GENERAL NOTES AND CODED NOTES
REFERENCE SHEET 8AI400 FOR RCP GENERAL NOTES AND CODED NOTES
REFERENCE SHEET 8AI200 FOR TYPICAL MOUNTING HEIGHTS
REFERENCE SHEET 8AI201 FOR GRAPHIC LEGEND OF WALL DEVICES

CONSTRUCTION DOCUMENTS 1
FULLY SPRINKLERED

3	Addendum #3 - Post-Bid	7/3/2013
REVISIONS:		DATE

CONSULTANTS:

DESMAN ASSOCIATES / PARKING
CODE CONSULTANTS, INC. / CODE CONSULTANT
THE SEXTANT GROUP / AV & ACOUSTICAL
HAMMER DESIGN ASSOCIATES / FOOD SERVICE
PYBURN & ODOM / ABATEMENT
TATA & HOWARD / TANK CONSULTANT
I.S.C. GROUP, INC. / IRRIGATION
DAN EUSER WATER ARCHITECTURE, INC. / WATER FEATURE

RALPH D. PARRIS No.6531 STATE OF LOUISIANA LICENSED ARCHITECT

ARCHITECT/ENGINEERS:

studioNOVA
SCHRENK & PETERSON CONSULTING ENGINEERS / CIVIL
KORDA/NEMETH ENGINEERING / STRUCTURAL
BR+A CONSULTING ENGINEERS / MECH, ELECT, PLUMBING, LOW VOLTAGE
ARCHITECTURAL ENGINEERING / PLUMBING
SCALES ASSOCIATES / FIRE PROTECTION

DRAWING TITLE	BLDG 8 LEVEL 2 ENLARGED VIEWS
APPROVED: PROJECT DIRECTOR	
PROJECT TITLE	SLVHCS REPLACEMENT MEDICAL CENTER PROJECT
LOCATION	NEW ORLEANS, LOUISIANA
DATE	July 16, 2012
CHECKED	SG
DRAWN	JD/SG
PROJECT NUMBER	100342.00
BUILDING NUMBER	08
DOCUMENT SET PACKAGE	WP_09B
DRAWING NUMBER	8AI425

OFFICE OF CONSTRUCTION AND FACILITIES MANAGEMENT
Department of Veterans Affairs

VA FORM 08-6231