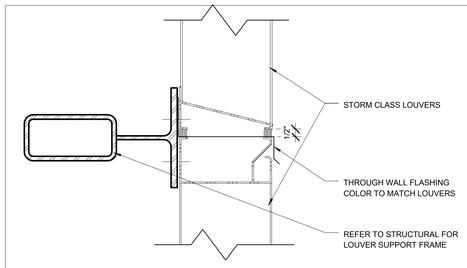

A6 LOUVER HEAD TO SILL CX
SCALE: 3" = 1'-0"

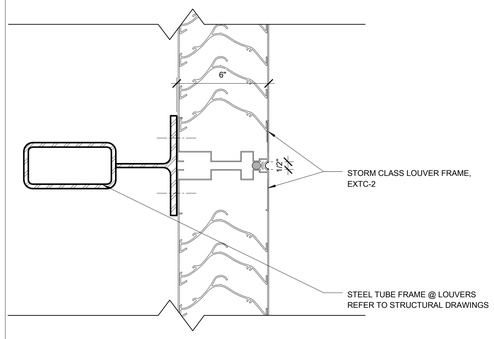

C6 LOUVER TO LOUVER CX
SCALE: 3" = 1'-0"

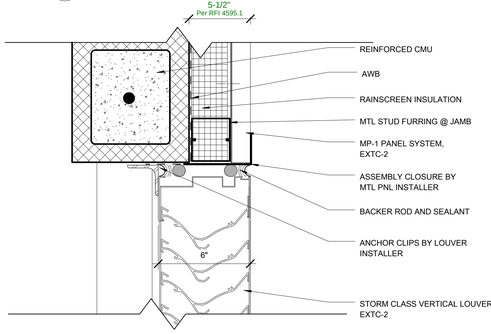

E6 LOUVER JAMB @ MP-1
SCALE: 3" = 1'-0"

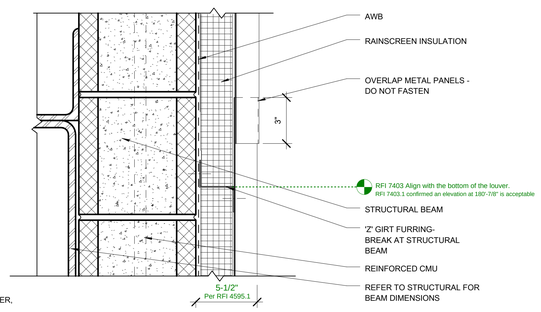

E5 MP-1 PANEL SPLICE @ STRUCTURAL BEAM
SCALE: 3" = 1'-0" RFI 7403 : Splice is not required at the south elevation, 8AS203.

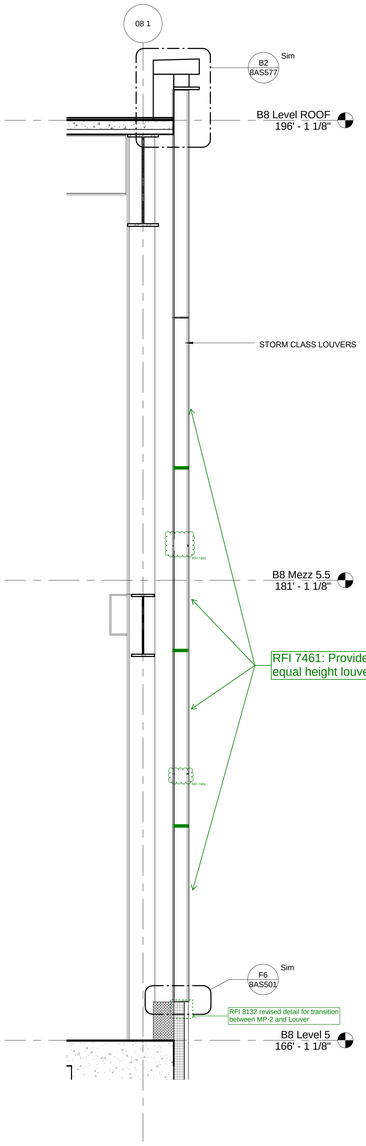

E4 MP-1 Section @ Louver
SCALE: 1/2" = 1'-0"

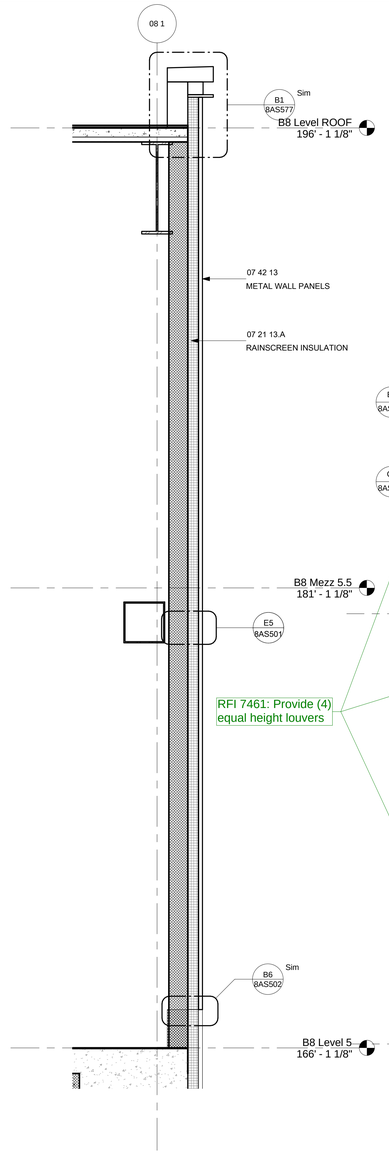

E3 MP-1 Partial Wall Section
SCALE: 1/2" = 1'-0"

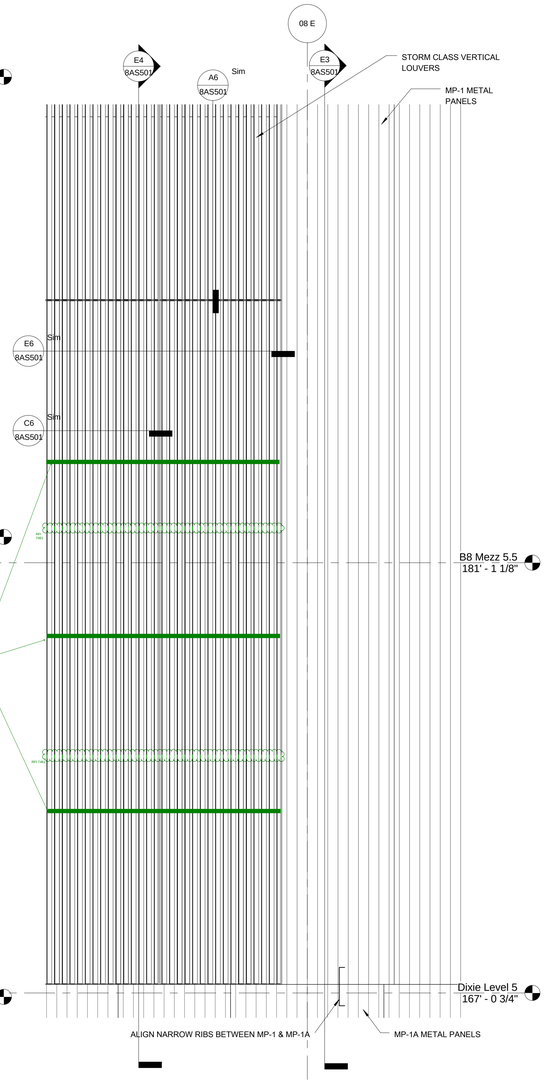

E2 Typical MP-1 Enlarged Elevation
SCALE: 1/2" = 1'-0"

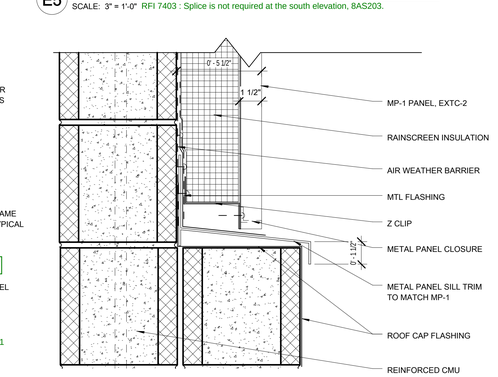

F5 MP-1 SILL @ GRID 08 4
SCALE: 3" = 1'-0"

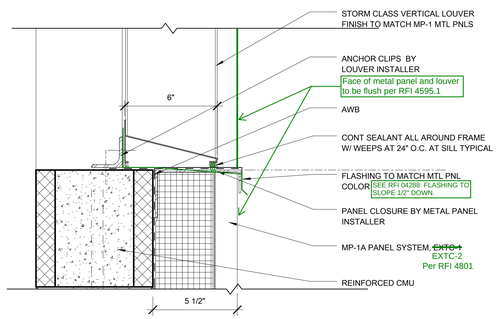

F6 TYPICAL LOUVER SILL
SCALE: 3" = 1'-0"

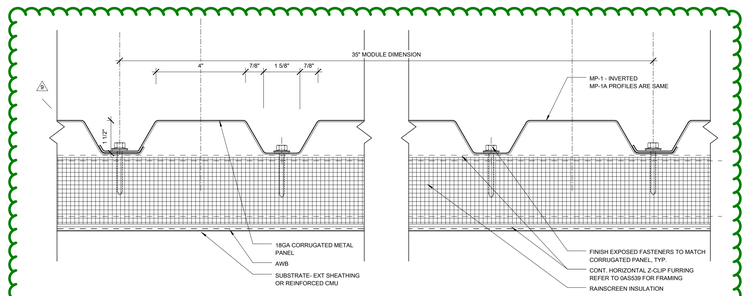

F3 TYP. MP-1, MP-1A PROFILE
SCALE: 6" = 1'-0"

Revised Detail Per RFI 4595.1

NOTE: REFER TO SHEET 8AS500 FOR AIR WEATHER BARRIER TRANSITION DETAILS.

CONSTRUCTION DOCUMENTS 1
FULLY SPRINKLERED

REVISIONS: | DATE

CONSULTANTS:
DESMAN ASSOCIATES / PARKING
CODE CONSULTANTS, INC. / CODE CONSULTANT
THE SEXTANT GROUP / AV & ACOUSTICAL
HAMMER DESIGN ASSOCIATES / FOOD SERVICE
PYBURN & ODOM / ABATEMENT
TATA & HOWARD / TANK CONSULTANT
I.S.C. GROUP, INC. / IRRIGATION
DAN EUSER WATER ARCHITECTURE, INC. / WATER FEATURE

RALPH D. PARRIS No. 6527 STATE OF LOUISIANA LICENSED ARCHITECT

ARCHITECT/ENGINEERS:
studio NOVA
SCHRENK & PETERSON CONSULTING ENGINEERS / CIVIL
KORDA/NEMETH ENGINEERING / STRUCTURAL
BR+A CONSULTING ENGINEERS / MECH, ELECT, PLUMBING, LOW VOLTAGE
ARCHITECTURAL ENGINEERING / PLUMBING
SCALES ASSOCIATES / FIRE PROTECTION

DRAWING TITLE: BLDG 8 WALL TYPE MP-1
PROJECT TITLE: SLVHCS REPLACEMENT MEDICAL CENTER PROJECT
PROJECT NUMBER: 100342.00
BUILDING NUMBER: 8
DOCUMENT SET PACKAGE: WP_09B
APPROVED: PROJECT DIRECTOR: Judd Sanders
LOCATION: NEW ORLEANS, LOUISIANA
DATE: July 16, 2012
CHECKED: JR
DRAWN: CN
DRAWING NUMBER: 8AS501

OFFICE OF CONSTRUCTION AND FACILITIES MANAGEMENT
Department of Veterans Affairs

VA FORM 08-6231