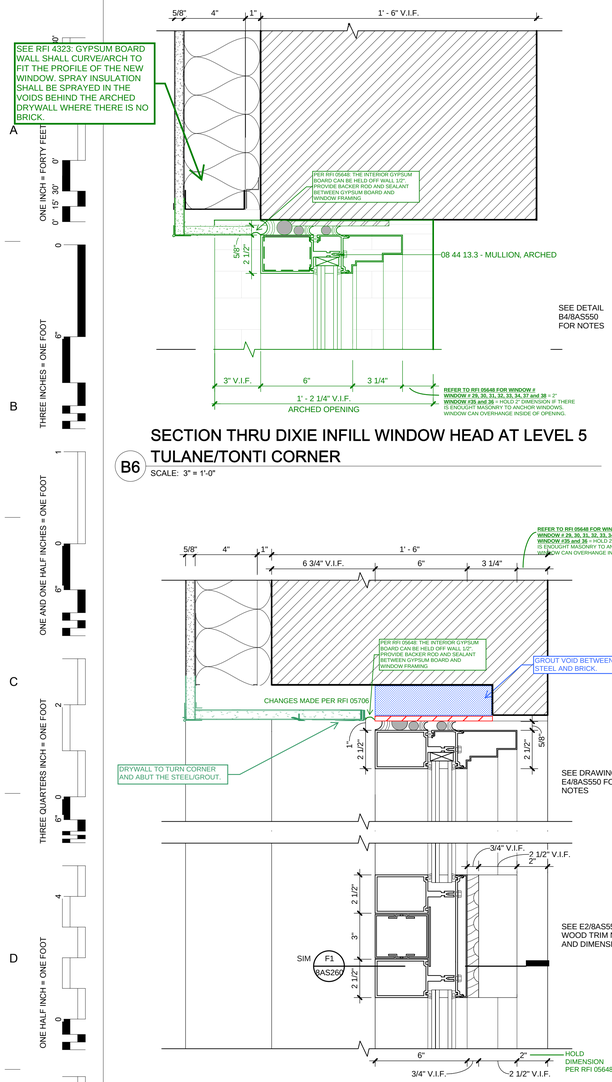

SECTION THRU DIXIE INFILL WINDOW HEAD AT LEVEL 5 TULANE/TONTI CORNER

B6 SCALE: 3" = 1'-0"

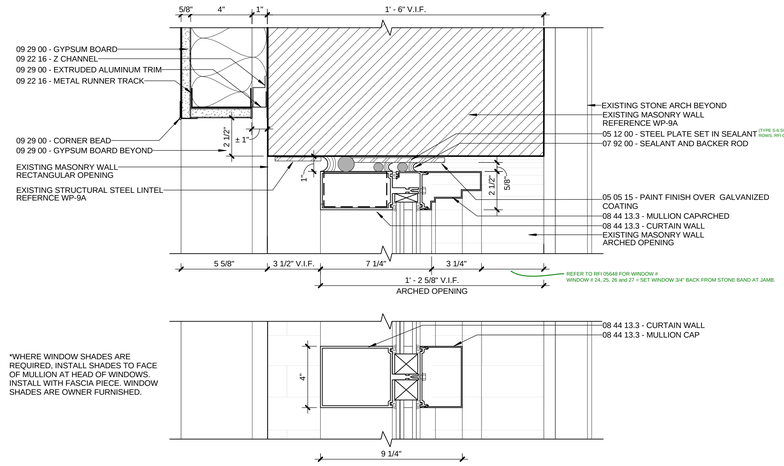

SECTION THRU DIXIE INFILL WINDOW HEAD AT LEVEL 4 TULANE/TONTI CORNER

B4 SCALE: 3" = 1'-0"

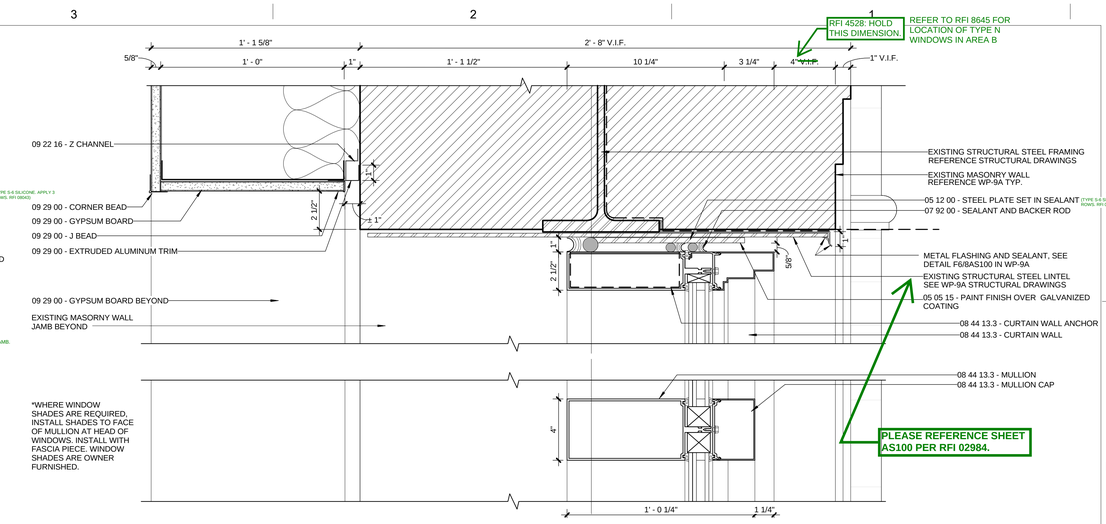

SECTION THRU DIXIE INFILL WINDOW HEAD AT LEVEL 1 TULANE/TONTI CORNER

B2 SCALE: 3" = 1'-0"

SECTION THRU DIXIE INFILL WINDOW JAMB AT LEVEL 5 TULANE/TONTI CORNER

E6 SCALE: 3" = 1'-0"

SECTION THRU DIXIE INFILL WINDOW JAMB AT LEVEL 4 TULANE/TONTI CORNER

E4 SCALE: 3" = 1'-0"

SECTION THRU DIXIE INFILL WINDOW JAMB AT LEVEL 1 TULANE/TONTI CORNER

E2 SCALE: 3" = 1'-0"

SECTION THRU DIXIE INFILL WINDOW SILL AT LEVEL 5 TULANE/TONTI CORNER

F6 SCALE: 3" = 1'-0"

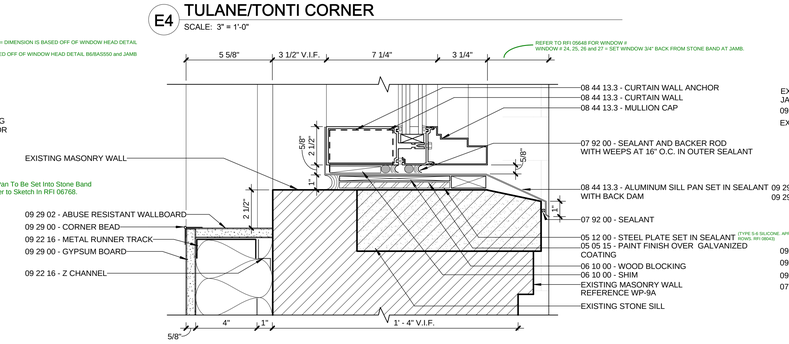

SECTION THRU DIXIE INFILL WINDOW SILL AT LEVEL 4 TULANE/TONTI CORNER

F4 SCALE: 3" = 1'-0"

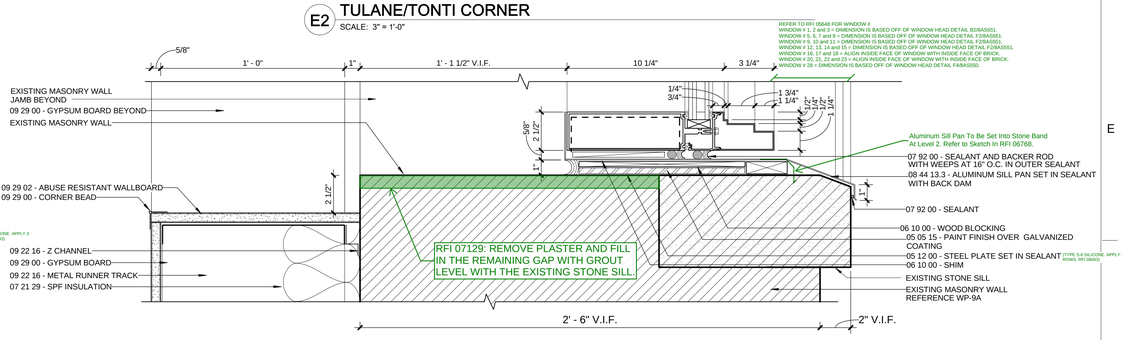

SECTION THRU DIXIE INFILL WINDOW SILL AT LEVEL 1 TULANE/TONTI CORNER

F2 SCALE: 3" = 1'-0"

CONSTRUCTION DOCUMENTS 1
FULLY SPRINKLERED

REVISIONS:	DATE

CONSULTANTS:

DESMAN ASSOCIATES / PARKING
CODE CONSULTANTS, INC / CODE CONSULTANT
THE SEXTANT GROUP / AV & ACOUSTICAL
HAMMER DESIGN ASSOCIATES / FOOD SERVICE
PYBURN & ODOM / ABATEMENT
TATA & HOWARD / TANK CONSULTANT
I.S.C. GROUP, INC / IRRIGATION
DAN EUSER WATER ARCHITECTURE, INC / WATER FEATURE

MARK J. RIPPLE
REG. NO. 3454
REGISTERED ARCHITECT

ARCHITECT/ENGINEERS:

studio NOVA

SCHRENK & PETERSON CONSULTING ENGINEERS / CIVIL
KORDA/NEMETH ENGINEERING / STRUCTURAL
BR+A CONSULTING ENGINEERS / MECH & ELEC
ARCHITECTURAL ENGINEERING / PLUMBING
SCALES ASSOCIATES / FIRE PROTECTION
COMMUNICATIONS DESIGN GROUP / LOW VOLTAGE

DRAWING TITLE	BLDG 8 EXTERIOR WALL DETAILS
APPROVED: PROJECT DIRECTOR	Todd Sanders
PROJECT TITLE	SLVHCS REPLACEMENT MEDICAL CENTER PROJECT
LOCATION	NEW ORLEANS, LOUISIANA
DATE	July 16, 2012
CHECKED	CD
DRAWN	DD
PROJECT NUMBER	629-HS2-401
BUILDING NUMBER	8
DOCUMENT SET PACKAGE	WP_9B
DRAWING NUMBER	8AS550

OFFICE OF CONSTRUCTION AND FACILITIES MANAGEMENT

Department of Veterans Affairs

VA FORM 08-6231