

ONE INCH = FORTY FEET (1" = 40')

THREE INCHES = ONE FOOT

ONE AND ONE HALF INCHES = ONE FOOT


THREE QUARTERS INCH = ONE FOOT

ONE HALF INCH = ONE FOOT


ONE QUARTER INCH = ONE FOOT

ONE EIGHT INCH = ONE FOOT


ONE SIXTEENTH INCH = ONE FOOT

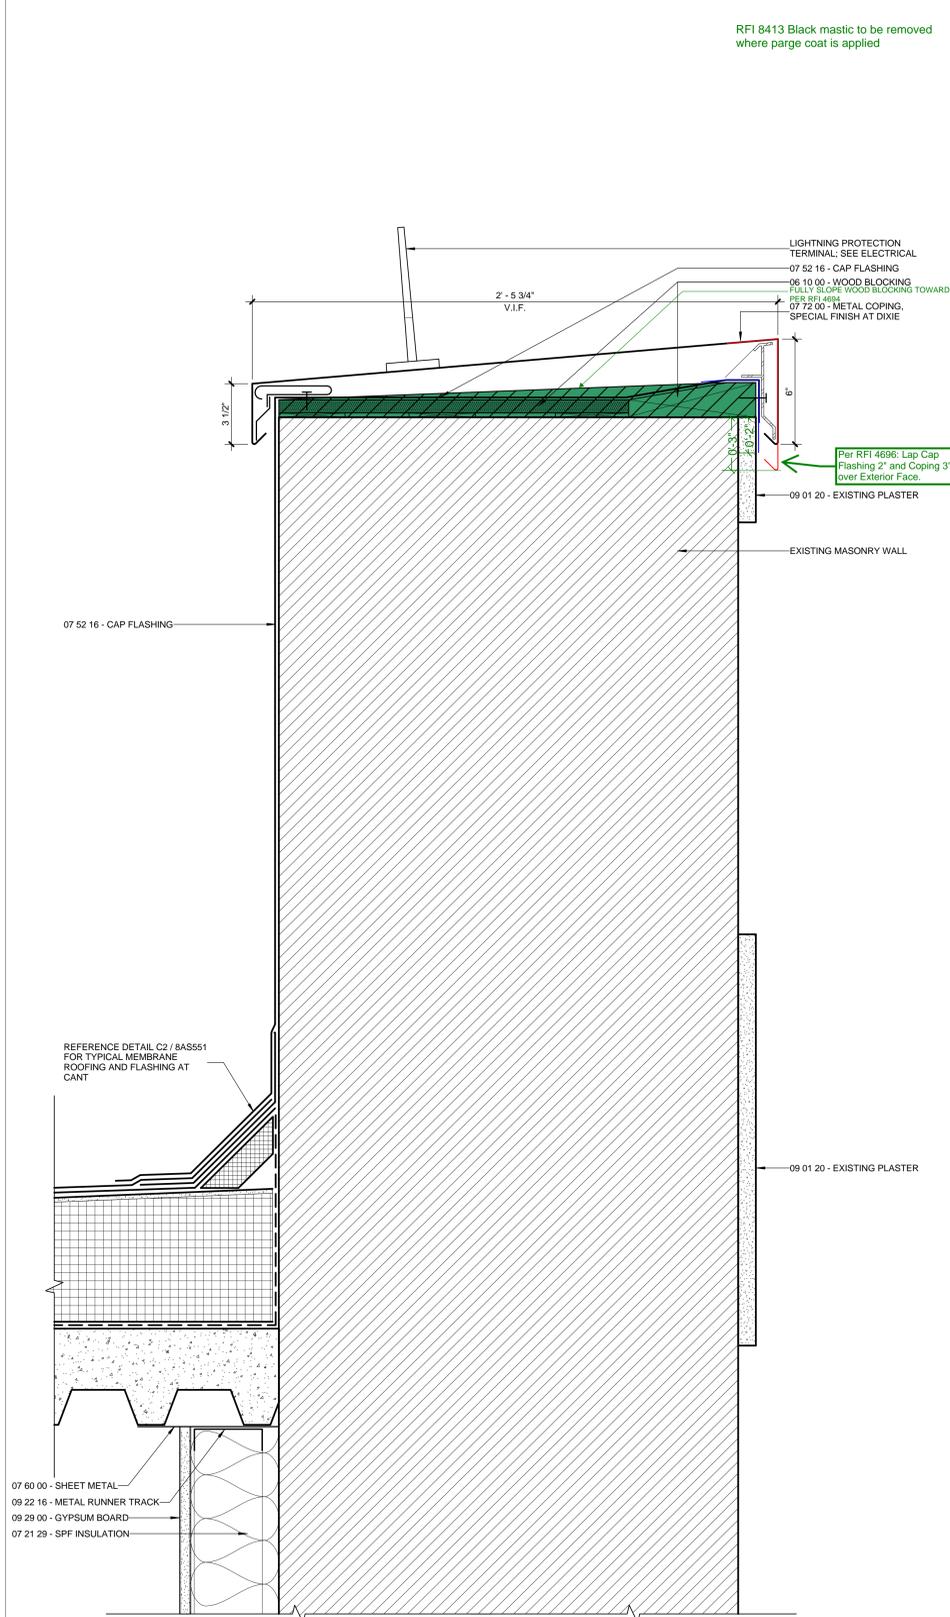


F6 SECTION THRU DIXIE TULANE WALL AT MASONRY PARAPET
SCALE: 3" = 1'-0"

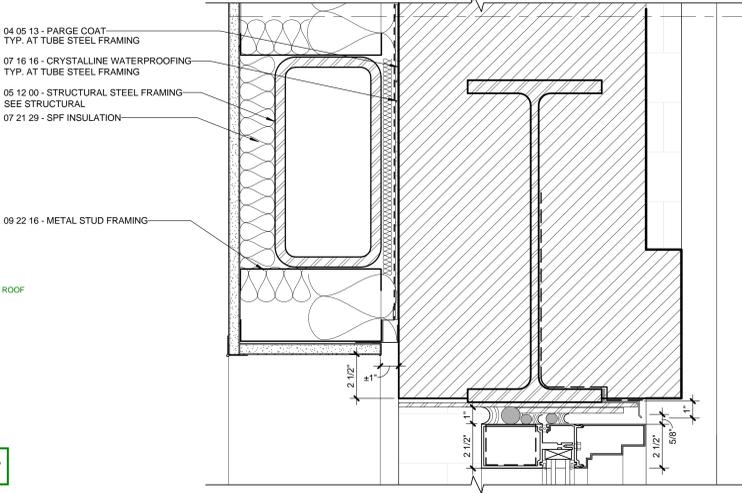


B4 SECTION THRU MASONRY WALL AT TUBE STEEL STRUCTURE (TYP.) INCLUDING BLAST PROOFING STEEL RFI 06643
SCALE: 3" = 1'-0"

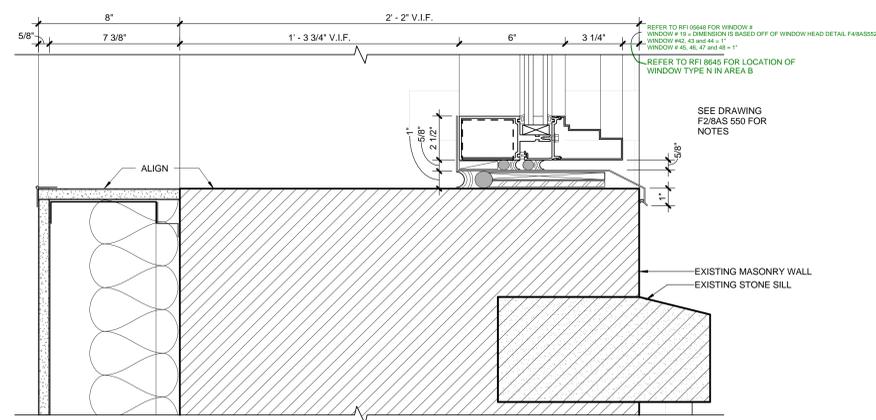


D4 SECTION THRU DIXIE INFILL WINDOW AT BRICK SILL
SCALE: 3" = 1'-0"

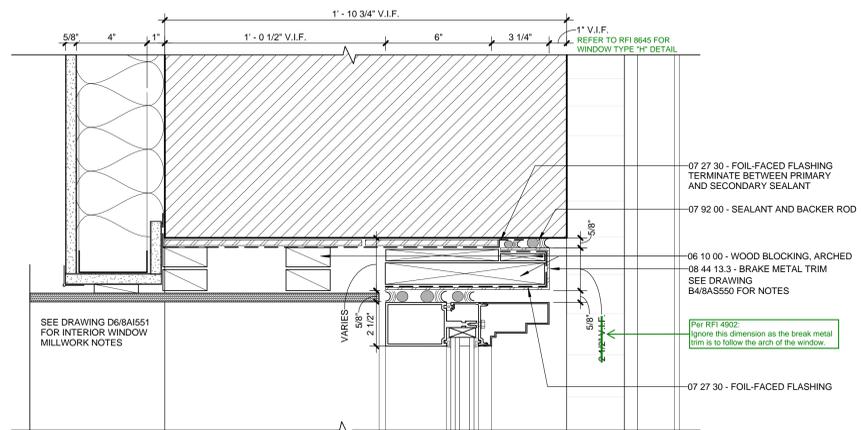


F4 SECTION THRU DIXIE INFILL WINDOW AT ARCHED HEAD CONDITION
SCALE: 3" = 1'-0"

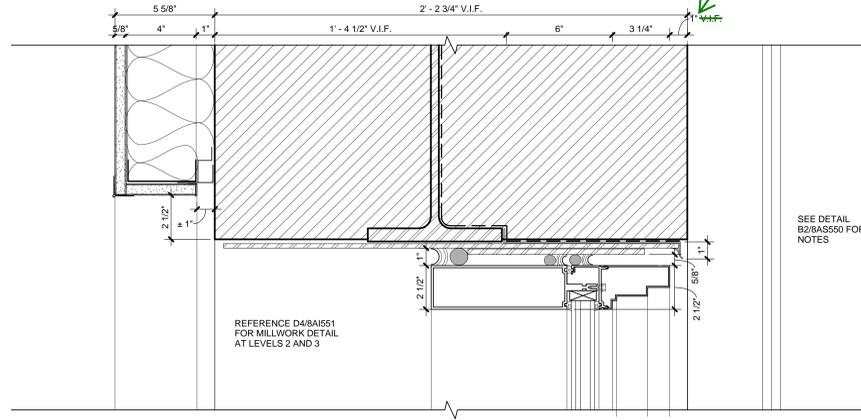

B2 SECTION THRU DIXIE INFILL WINDOW HEAD AT LEVEL 1 TULANE MASONRY WALL
SCALE: 3" = 1'-0"

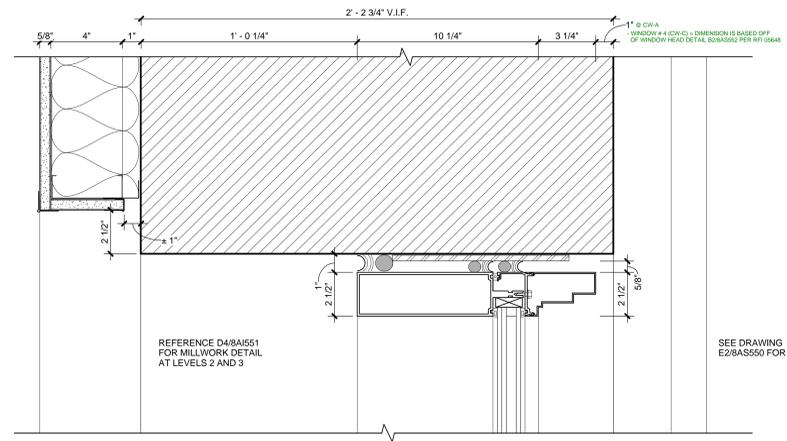

D2 SECTION THRU DIXIE INFILL WINDOW JAMB AT LEVEL 1 TULANE MASONRY WALL
SCALE: 3" = 1'-0"

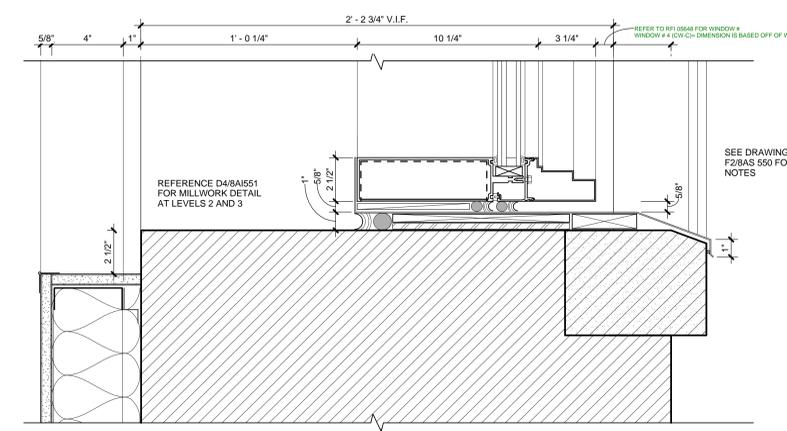

F2 SECTION THRU DIXIE INFILL WINDOW SILL AT LEVEL 1 TULANE MASONRY WALL
SCALE: 3" = 1'-0"

REVISIONS:	DATE	CONSULTANTS:
		DESMAN ASSOCIATES / PARKING
		CODE CONSULTANTS, INC / CODE CONSULTANT
		THE SEXTANT GROUP / AV & ACOUSTICAL
		HAMMER DESIGN ASSOCIATES / FOOD SERVICE
		PYBURN & ODOM / ABATEMENT
		TATA & HOWARD / TANK CONSULTANT
		I.S.C. GROUP, INC / IRRIGATION
		DAN EUSER WATER ARCHITECTURE, INC / WATER FEATURE

ARCHITECT/ENGINEERS:

studio **NOVA**

SCHRENK & PETERSON CONSULTING ENGINEERS / CIVIL
 KORDA/NEMETH ENGINEERING / STRUCTURAL
 BR+A CONSULTING ENGINEERS / MECH & ELEC
 ARCHITECTURAL ENGINEERING / PLUMBING
 SCALES ASSOCIATES / FIRE PROTECTION
 COMMUNICATIONS DESIGN GROUP / LOW VOLTAGE

DRAWING TITLE BLDG 8 EXTERIOR WALL DETAILS	PROJECT TITLE SLV/HCS REPLACEMENT MEDICAL CENTER PROJECT	PROJECT NUMBER 629-HS2-401	BUILDING NUMBER 8
APPROVED: PROJECT DIRECTOR <i>Judd Sanders</i>	LOCATION NEW ORLEANS, LOUISIANA	DOCUMENT SET PACKAGE WP_9B	DRAWING NUMBER 8AS552
DATE July 16, 2012	CHECKED CD	DRAWN DD	OFFICE OF CONSTRUCTION AND FACILITIES MANAGEMENT Department of Veterans Affairs